
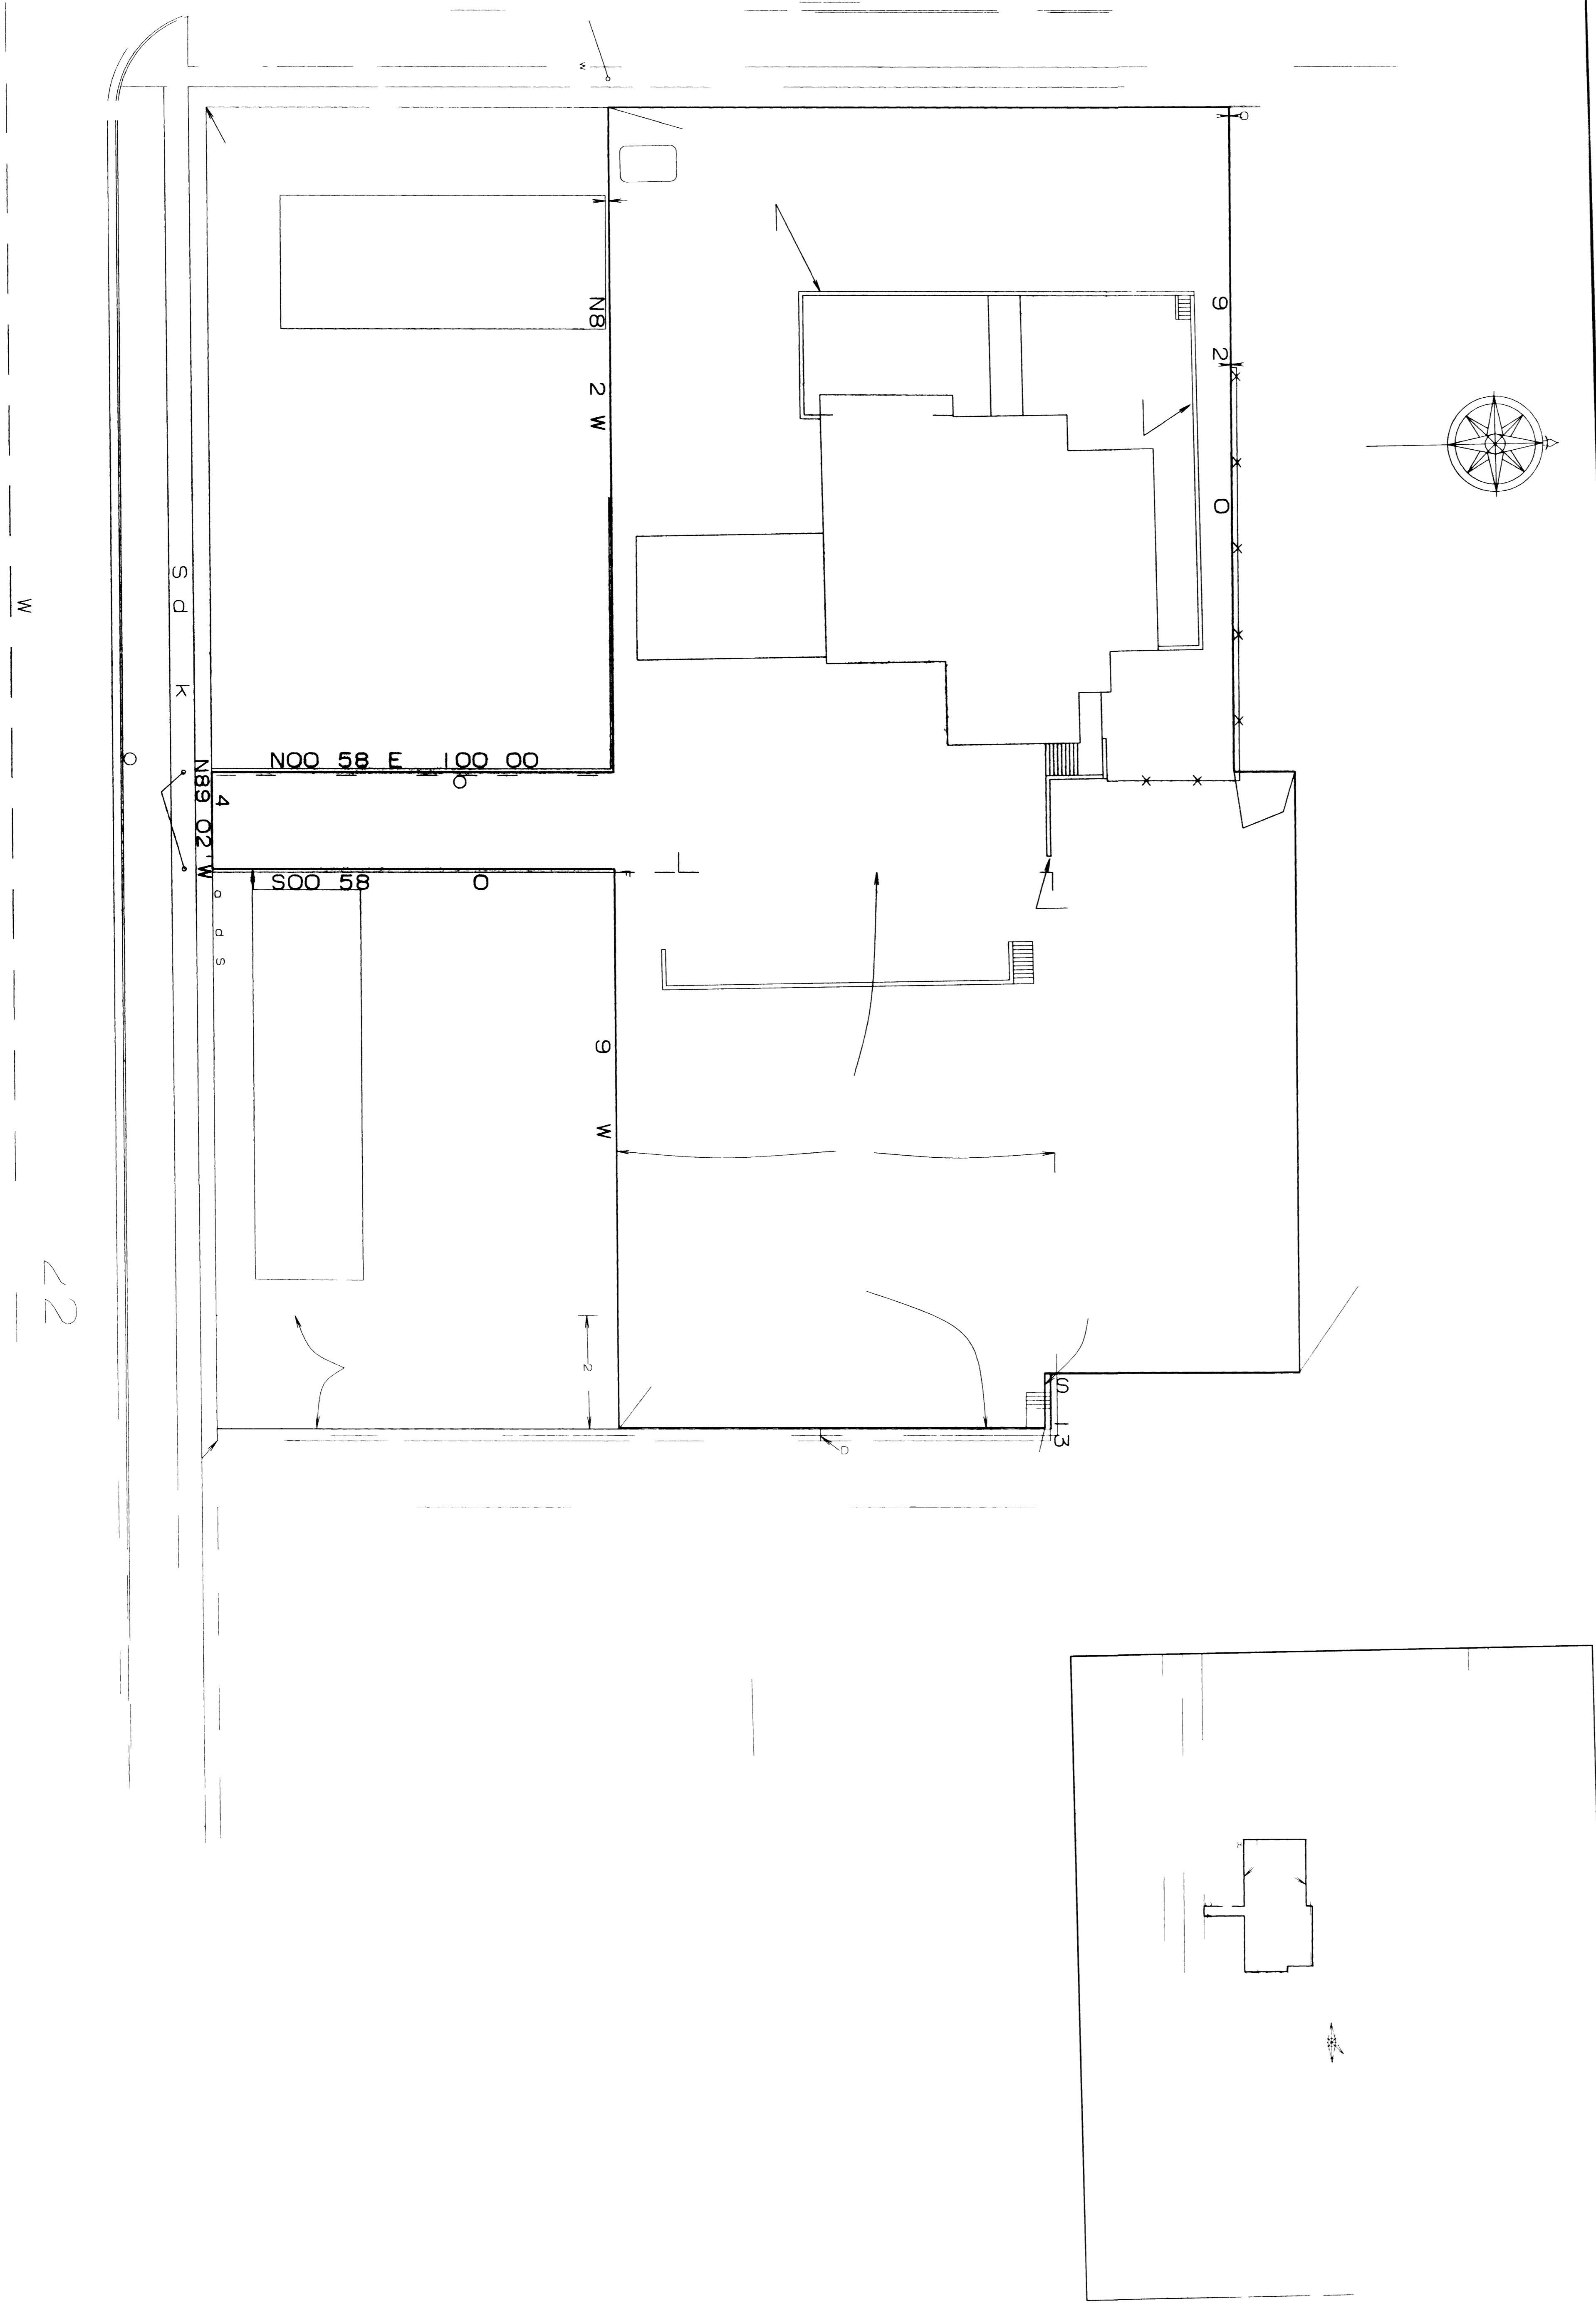


RAW

AWN

DES	W	K	AT	FG
ST				
T A				
+ S				
P TY VEY				
				
00 193				



22

