001952
001952
001952

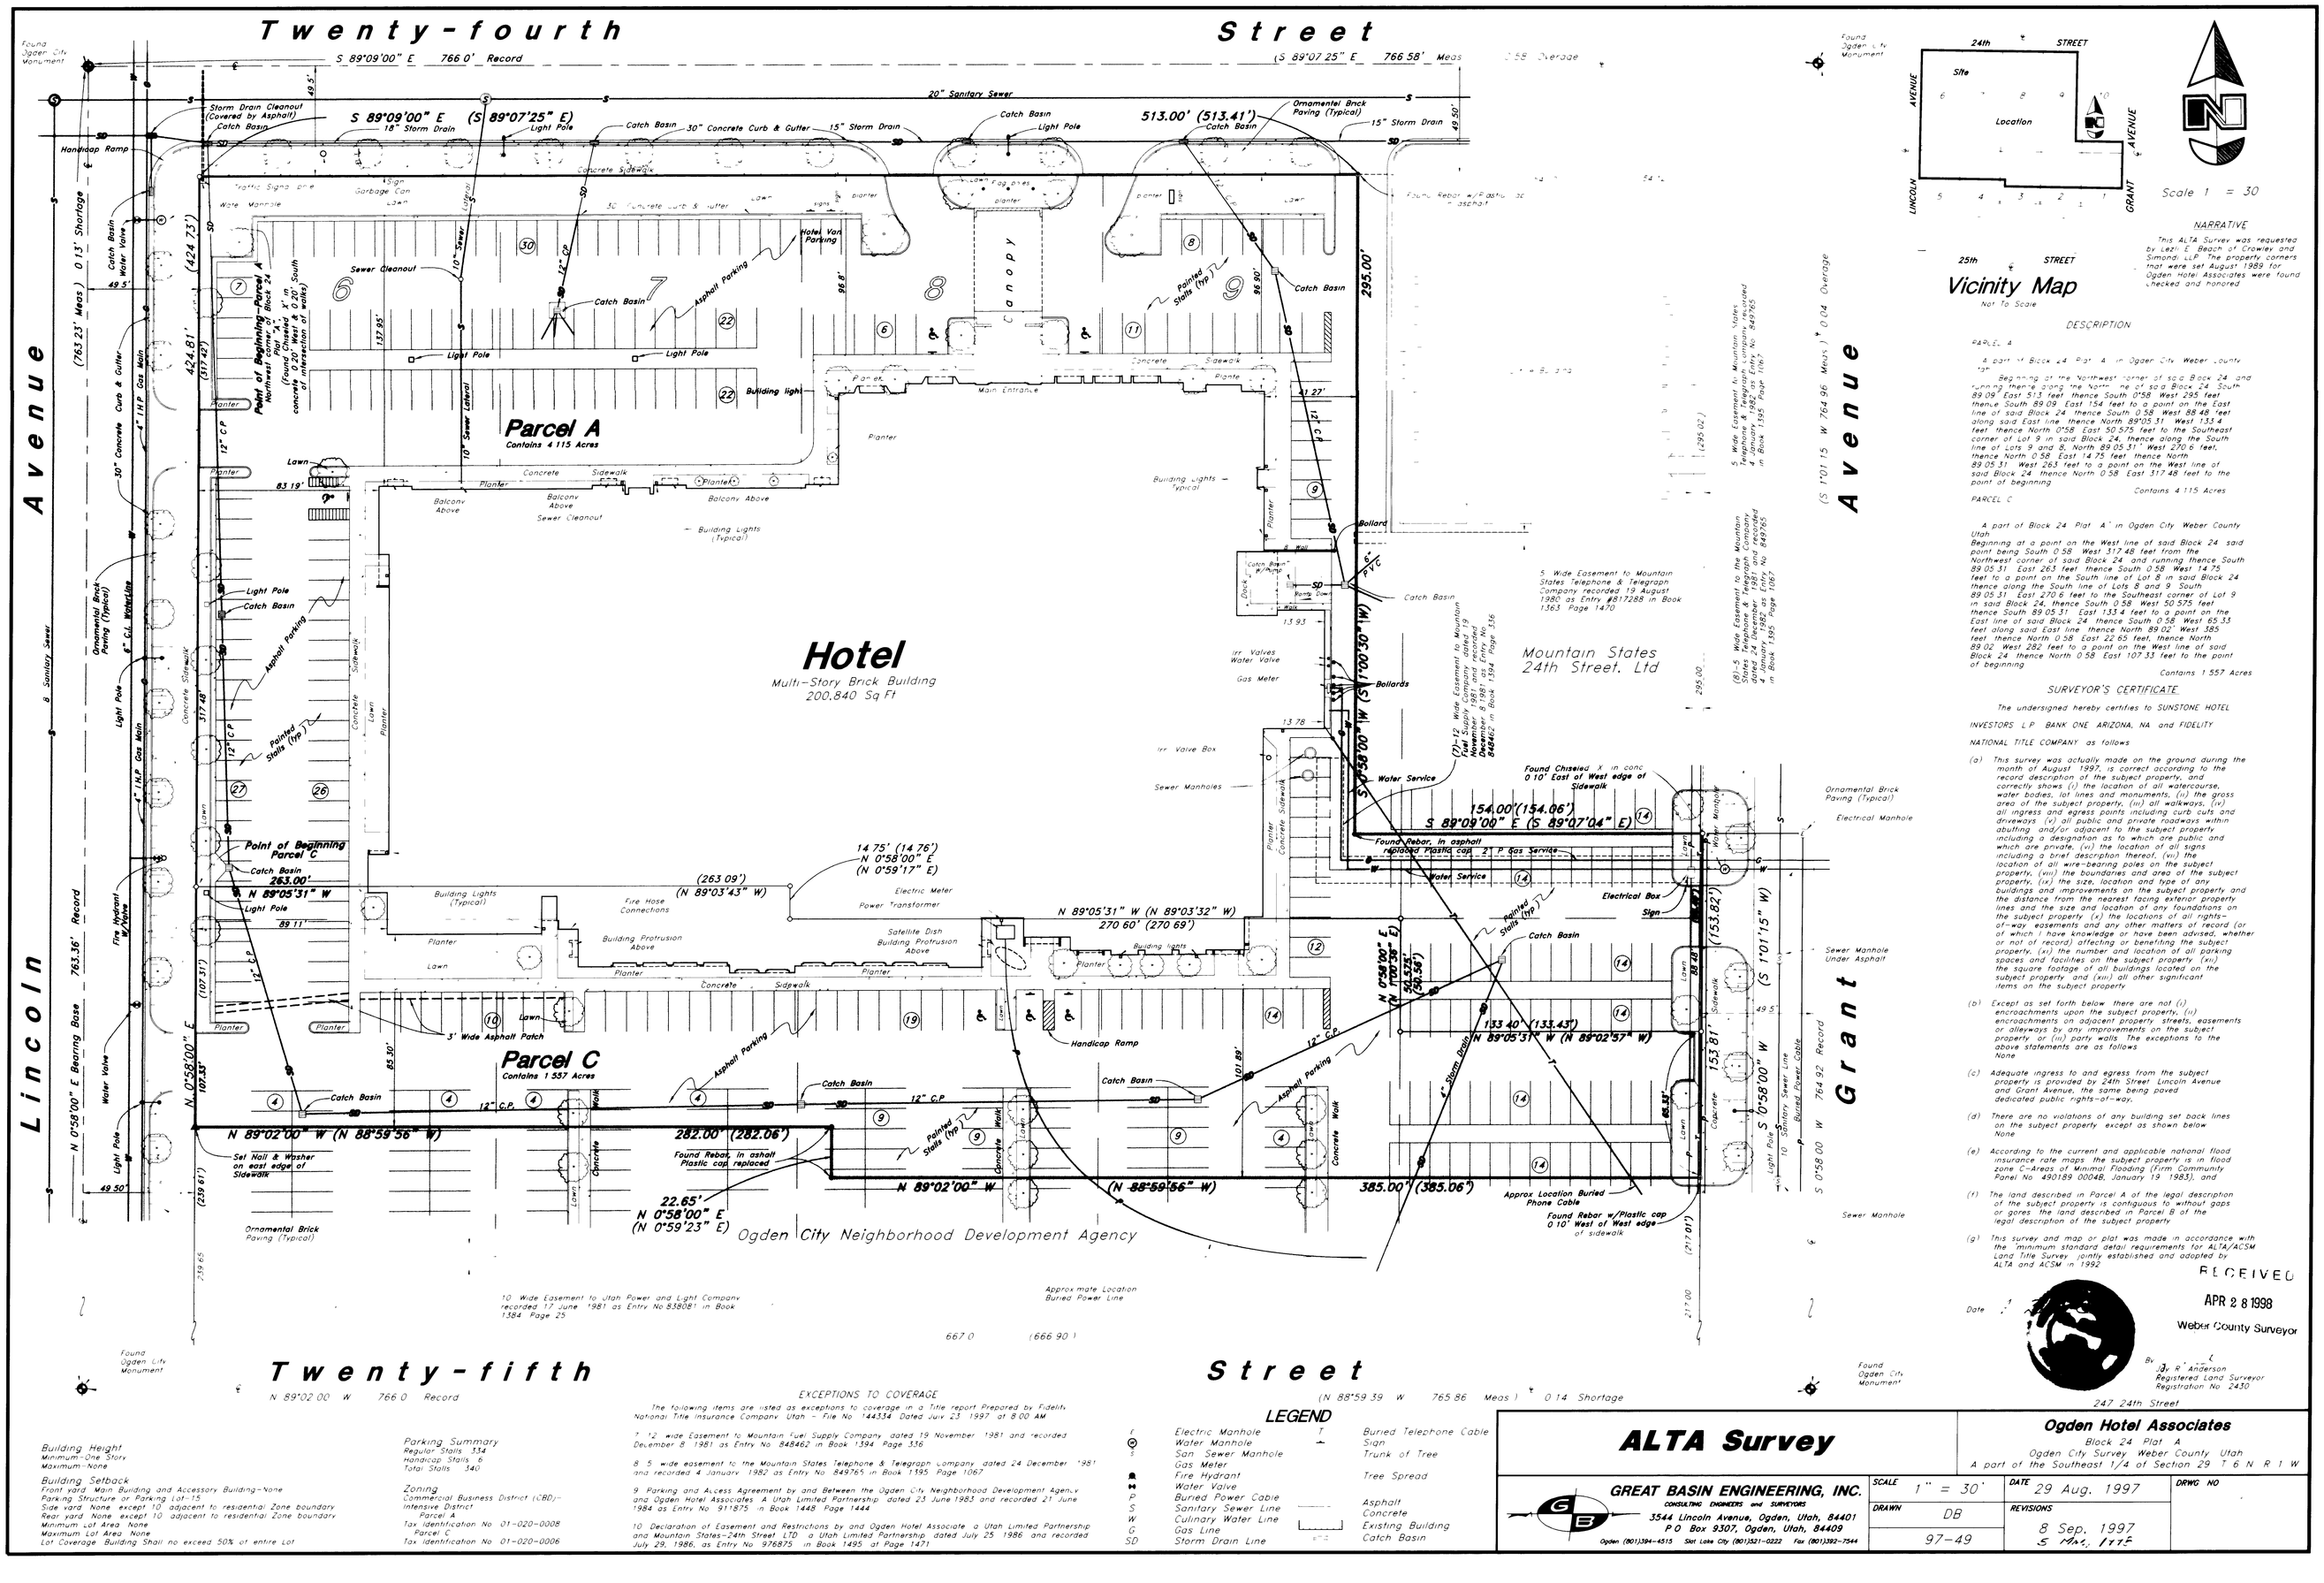
Twenty-fourth Street
S 89°09'00" E 766.0' Record
(S 89°07'25" E 766.58' Meas
0.58' Overage
S 89°09'00" E (S 89°07'25" E)
513.00' (513.41')
20" Sanitary Sewer
18" Storm Drain
30" Concrete Curb & Gutter
15" Storm Drain
Storm Drain Cleanout (Covered by Asphalt)
Catch Basin
Light Pole
Ornamental Brick Paving (Typical)
Handicap Ramp
Lincoln Avenue
Grant Avenue
(763.23' Meas) 0.13' Shortage
Record
Parcel A
Contains 4.115 Acres
Point of Beginning-Parcel A
Northwest corner of Block 24
(Found Chiseled 'X' in concrete 0.20' West & 0.20' South of intersection of walls)
Hotel Van Parking
Asphalt Parking
Painted Stalls (Typ.)
Sewer Cleanout
10" Sewer Lateral
12" C.P.
Building light
Main Entrance
Concrete Sidewalk
Planter
Lawn
Balcony Above
Building Lights (Typical)
Ballard
Canopy
Hotel
Multi-Story Brick Building
200,840 Sq Ft
Mountain States 24th Street, Ltd
Parcel C
Contains 1.557 Acres
Point of Beginning Parcel 'C'
Catch Basin
263.00'
N 89°05'31" W
N 0°58'00" E
Fire Hydrant w/Valve
Water Valve
Light Pole
Asphalt Parking
Handicap Ramp
3' Wide Asphalt Patch
Set Nail & Washer on east edge of Sidewalk
N 89°02'00" W (N 88°59'56" W)
282.00' (282.06')
Found Rebar, in asphalt Plastic cap replaced
22.65'
N 0°58'00" E
(N 0°59'23" E)
N 89°05'31" W (N 89°03'32" W)
270.60' (270.69')
14.75' (14.76')
N 0°58'00" E
(N 0°59'17" E)
(263.09')
(N 89°03'43" W)
Building Protrusion Above
Satellite Dish
Electric Meter
Power Transformer
Fire Hose Connections
Ogden City Neighborhood Development Agency
Twenty-fifth Street
N 89°02'00" W 766.0' Record
(N 88°59'39" W 765.86' Meas) 0.14' Shortage
Found Ogden City Monument
Found Rebar w/Plastic cap 0.10' East of West edge of Sidewalk
154.00'(154.06')
S 89°09'00" E (S 89°07'04" E)
Found Rebar, in asphalt replaced Plastic cap 2" P Gas Service
Water Service
Electrical Box
Sign
Found Chiseled 'X' in conc 0.10' East of West edge of Sidewalk
Ornamental Brick Paving (Typical)
Electrical Manhole
Sewer Manhole Under Asphalt
Sewer Manhole
Buried Power Cable
Approx Location Buried Phone Cable
Found Rebar w/Plastic cap 0.10' West of West edge of sidewalk
Approx mate Location Buried Power Line
667.0 (666.90')
295.00'
(S 1°01'15" W 764.96' Meas) 0.04' Overage
153.81' (153.82')
S 0°58'00" W 764.92' Record
385.00' (385.06')
(217.61')
217.00'
247.00'
Water Valve
Gas Meter
Irr. Valve Box
Sewer Manholes
Bollards
Catch Basin
Concrete Walk
Curb & Gutter
Sidewalk
Lawn
Planter
Concrete
Asphalt
Existing Building
Buried Telephone Cable
Sign
Trunk of Tree
Tree Spread
Electric Manhole
Water Manhole
San. Sewer Manhole
Gas Meter
Fire Hydrant
Water Valve
Buried Power Cable
Sanitary Sewer Line
Culinary Water Line
Gas Line
Storm Drain Line
LEGEND
Vicinity Map
Not To Scale
24th STREET
25th STREET
LINCOLN AVENUE
GRANT AVENUE
Site
Location
Scale 1 = 30
NARRATIVE
This ALTA Survey was requested by Lezlie E. Beach of Crowley and Simonds, L.L.P. The property corners that were set August 1989 for Ogden Hotel Associates were found checked and honored.
DESCRIPTION
PARCEL A
A part of Block 24 Plat 'A' in Ogden City Weber County Utah
Beginning at the Northwest corner of said Block 24 and running thence along the North line of said Block 24 South 89 09' East 513 feet thence South 0°58' West 295 feet thence South 89 09' East 154 feet to a point on the East line of said Block 24 thence South 0 58' West 88 48 feet along said East line thence North 89°05 31' West 133 4 feet thence North 0°58' East 50 525 feet to the Southeast corner of Lot 9 in said Block 24, thence along the South line of Lots 9 and 8, North 89 05 31' West 270 6 feet, thence North 0 58' East 14 75 feet thence North 89 05 31' West 263 feet to a point on the West line of said Block 24 thence North 0 58' East 317 48 feet to the point of beginning
Contains 4 115 Acres
PARCEL C
A part of Block 24 Plat 'A' in Ogden City Weber County Utah
Beginning at a point on the West line of said Block 24 said point being South 0 58' West 317 48 feet from the Northwest corner of said Block 24 and running thence South 89 05 31' East 263 feet thence South 0 58' West 14 75 feet to a point on the South line of Lot 8 in said Block 24 thence along the South line of Lots 8 and 9 South 89 05 31' East 270 6 feet to the Southeast corner of Lot 9 in said Block 24, thence South 0 58' West 50 525 feet thence South 89 05 31' East 133 4 feet to a point on the East line of said Block 24 thence South 0 58' West 65 33 feet along said East line thence North 89 02' West 385 feet thence North 0 58' East 22 65 feet, thence North 89 02' West 282 feet to a point on the West line of said Block 24 thence North 0 58' East 107 33 feet to the point of beginning
Contains 1 557 Acres
SURVEYOR'S CERTIFICATE
The undersigned hereby certifies to SUNSTONE HOTEL INVESTORS L P BANK ONE ARIZONA, NA and FIDELITY NATIONAL TITLE COMPANY as follows
(a) This survey was actually made on the ground during the month of August 1997, is correct according to the record description of the subject property, and correctly shows (i) the location of all watercourse, water bodies, lot lines and monuments, (ii) the gross area of the subject property, (iii) all walkways, (iv) all ingress and egress points including curb cuts and driveways (v) all public and private roadways within abutting and/or adjacent to the subject property including a designation as to which are public and which are private, (vi) the location of all signs, including a brief description thereof, (vii) the location of all wire-bearing poles on the subject property, (viii) the boundaries and area of the subject property, (ix) the size, location and type of any buildings and improvements on the subject property and the distance from the nearest facing exterior property lines and the size and location of any foundations on the subject property (x) the locations of all rights-of-way, easements and any other matters of record (or of which I have knowledge or have been advised, whether or not of record) affecting or benefiting the subject property, (xi) the number and location of all parking spaces and facilities on the subject property (xii) the square footage of all buildings located on the subject property and (xiii) all other significant items on the subject property
(b) Except as set forth below there are not (i) encroachments upon the subject property, (ii) encroachments on adjacent property streets, easements or alleyways by any improvements on the subject property or (iii) party walls. The exceptions to the above statements are as follows None
(c) Adequate ingress to and egress from the subject property is provided by 24th Street Lincoln Avenue and Grant Avenue, the same being paved dedicated public rights-of-way.
(d) There are no violations of any building set back lines on the subject property except as shown below None
(e) According to the current and applicable national flood insurance rate maps the subject property is in flood zone C-Areas of Minimal Flooding (Firm Community Panel No 490189 0004B, January 19 1983), and
(f) The land described in Parcel A of the legal description of the subject property is contiguous to without gaps or gores the land described in Parcel B of the legal description of the subject property
(g) This survey and map or plat was made in accordance with the minimum standard detail requirements for ALTA/ACSM Land Title Surveys jointly established and adopted by ALTA and ACSM in 1992
Date
RECEIVED
APR 2 8 1998
Weber County Surveyor
By
J. R. Anderson
Registered Land Surveyor
Registration No. 2430
247 24th Street
Building Height
Minimum-One Story
Maximum-None
Building Setback
Front yard Main Building and Accessory Building-None
Parking Structure or Parking Lot-15
Side yard None except 10 adjacent to residential Zone boundary
Rear yard None except 10 adjacent to residential Zone boundary
Minimum Lot Area None
Maximum Lot Area None
Lot Coverage Building Shall no exceed 50% of entire Lot
Parking Summary
Zoning
Commercial Business District (CBD)-Intensive District
Parcel A
Tax Identification No 01-020-0008
Parcel C
Tax Identification No 01-020-0006
EXCEPTIONS TO COVERAGE
The following items are listed as exceptions to coverage in a Title report Prepared by Fidelity National Title Insurance Company, Utah - File No 144334 Dated June 23, 1997 at 8:00 AM
7. 12' wide Easement to Mountain Fuel Supply Company, dated 19 November 1981 and recorded December 8 1981 as Entry No 848462 in Book 1394 Page 336
8. 5' wide easement to the Mountain States Telephone & Telegraph Company, dated 24 December 1981 and recorded 4 January 1982 as Entry No 849765 in Book 1395 Page 1067
9. Parking and ALcess Agreement by and Between the Ogden City Neighborhood Development Agency and Ogden Hotel Associates A Utah Limited Partnership, dated 23 June 1983 and recorded 21 June 1984 as Entry No 911875 in Book 1448 Page 1444
10. Declaration of Easement and Restrictions by and Ogden Hotel Associate a Utah Limited Partnership and Mountain States-24th Street, LTD a Utah Limited Partnership, dated July 25 1986 and recorded July 29, 1986, as Entry No 976875 in Book 1495 at Page 1471
10' Wide Easement to Utah Power and Light Company recorded 17 June 1981 as Entry No 838081 in Book 1384 Page 25
5' Wide Easement to Mountain States Telephone & Telegraph Company recorded 19 August 1980 as Entry #817288 in Book 1363 Page 1470
(S1°01'15" W 764.96' Meas) 0.04' Overage
(295.02')
5' Wide Easement to Mountain States Telephone & Telegraph Company recorded 4 January 1982 as Entry No 849765 in Book 1395 Page 1067
