

NORTHWEST QUARTER OF SECTION 15, SURVEY 15, S.L.B.M., U.S. SURVEY FOUND WEBER COUNTY MONUMENT ST. BRASS CAP 3' BELOW ROAD SURFACE

**BOUNDARY DESCRIPTION**

PART OF THE NORTHWEST QUARTER OF SECTION 15, T.5N., R.1W., S.L.B.M., U.S. SURVEY, DESCRIBED AS FOLLOWS:  
THENCE N28°58'11"W 23.48' FEET TO THE POINT OF BEGINNING.  

**BASIS OF BEARINGS**


**NARRATIVE**

THE PURPOSE OF THIS PLAT WAS TO DETERMINE THE BOUNDARY OF THE STATE LARUE PROPERTY, TO BE DESCRIBED HEREIN, AND TO PROVIDE A DESCRIPTION, SURROUNDING PROPERTY BOUNDARY EVIDENCE WAS TIED AND FOUND TO MATCH THAT EVIDENCE. THE POSITION OF OLD POST ROADS WITHIN OLD POST ROAD WERE SET AT THE CLIENTS REQUEST.

**DEED DESCRIPTION**

A PART OF THE NORTHWEST QUARTER OF THE NORTHWEST QUARTER OF SECTION 15, SURVEY 15, NORTH, RANGE 1 WEST, SALT LAKE BASE AND MERIDIAN, U.S. SURVEY.  

SUBJECT TO THAT PORTION LYING WITHIN OLD POST ROAD

WEST QUARTER CORNER S.L.B.M., U.S. SURVEY, R.1W., FOUND WEBER COUNTY MONUMENT ST. BRASS CAP SET 3' BELOW ROAD SURFACE (1983)

**REVISIONS**





RECORD OF SURVEY

STEVE LARUE PROPERTY  
NORTHWEST QUARTER OF SECTION 15, T.5N., R.1W., S.L.B.M.

SHEET 1 OF 1

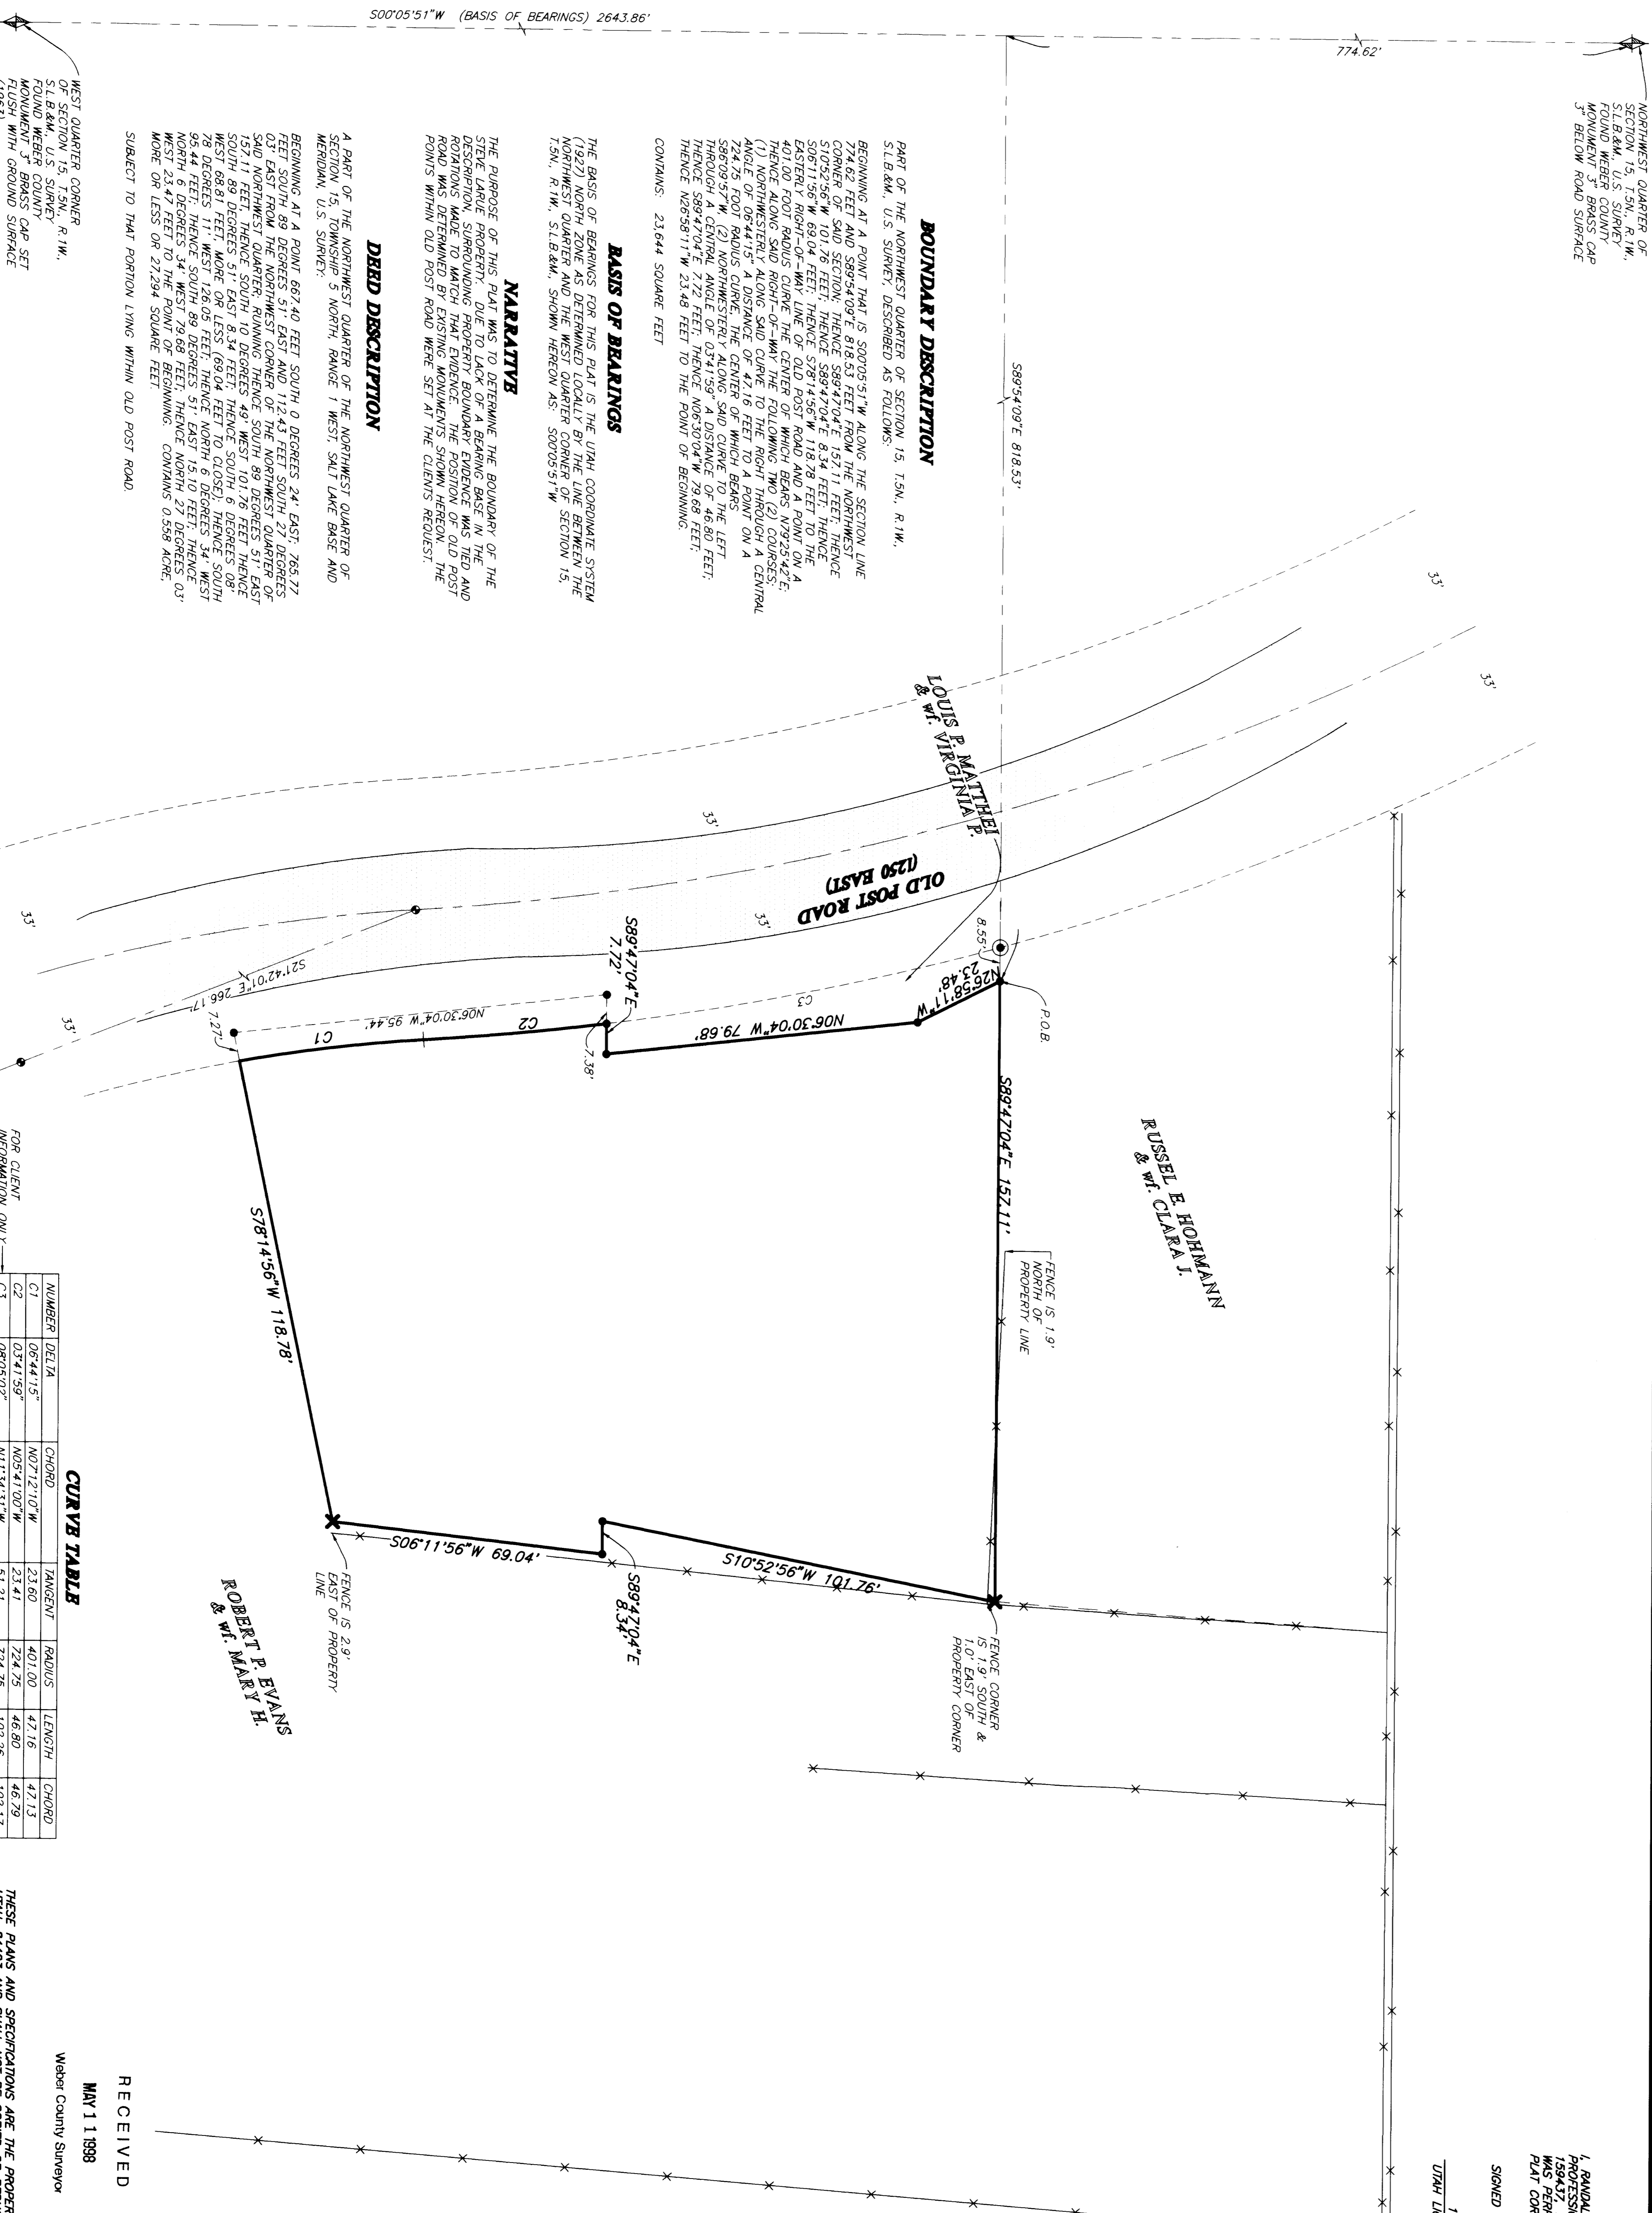

CURVE TABLE

NUMBER	DELTA	CHORD	TANGENT	RADIUS	LENGTH	CHORD
C1	08°44'15"	N07°12'10"W	23.60	401.00	47.16	47.13
C2	03°17'59"	N05°41'00"W	23.41	724.75	46.80	46.79
C3	08°05'02"	N11°34'51"W	51.21	724.75	102.26	102.17

RECEIVED  
MAY 11 1998  
Weber County Surveyor

- LEGEND**
- ◆ SECTION CORNER AS NOTED HEREON
  - ROUND STREET MONUMENT
  - ✕ MARKED X ON EXISTING ROCK FOR PROPERTY CORNER
  - SET HUB & TACK
  - SET 5/8" REBAR & CAP MARKED "REBAR & ASSOCIATES"
  - EXISTING FENCE LINE
  - EXISTING FENCE LINE

**SURVEYOR'S CERTIFICATE**  
I, RANDALL L. WILFORD, DEPOSE AND SAY THAT I AM A LICENSED PROFESSIONAL LAND SURVEYOR, HOLDING UTAH LICENSE NUMBER 159437, AND THAT I HAVE PERSONALLY AND INDEPENDENTLY CONDUCTED THIS SURVEY AND THAT THIS PLAT CORRECTLY DENOTES THE FINDINGS OF THAT SURVEY.  
SIGNED THIS 30th DAY OF APRIL 1998.  
RANDALL L. WILFORD  
159437  
UTAH LICENSE NUMBER  
LAND SURVEYOR

THESE PLANS AND SPECIFICATIONS ARE THE PROPERTY OF REEVE & ASSOC., INC. NO REPRODUCTION OR REPRODUCTION WITHOUT THEIR WRITTEN PERMISSION.