

NORTHWEST CORNER SEC. 8  
TOWNSHIP 5 NORTH, RANGE 1 EAST  
SAY LAKE BASIN AND REGION

BOUNDARY DESCRIPTION, REVERSED LOT 8.



CONTAINS 42,591 SQ. FT. 0.978 ACRES

BOUNDARY DESCRIPTION, REVERSED LOT 9.


CONTAINS 41,734 SQUARE FEET 0.959 ACRES

BOUNDARY DESCRIPTION, REVERSED LOT 7.




SURVEYOR'S CERTIFICATE



I, SCOTT F. McNEIL, LICENSED ENGINEER, ACCORDING TO THE RULES AND REGULATIONS OF THE STATE OF UTAH, I FURNISH STATE THAT THE PROPERTY DESCRIBED HEREON WAS SURVEYED UNDER MY DIRECT SUPERVISION AND THE RESULTS OF THIS SURVEY ARE DEPICTED HEREON.






EVERY DOCUMENT OF RECORD RECORDED AND CONSIDERED AS A PART OF THIS SURVEY IS NOTED HEREON. ONLY THE DOCUMENTS NOTED HEREON WERE SURVEYED TO THE SURVEYOR. NO ABSTRACT OF TITLE, NOR THE COMMUNION, NOR RESULTS OF TITLE SEARCHES WERE FURNISHED TO THE

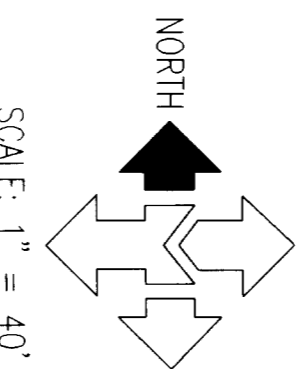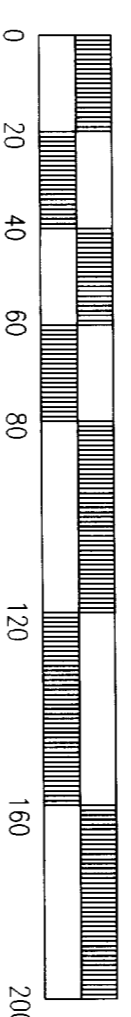

SCALE: 1" = 40'

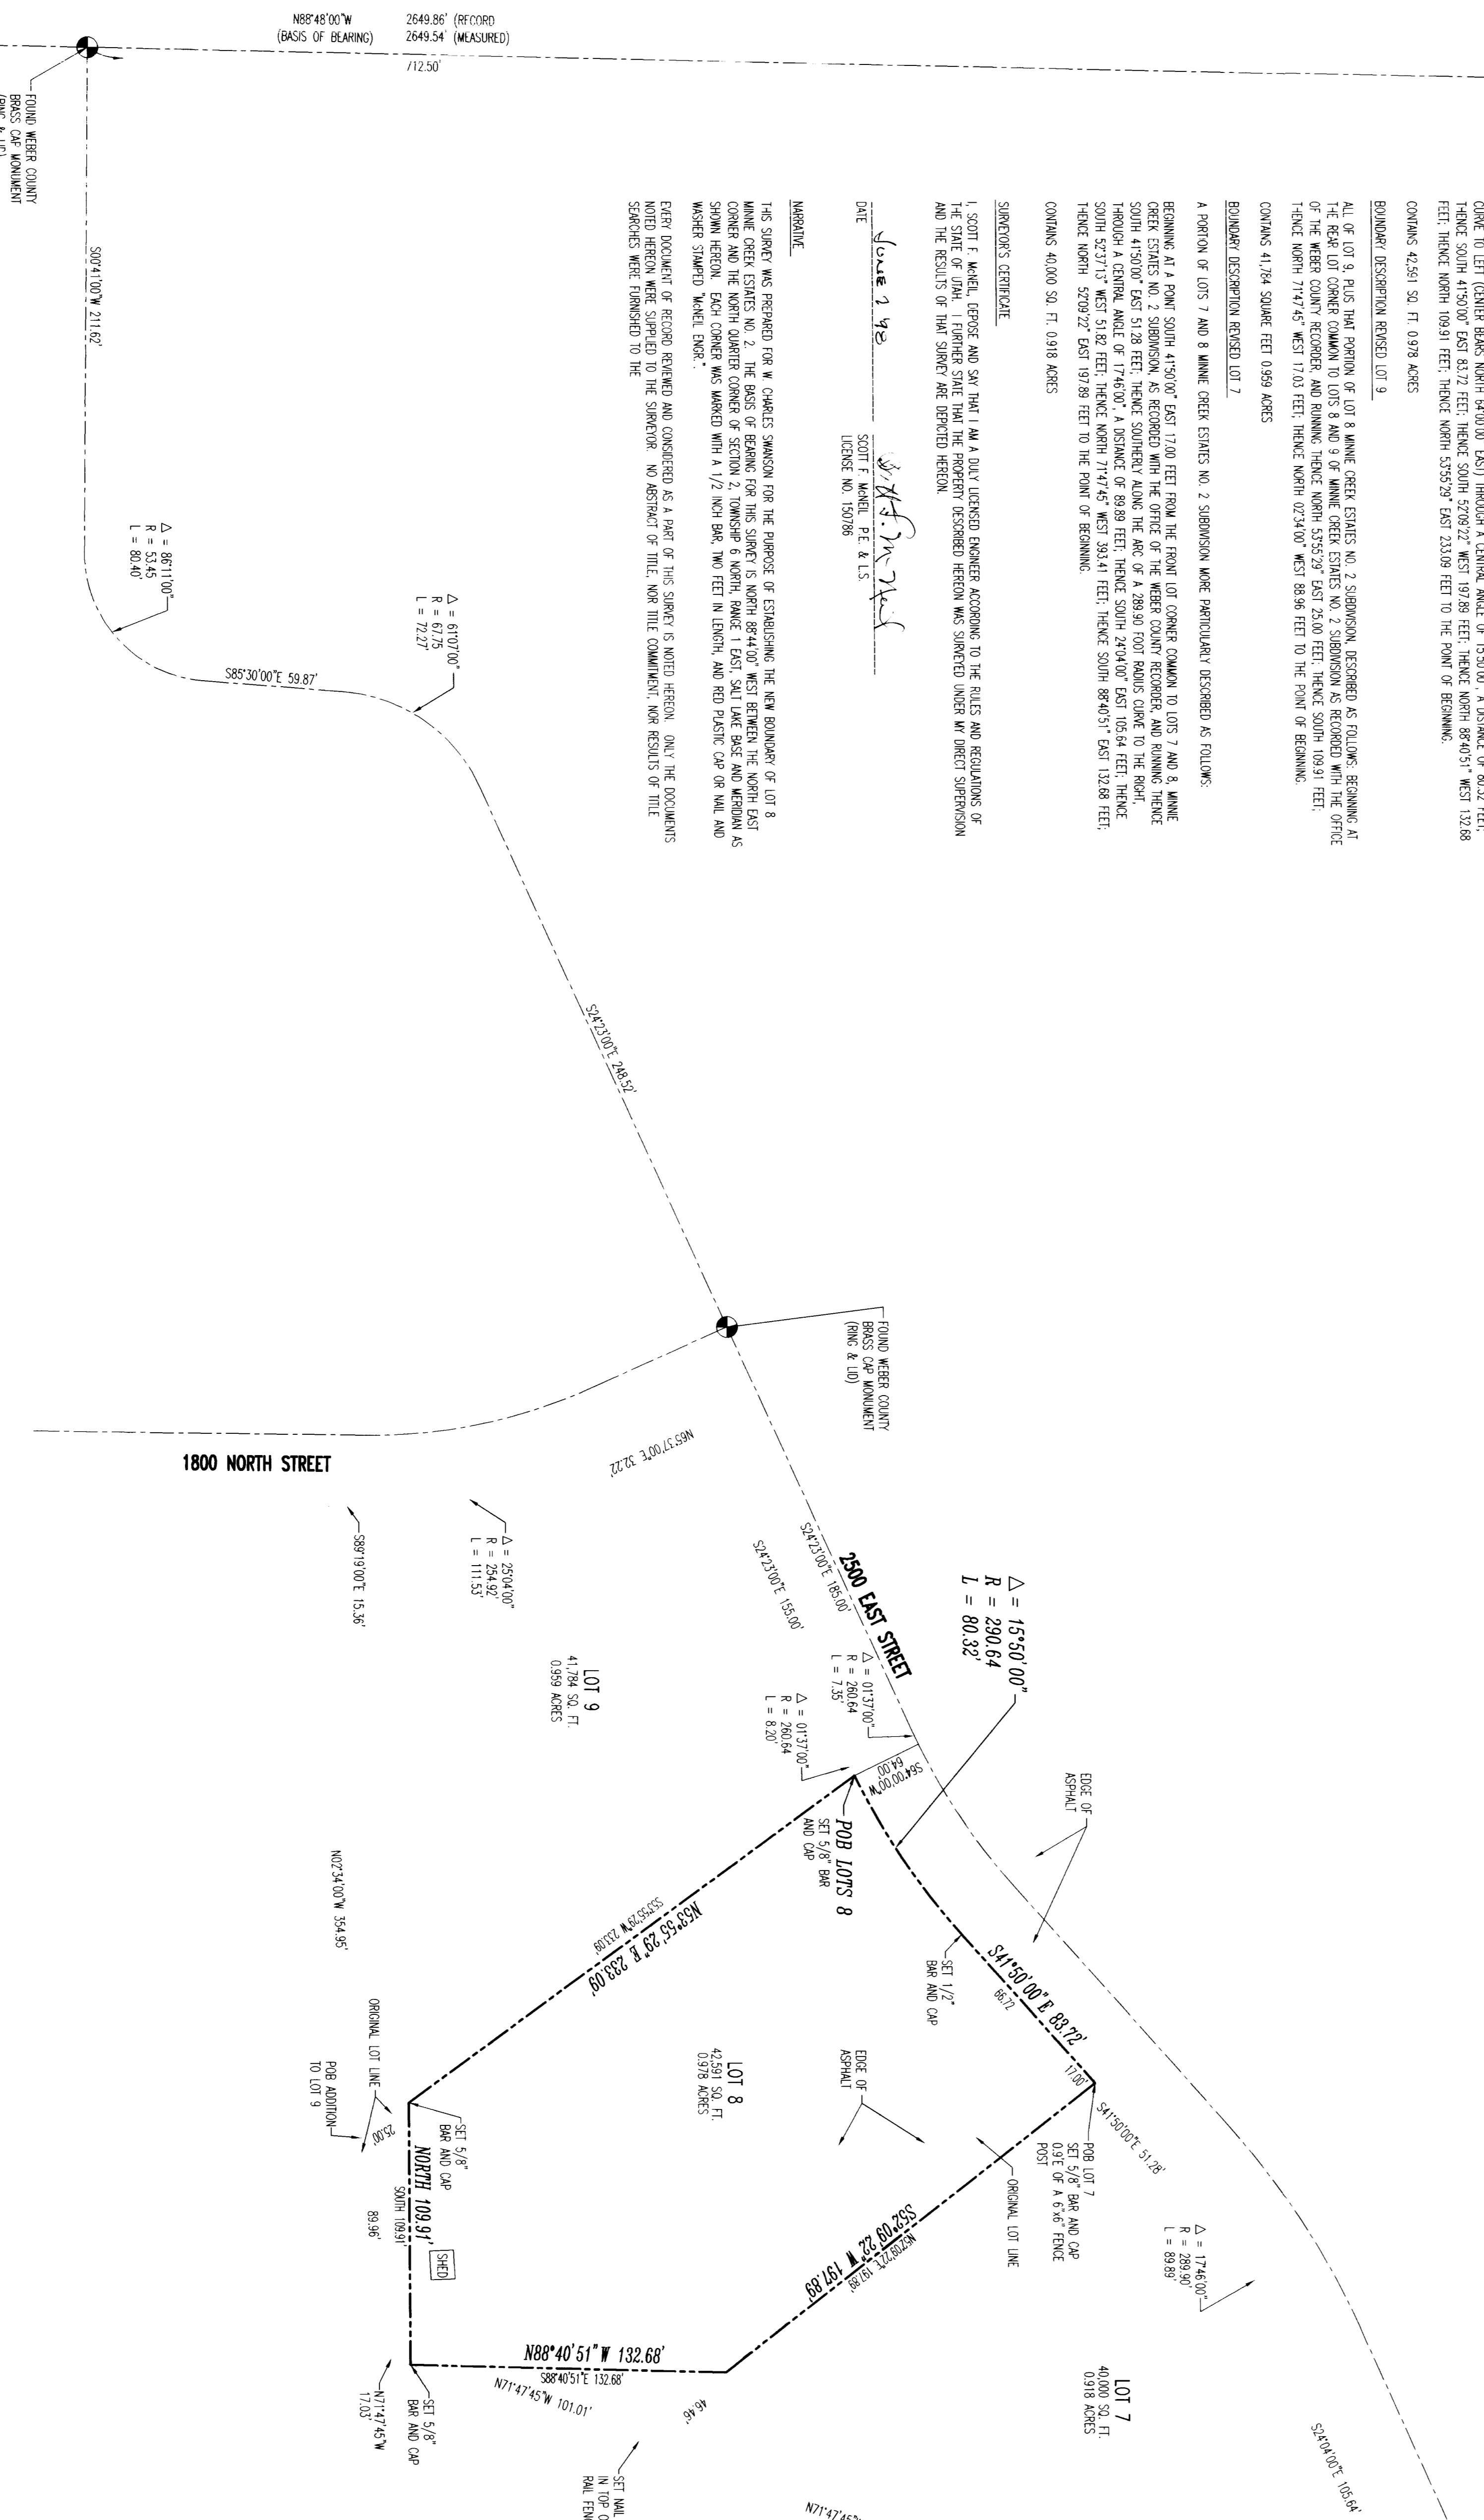

**McNEIL ENGINEERING AND LAND SURVEYING, L.C.**  
PROFESSIONAL CIVIL ENGINEERING & LAND SURVEYING SERVICES  
6895 SOUTH 900 EAST, MOVALE, UTAH 84047  
TEL: (801) 255-7700 FAX: (801) 255-8071 EMAIL: www.mcneileng.com

**SWANSON RESIDENCE**  
LOT 8 MINNOCREEK ESTATES NO. 2 1769 NORTH 6250 EAST EDEN, UT  
LOCATED IN THE NORTHEAST QUARTER SECTION 2, T4N, R1E, S44W

**BOUNDARY SURVEY FOR LOT LINE ADJUSTMENT**

DATE: 04/20/98  
DRAWN BY: JTD  
CALC. BY: CM  
CHECKED BY: SW  
SCALE: 1" = 40'  
COMP. ENGINE: 98320802

**REVISIONS**

NO.	DATE	DESCRIPTION
1		

**DRAWING INFORMATION**

JUN 09 1998  
Weber County Surveyor

RECEIVED  
JUN 09 1998  
Weber County Surveyor