

LEGAL DESCRIPTION




SURVEYORS CERTIFICATE




NARRATIVE

15 FEET) Meas. 2125.62 FEET.

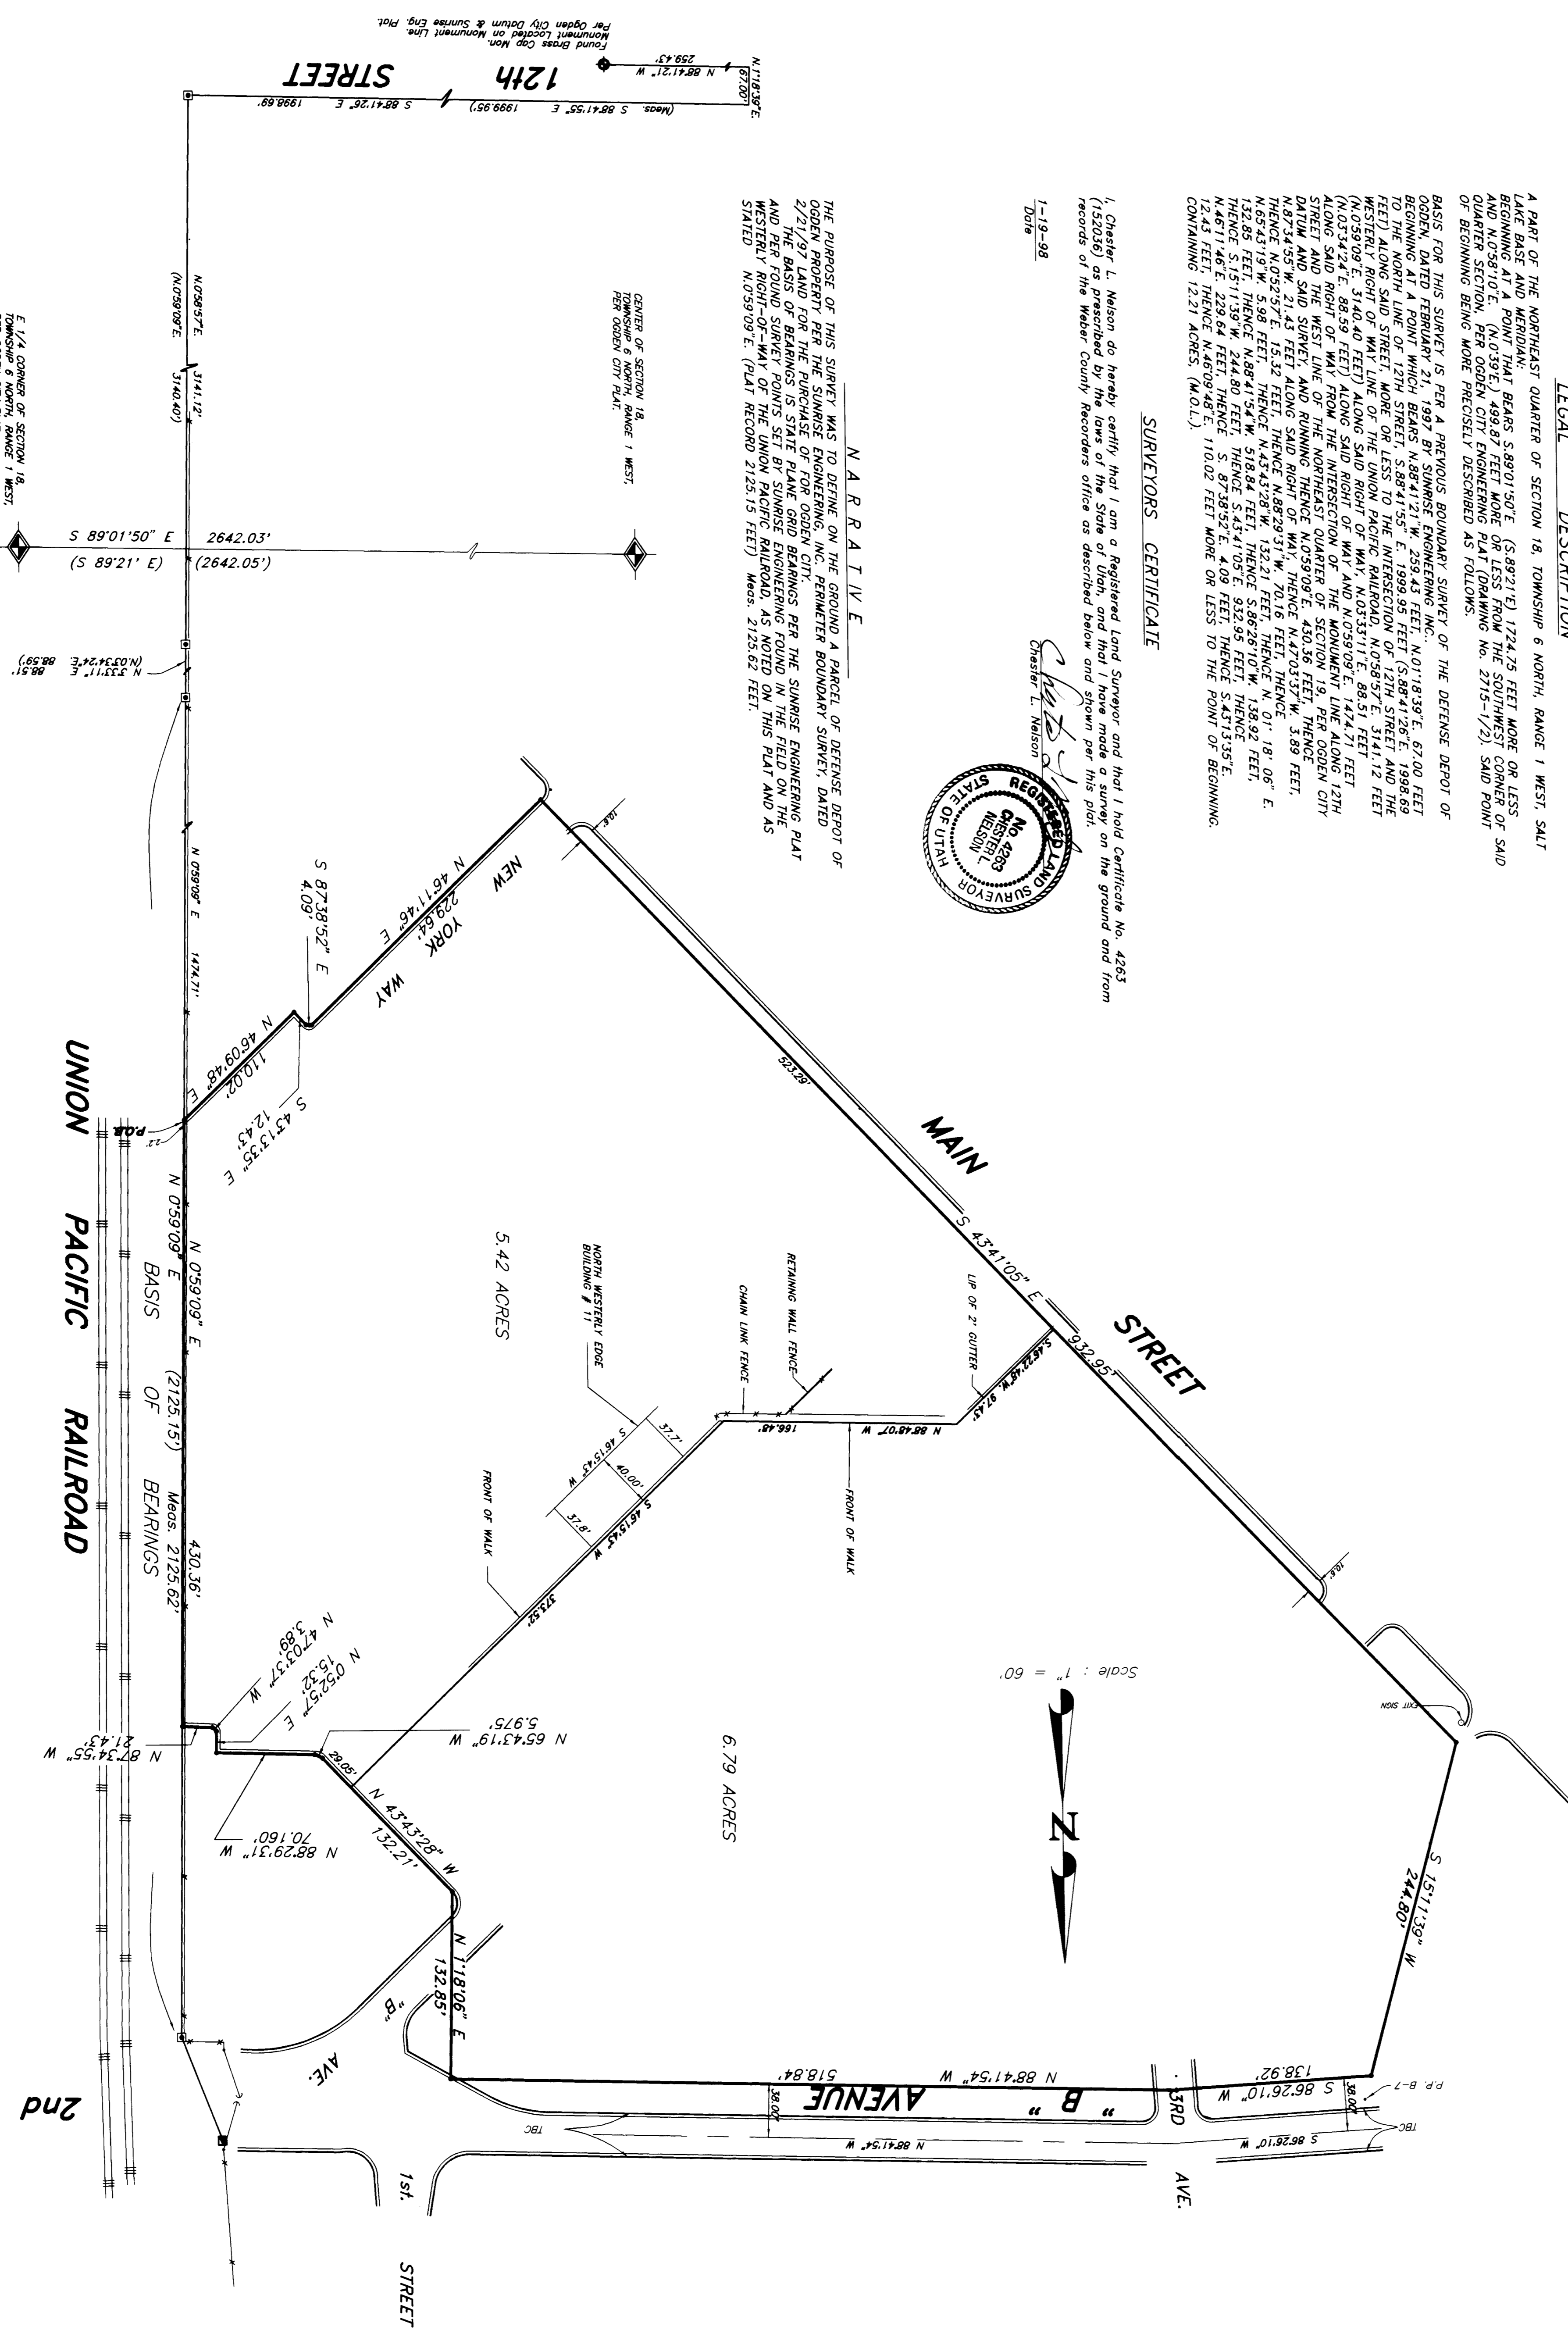

LEGEND

- ( ) DISTANCE AND OR BEARING PER DEED OR PLAT.
NO PARENTHESES IS MEASURED DISTANCE OR ROTATED PLAT OR DEED BEARING TO STATE PLANE GRID BEARING.
EXISTING FENCES.
SET 5/8" REBAR WITH C & L.S. CAP.
FOUND SOURCE ENG. REBAR/CAP.
SET C.I.S. NAIL & TAG.

NOTE

WHERE PROPERTY LINE FOLLOWS THE SAME DIRECTION AS CURB & GUTTER, PROPERTY LINE OF CURB APPROXIMATELY 0.1 FOOT FROM TOP BACK OF CURB.

REVISIONS
15-17-97 BOUNDARY CHANGE.
1-8-98 CHANGE QUARTER SECTION FROM S.E. TO N.E.
1-19-98 ADDED TIES TO SECTION LINE IN LEGAL DESCRIPTION.

PREPARED BY:
CONSTRUCTION & LAND SURVEYORS
810 CANTON ROAD
OGDEN UTAH 84404
PH: (801) 398-4935 FAX: (801) 827-1088

RECEIVED
JUN 11 1998
Weber County Surveyors
CLIENT: OGDEN CITY
DEVELOPMENT CORP.
SURVEY LOCATION:
N.E. 1/4 SEC. 18, TOWNSHIP 6 NORTH, RANGE 1 WEST, SALT LAKE BASE & MERIDIAN
SURVEY DATE: 8/15/97
JOB No. PS97-36