

## LEGAL DESCRIPTION

A PART OF THE NORTHEAST QUARTER OF SECTION 18, TOWNSHIP 6 NORTH, RANGE 1 WEST, SALY LAKE BASIN AND MERIDIAN, T- BEARS S.89°14'37"E (S.89°14'37") 202.28 FEET MORE OR LESS BEGINNING AT THE SOUTHWEST CORNER OF SAID QUARTER SECTION, PER OGDEN CITY ENGINEERING PLAT (DRAWING NO. 2115-1/2), SAID POINT OF BEGINNING BEING MORE PRECISELY DESCRIBED AS FOLLOWS:

BASIS FOR THIS SURVEY IS PER A PREVIOUS BOUNDARY SURVEY OF THE DEFENSE DEPOT OF OGDEN CITY, UTAH, OF THE OGDEN CITY ENGINEERING PLAT (DRAWING NO. 2115-1/2), BEGINNING AT A POINT WHICH BEARS N.88°41'21" W, 258.43 FEET, N.01°18'39" E, 67.00 FEET TO THE NORTH LINE OF 12TH STREET, S.88°41'55" E, 1999.95 FEET, S.88°41'28" E, 1998.66 FEET ALONG SAID WEST LINE, THE OGDEN CITY ENGINEERING PLAT (DRAWING NO. 2115-1/2), (N.

## SURVEYORS CERTIFICATE



1-19-98  
2508



## NARRATIVE



Scale : 1" = 60'

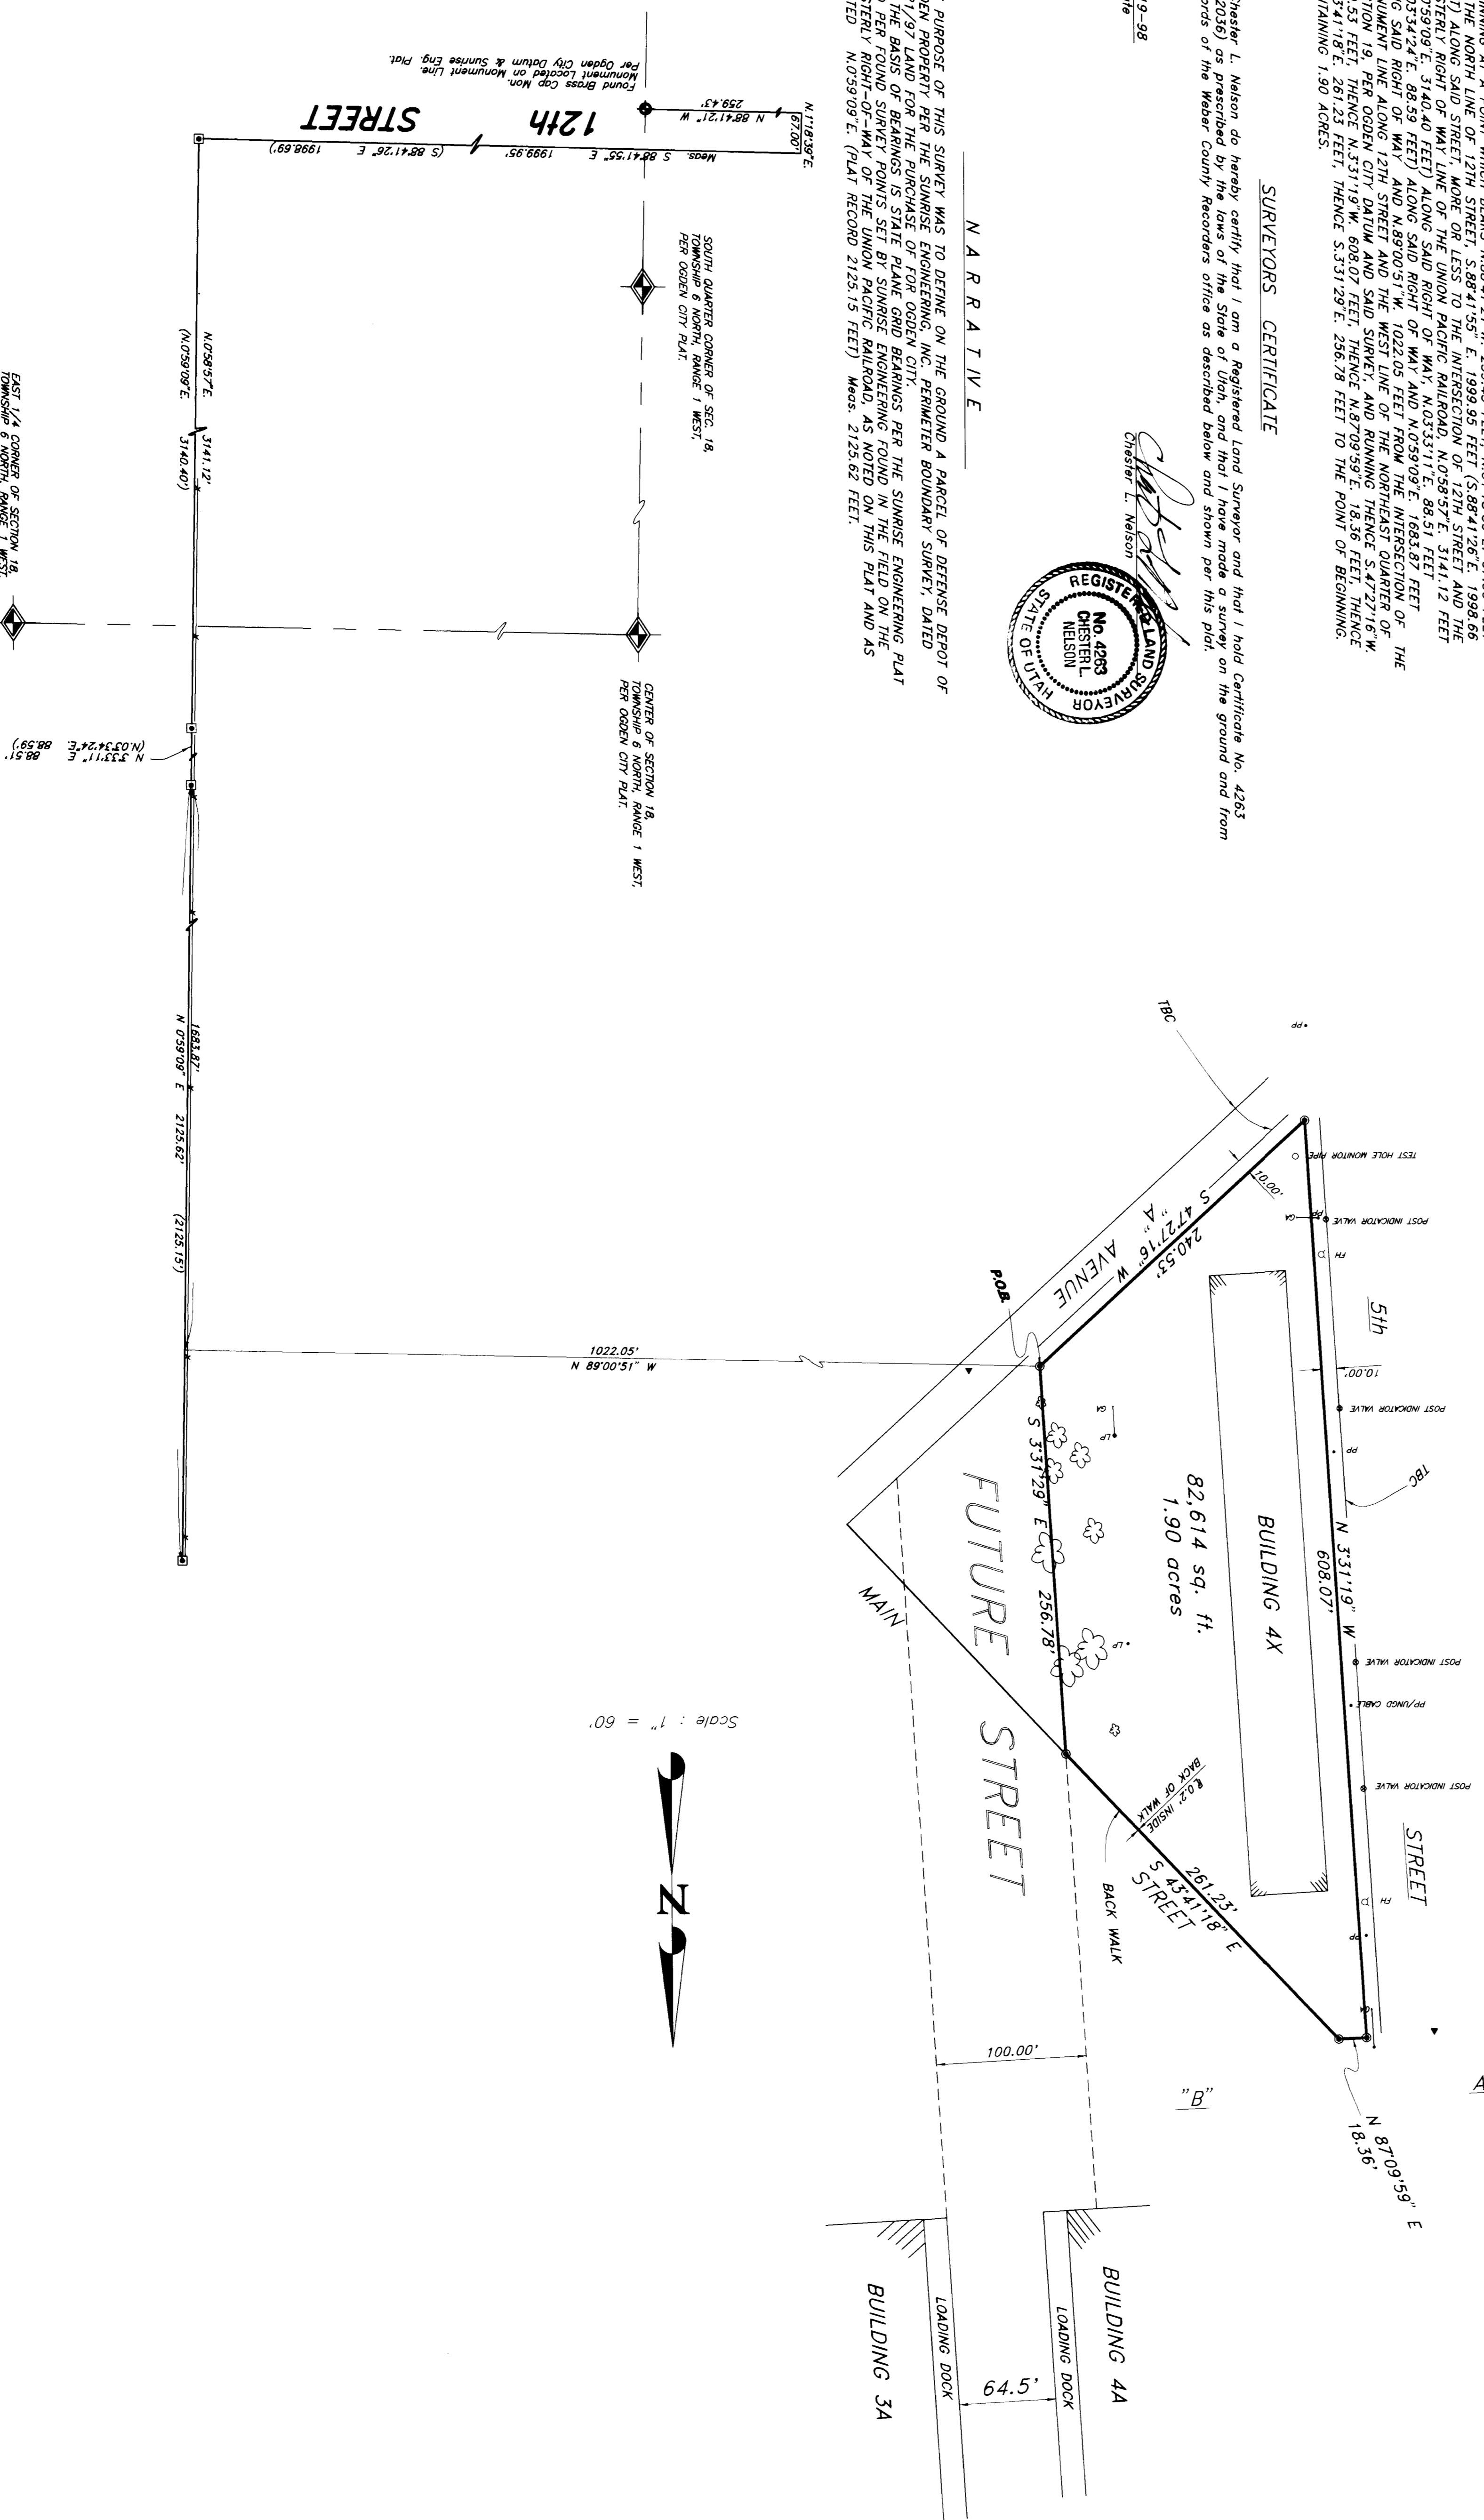

REVISIONS:  
1-19-98  
ADDED TIES TO SECTION LINE  
IN LEGAL DESCRIPTION.

## LEGEND:

- ( ) DISTANCE AND OR BEARING PER DEED OR PLAT
- ( - - - ) PARALLELS IS MEASURED DISTANCE OR ROTATED PLAT
- ( - - - ) OR DEED BEARING TO STATE PLANE GRID BEARING
- EXISTING FENCES
- ( - - - ) SET 5/8" REBAR WITH C. & L.S. CAP.
- ( - - - ) FOUND SURVEY ENCL. REBAR/CAP
- ( - - - ) ERROR/FREN TREES

## RECEIVED

JUN 11 1998


CONSTRUCTION & LAND SURVEYORS 810 CANYON ROAD OGDEN, UT 84204 (801) 399-4835
CLIENT: OGDEN CITY DEVELOPMENT CORP.
SURVEY LOCATION: NE 1/4 SEC. 18, TOWNSHIP 6 NORTH, RANGE 1 WEST, SALY LAKE BASIN & MERIDIAN
SURVEY DATE: 1-9-98
JOB NO. PS97-47

001973





PREPARED BY:  
**CONSTRUCTION & LAND SURVEYORS**  
810 CANYON ROAD  
OGDEN, UTAH 84204  
PH: (801) 399-4835 FAX: (801) 422-1088