

LEGAL DESCRIPTION


SURVEYORS CERTIFICATE


I, Chester L. Nelson, do hereby certify that I am a Registered Land Surveyor and that I hold Certificate No. 4263 of the State of Utah, and that I have made a survey on the ground and from records of the Weber County Recorder's office as described above and shown on this plat.



1-28-98 Date

NARRATIVE


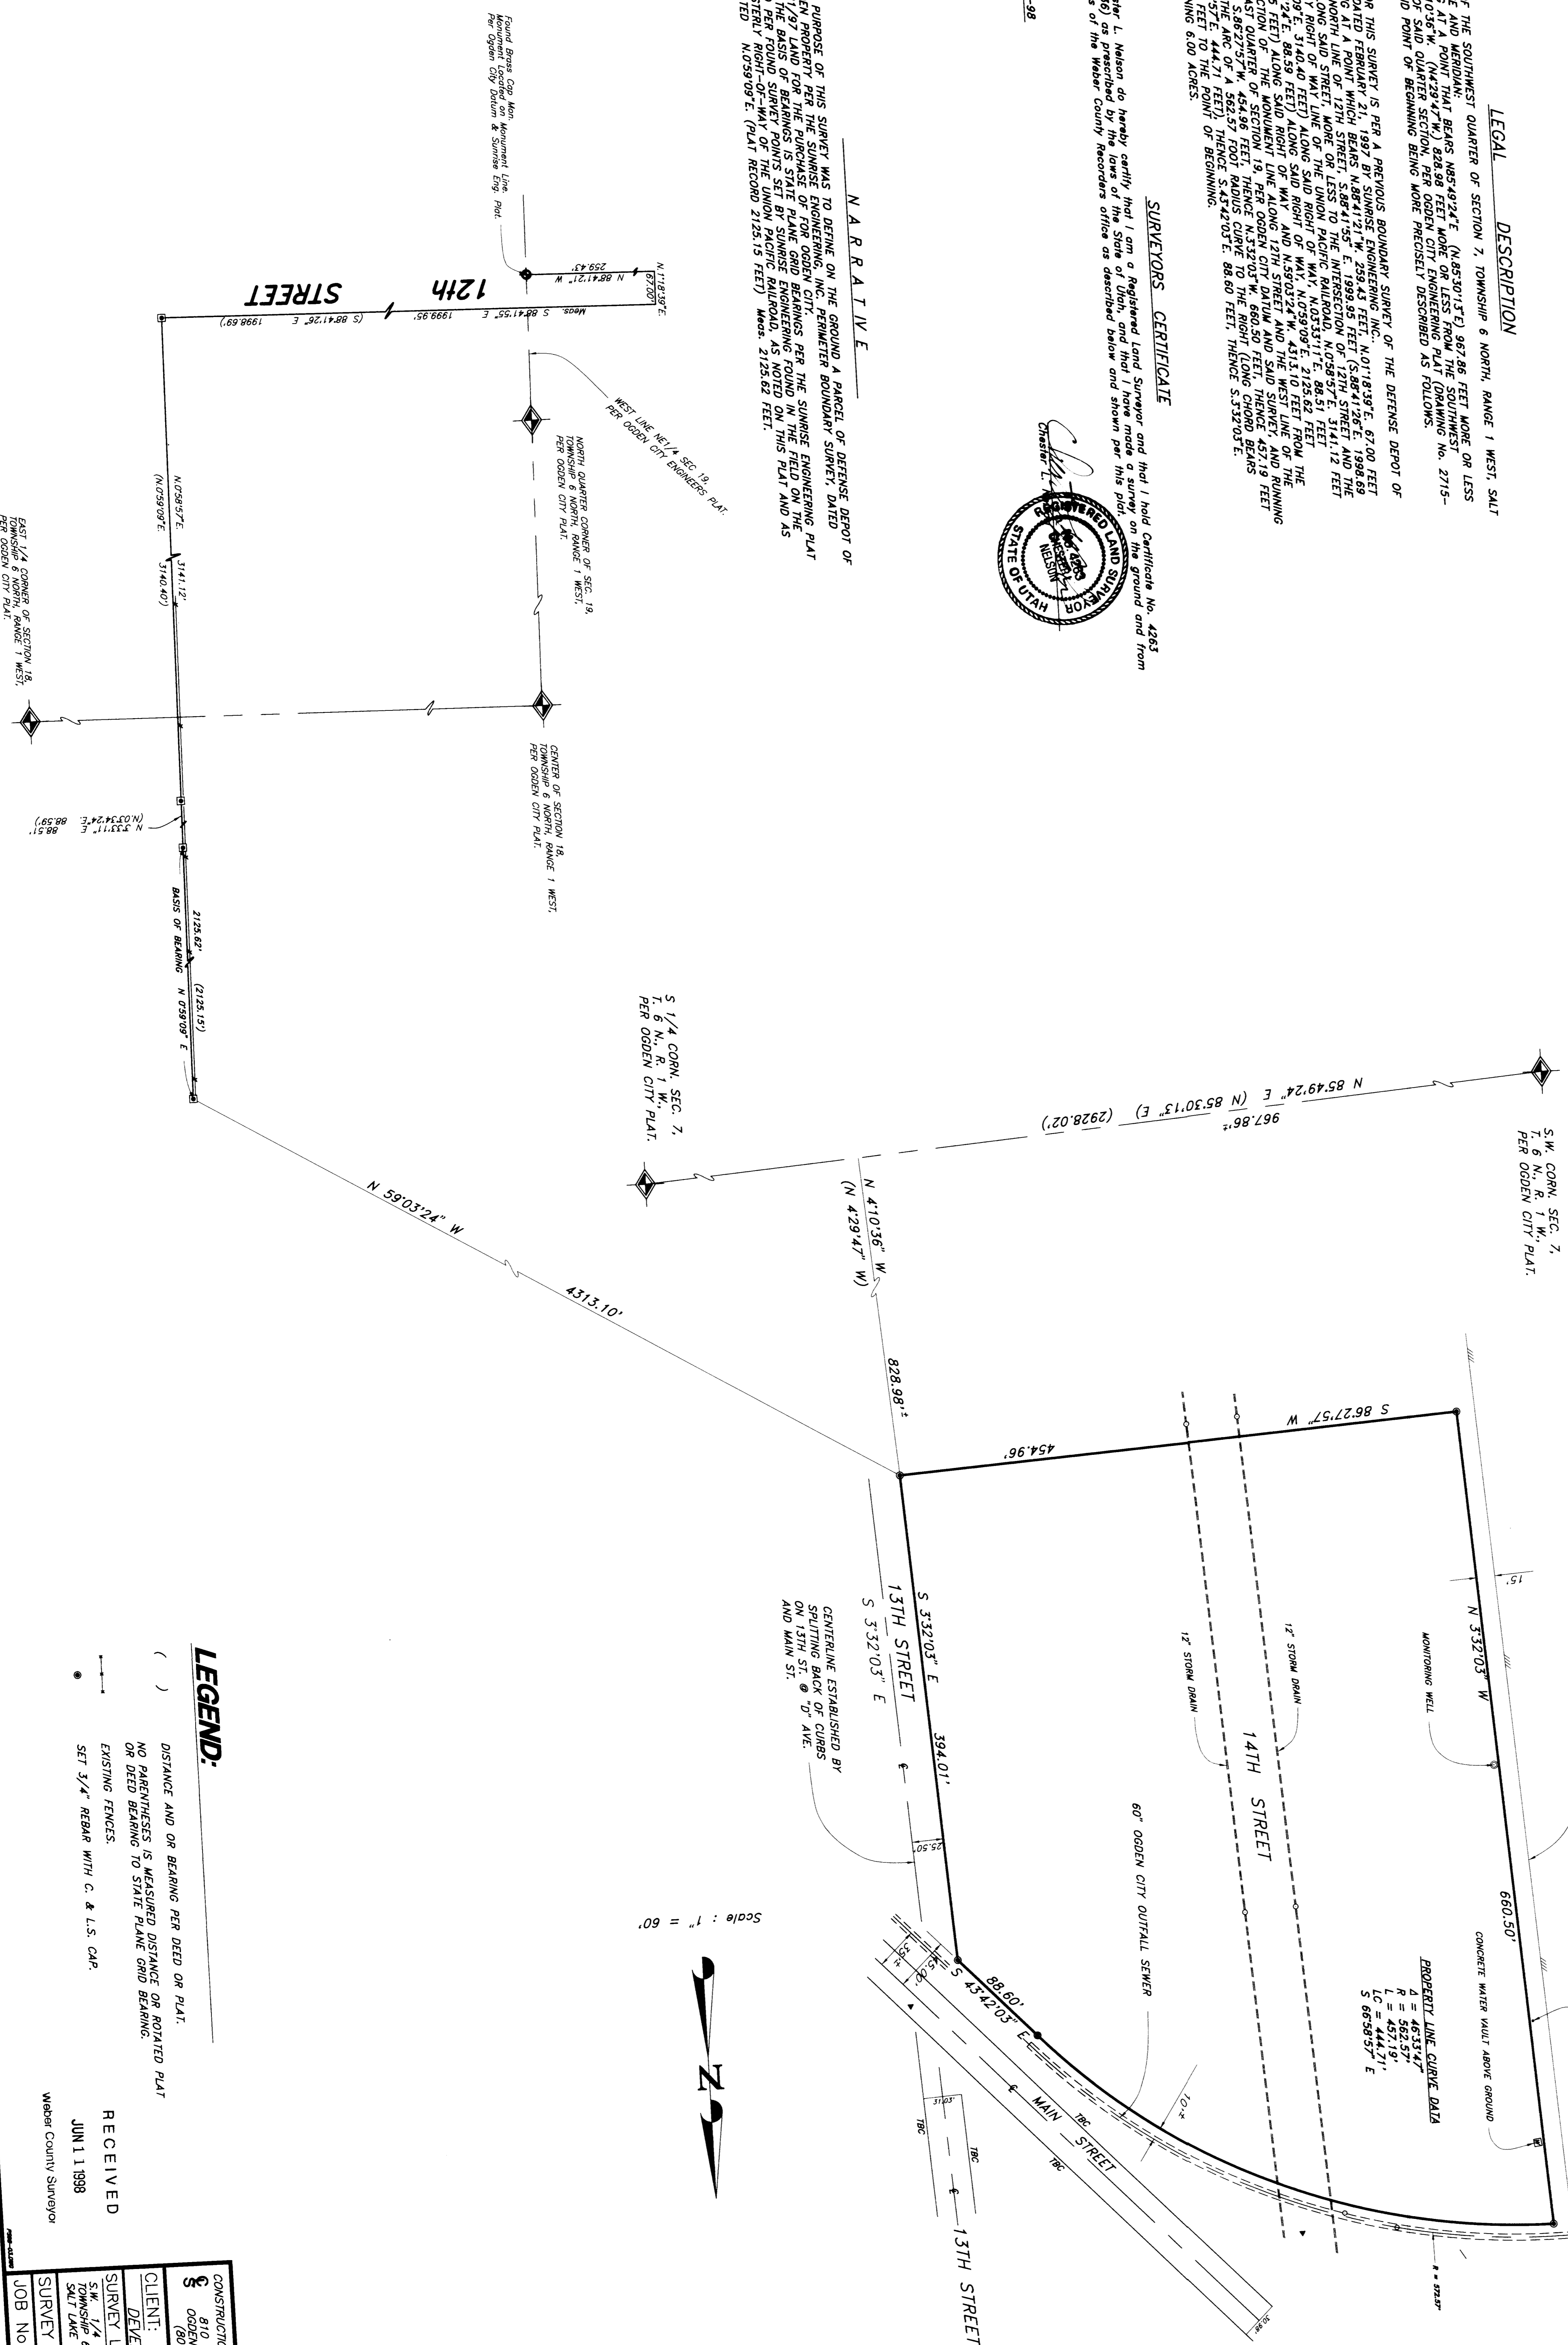

LEGEND: DISTANCE AND OR BEARING PER DEED OR PLAT. NO PARALLELS IS MEASURED DISTANCE OR ROTATED PLAT OR BEID BEARING TO STATE PLANE GRID BEARING. EXISTING FENCES. SET 3/4" REBAR WITH C. & L.S. CAP.

RECEIVED JUN 11 1998 Weber County Surveyor. CLIENT: OGDEN CITY DEVELOPMENT CORP. SURVEY LOCATION: TOWNSHIP 6 NORTH, RANGE 1 WEST, SALT LAKE BASE & MERIDIAN SURVEY DATE: 1-21-98 JOB NO. PS98-03