

SURVEYORS CERTIFICATE



DATE 9-30-92



BOUNDARY DESCRIPTION

ALL OF LOT 107, DOBEN COMMERCIAL & INDUSTRIAL PARK PLAT 'H', DOBEN CITY, WEBER COUNTY, UTAH.

NOTE: A PART OF THE SOUTHWEST QUARTER OF SECTION 25 TOWNSHIP 6 NORTH RANGE 2 WEST SALT LAKE BASIN AND MERIDIAN U.S. SURVEY BEGINS AT A POINT BEING SOUTH 88°49'46" EAST 508.00 FEET FROM THE SOUTHWEST CORNER OF SAID SECTION 25 SAID RANGE AND MERIDIAN. 

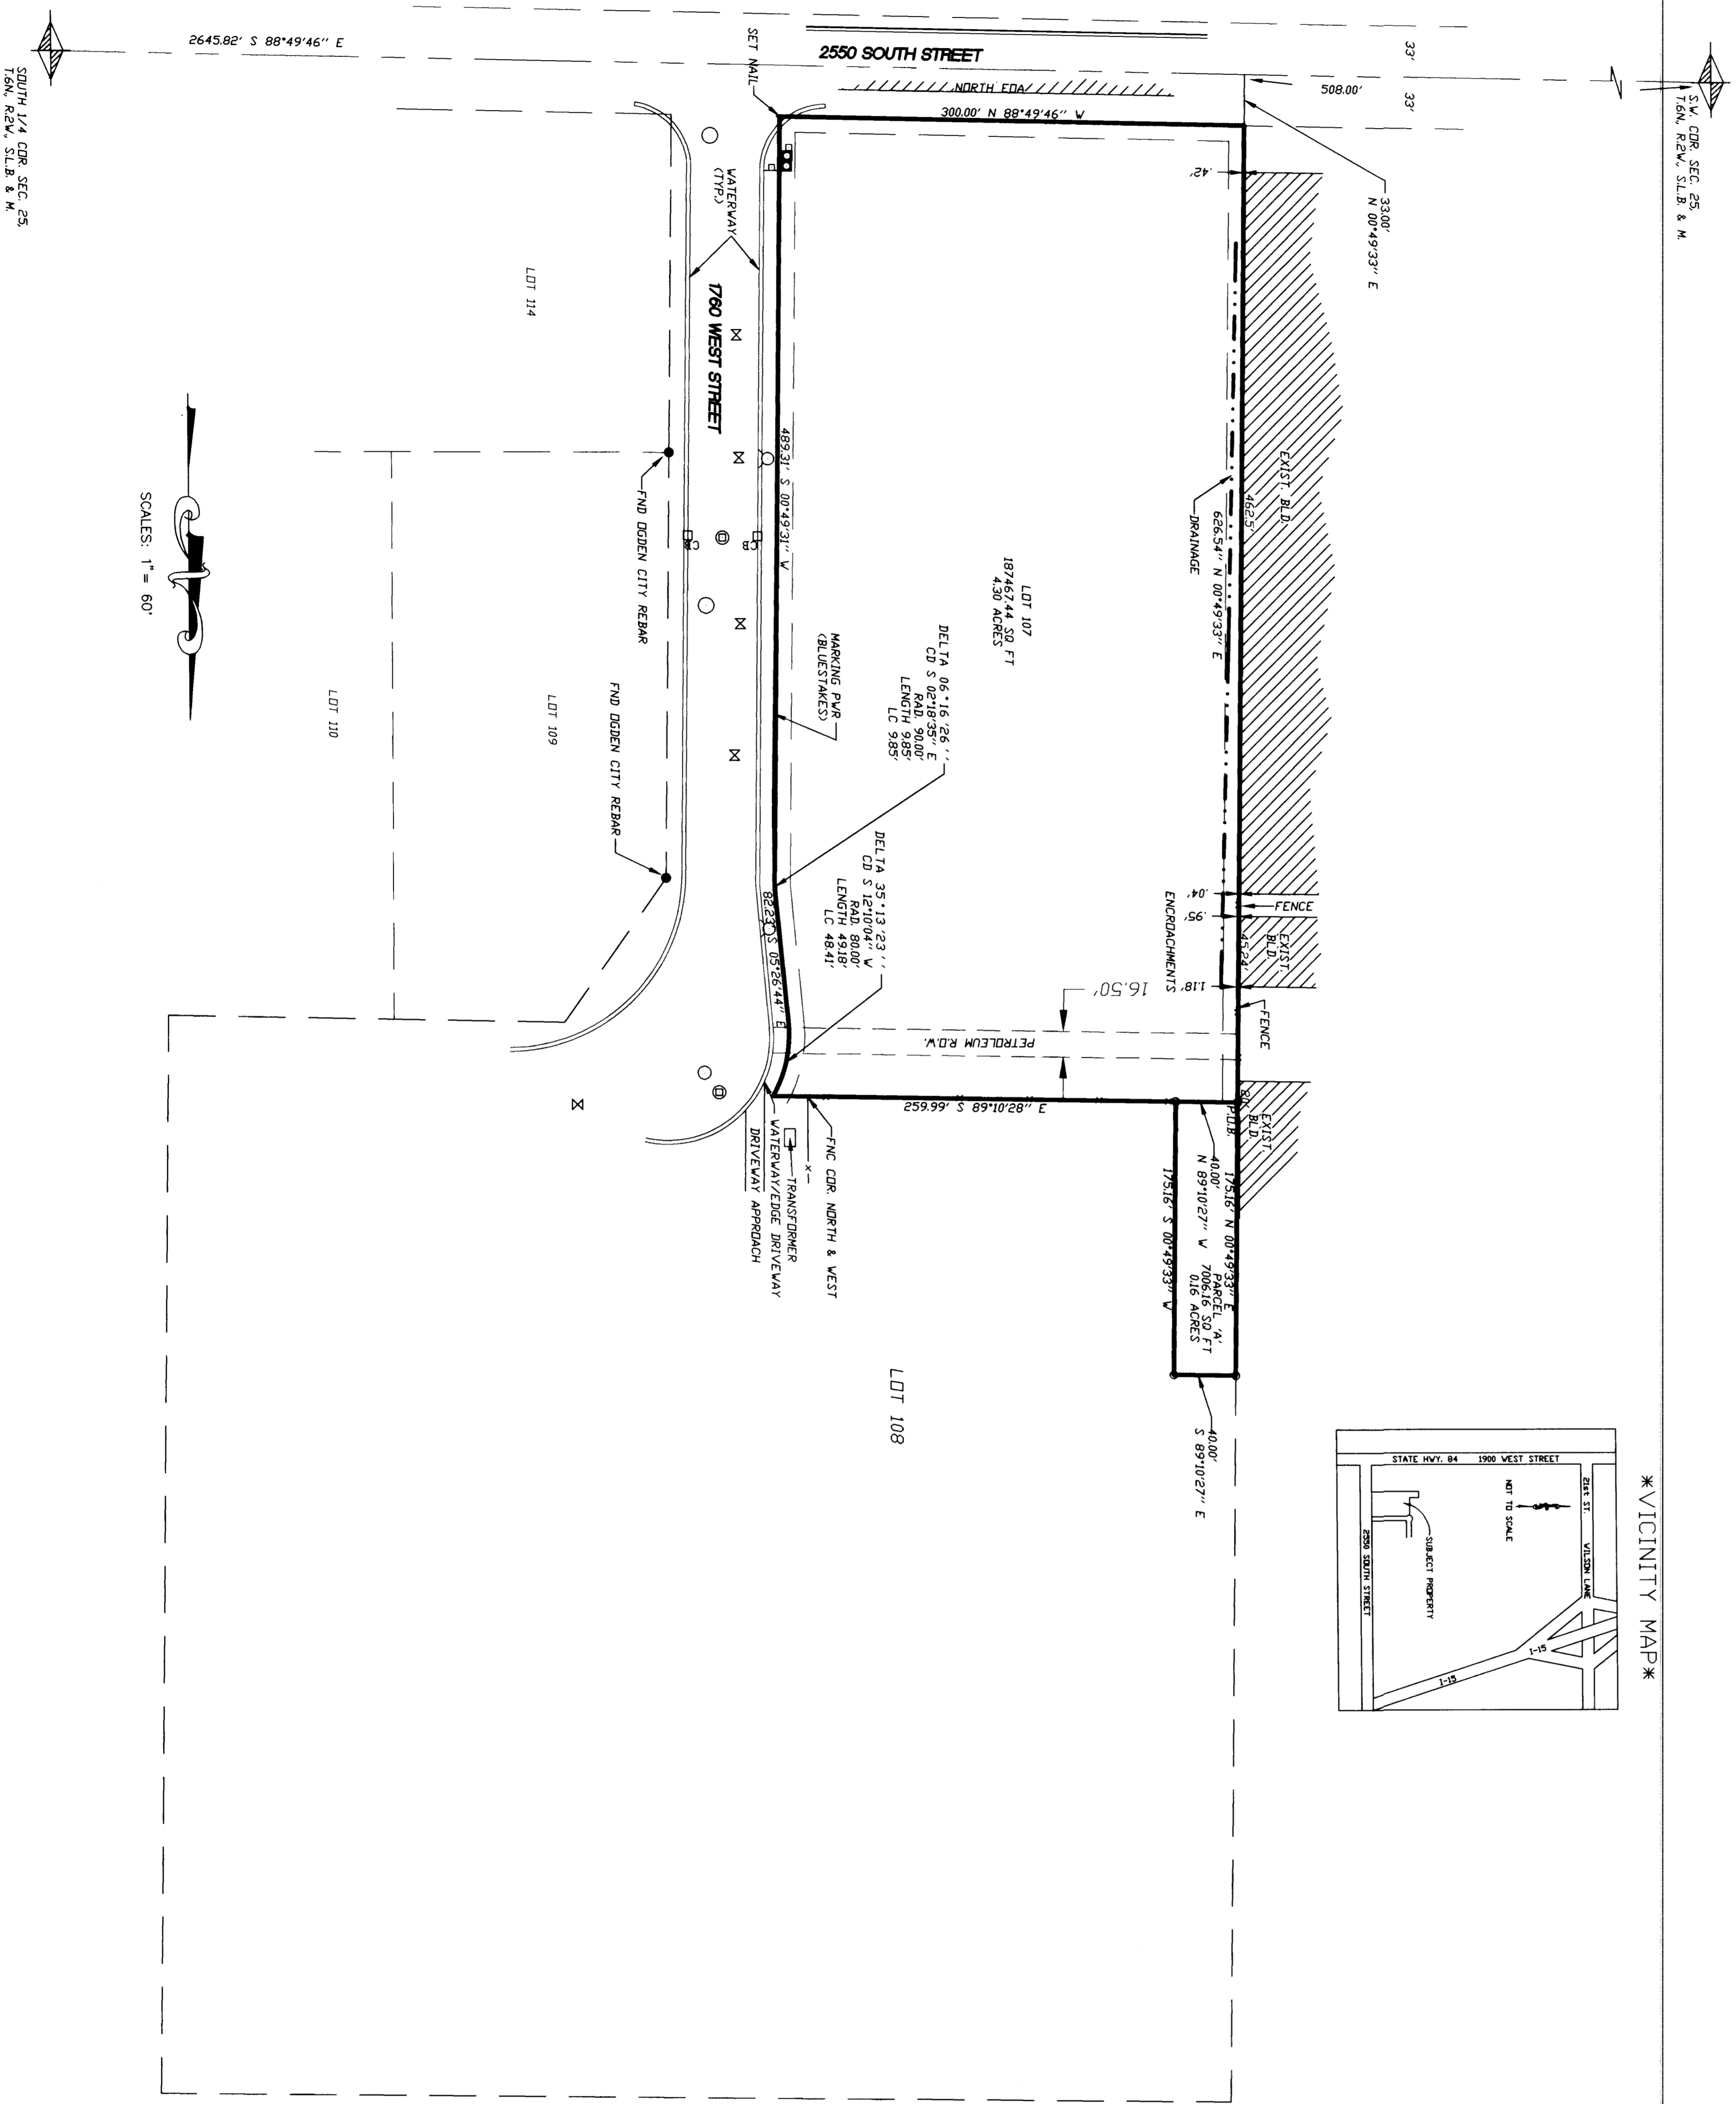

5/4" COR. SEC. 25
1/4" COR. SL. B. & M.

REVISIONS

1)	12-1-91	5)	DATE: 9-29-92 TW
2)		6)	CHECKED BY: [Signature]
3)		7)	SCALE: 1" = 60'
4)		8)	JOB NO. 1917INDWG

LANDMARK SURVEYING
A COMPLETE SURVEYING SERVICE
2485 GRANT AVENUE SUITE 318 DOBEN, UTAH 84401
PHONE 827-4014

ALTA/ACSM LAND TITLE SURVEY

B M C WEST

SET SURVEYOR TERRY REBAR
V-Map Surveyed 12/29/91

RECEIVED
JUN 19 1998
Weber County Survey

SHEET 1
1 SHEETS