

**SURVEYOR'S CERTIFICATE**

I, RONALD L. DREAGER, DEPOSE AND SAY THAT I AM A LICENSED PROFESSIONAL LAND SURVEYOR, PROPERTY DESCRIBED HEREON WAS PERFORMED BY ME OR UNDER MY DIRECTION, AND THAT THIS PLAN CORRECTLY DEPICTS THE FINDINGS OF THAT SURVEY.

SIGNED THIS 15<sup>TH</sup> DAY OF SEPTEMBER, 1998.  
 1598427  
 CIVIL ENGINEER  
 No. 1598427  
 R. Dreager  
 SURVEYOR



**BASIS OF BEARINGS**


**NARRATIVE**

THE PURPOSE OF THIS PLAN IS TO DETERMINE THE BOUNDARY OF THE TWO PARCELS TOGETHER. THE NORTHERLY LINE WAS FIXED BY THE SOUTHERN PACIFIC RAILROAD COMPANY SOUTHERLY RIGHT-OF-WAY LINE. THE OF 17TH STREET SOUTHERLY RIGHT-OF-WAY LINE WAS FIXED BY THE CALL TO EXISTING FENCE IN THE DEED. THE EAST LINE WAS FIXED BY AN EXISTING FENCE. ALL CORNERS ARE SET WITH 5/8" REBAR AND CAP MARKED REBAR & ASSOCIATES, UNLESS OTHERWISE NOTED HEREON.

**SURVEYED DESCRIPTION**

PART OF THE SOUTH HALF OF SECTION 19, T.6N., R.1E., S.L.B.&M., U.S. SURVEY DESCRIBED AS FOLLOWS:

BEGINNING AT THE INTERSECTION OF THE QUARTER SECTION LINE AND THE SOUTH RIGHT-OF-WAY LINE OF THE SOUTHERN PACIFIC RAILROAD, LINE 8272.9 INTERSECTION OF THE CENTER OF SAID SECTION 19, SAID POINT ALSO BEING ON A 3641.52 FOOT RADIUS CURVE, THE CENTER OF WHICH BEARS S2022.50'W, THENCE SOUTHWESTERLY ALONG SAID RIGHT-OF-WAY LINE AND SAID CURVE TO THE POINT OF BEGINNING, A DISTANCE OF 207.60 FEET TO THE POINT OF BEGINNING; (1) S7437.59'W 110.93 FEET AND (2) S8541.00'W 79.21 FEET, THENCE ALONG SAID RIGHT-OF-WAY LINE THE FOLLOWING TWO COURSES: (1) S7437.59'W 42.47 FEET, THENCE N17319.00'W 23.70 FEET, THENCE N1315.00'W 42.47 FEET, THENCE N0728.44'E 383.84 FEET AND N0705.46'W 539.20' FEET TO SAID SOUTH RIGHT-OF-WAY LINE BEING A POINT ON A 3641.52 FOOT RADIUS CURVE THE CENTER OF WHICH BEARS S17208.51'W, THENCE SOUTHWESTERLY ALONG SAID CURVE OF WHICH BEARS THROUGH THE POINT OF BEGINNING, A DISTANCE OF 207.60 FEET TO THE POINT OF BEGINNING. CONTAINS: 6.30 ACRES

**GIBSON STREET**

N 89°02'00" W 363.70'  
 (BASIS OF BEARINGS)  
 N 17°02'01" W 1701.84'  
 S 87°59'41" W 320.12'  
 S 69°52'26" W 528.26'  
 S 74°37'59" W 110.93'

**CENTER STREET**

N 13°15'00" W 42.47'  
 N 17°31'09" W 43.14'  
 N 47°10'18" W 61.02'  
 N 77°44'00" W 23.70'  
 S 74°37'59" W 110.93'  
 S 74°37'59" W 299.33'  
 S 85°41'00" W 79.21'  
 S 02°45'56" W 2654.20'

**PARCEL 1**

(WITHIN CITY LIMITS)

PART OF THE SOUTHWEST QUARTER OF SECTION 19, T.6N., R.1E., S.L.B.&M., U.S. SURVEY DESCRIBED AS FOLLOWS:  






**CURVE TABLE**


**LEGEND**

- SECTION CORNER FOUND AS SHOWN
- STREET MONUMENT FOUND AS SHOWN HEREON
- EXISTING FENCE LINE
- RAILROAD
- EXISTING PARKING
- EXISTING BUILDING





**SOUTHERN PACIFIC RAILROAD COMPANY**

FENCE CORNER IS ON PROPERTY CORNER, NO REBAR SET

**RONALD L. DREAGER & W.F. RITA M.**

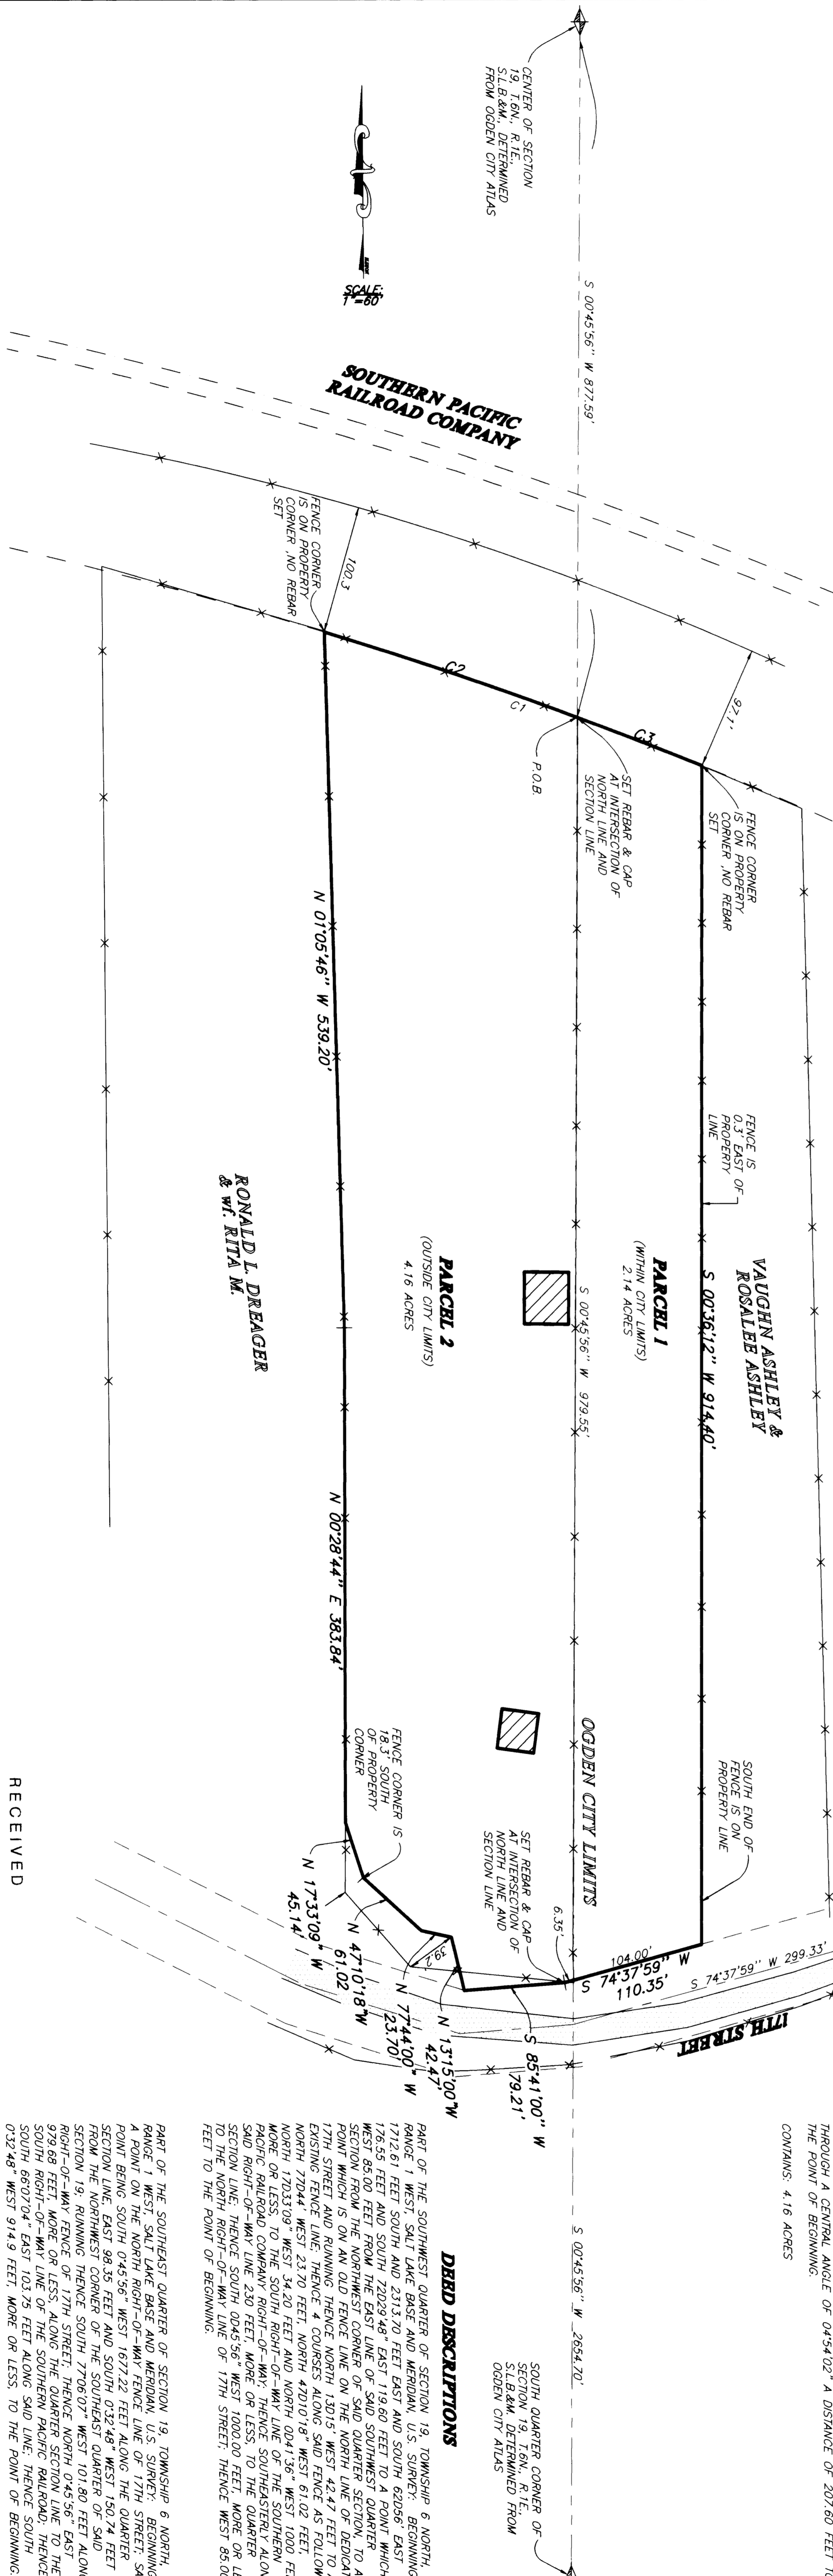

RECEIVED  
 JUN 9 3 1998  
 Weber County Surveyor


**REVISIONS**

1. \_\_\_\_\_
2. \_\_\_\_\_
3. \_\_\_\_\_
4. \_\_\_\_\_
5. \_\_\_\_\_
6. \_\_\_\_\_

PROJECT NO.: 1154-01 SURVEYOR: ARLANDER  
 DATE: 6-11-98 DRAWN: L. GREENBERG  
 SCALE: 1"=80' CHECKED: \_\_\_\_\_

**REEVE & ASSOCIATES, INC.**  
 ENGINEERING AND SURVEYING  

**RECORD OF SURVEY**

 SOUTH HALF OF SECTION 19, T.6N., R.1E., S.L.B.&M.  
 DATE: 1998

SHEET 1 OF 1 SHEETS