



SURVEYOR'S CERTIFICATE



UTAH LICENSE NUMBER

LEGEND

- SECTION CORNER
- EXISTING PAVEMENT
- EXISTING FENCE
- - - EXISTING CANAL

- REVISIONS**
- | | |
|----|--|
| 1. | |
| 2. | |
| 3. | |
| 4. | |
| 5. | |
| 6. | |



REEVE & ASSOCIATES, INC.
 ENGINEERS PLANNERS & SURVEYORS
 (801) 621-5100 FAX (801) 621-8888
 TOLL-FREE 1-888-494-5100

RECORD OF SURVEY

ROOKS PROPERTY
SOUTH HALF OF SECTION 18, T.5N., R.2W., S.18&M.

SHEET **1**
SHEETS

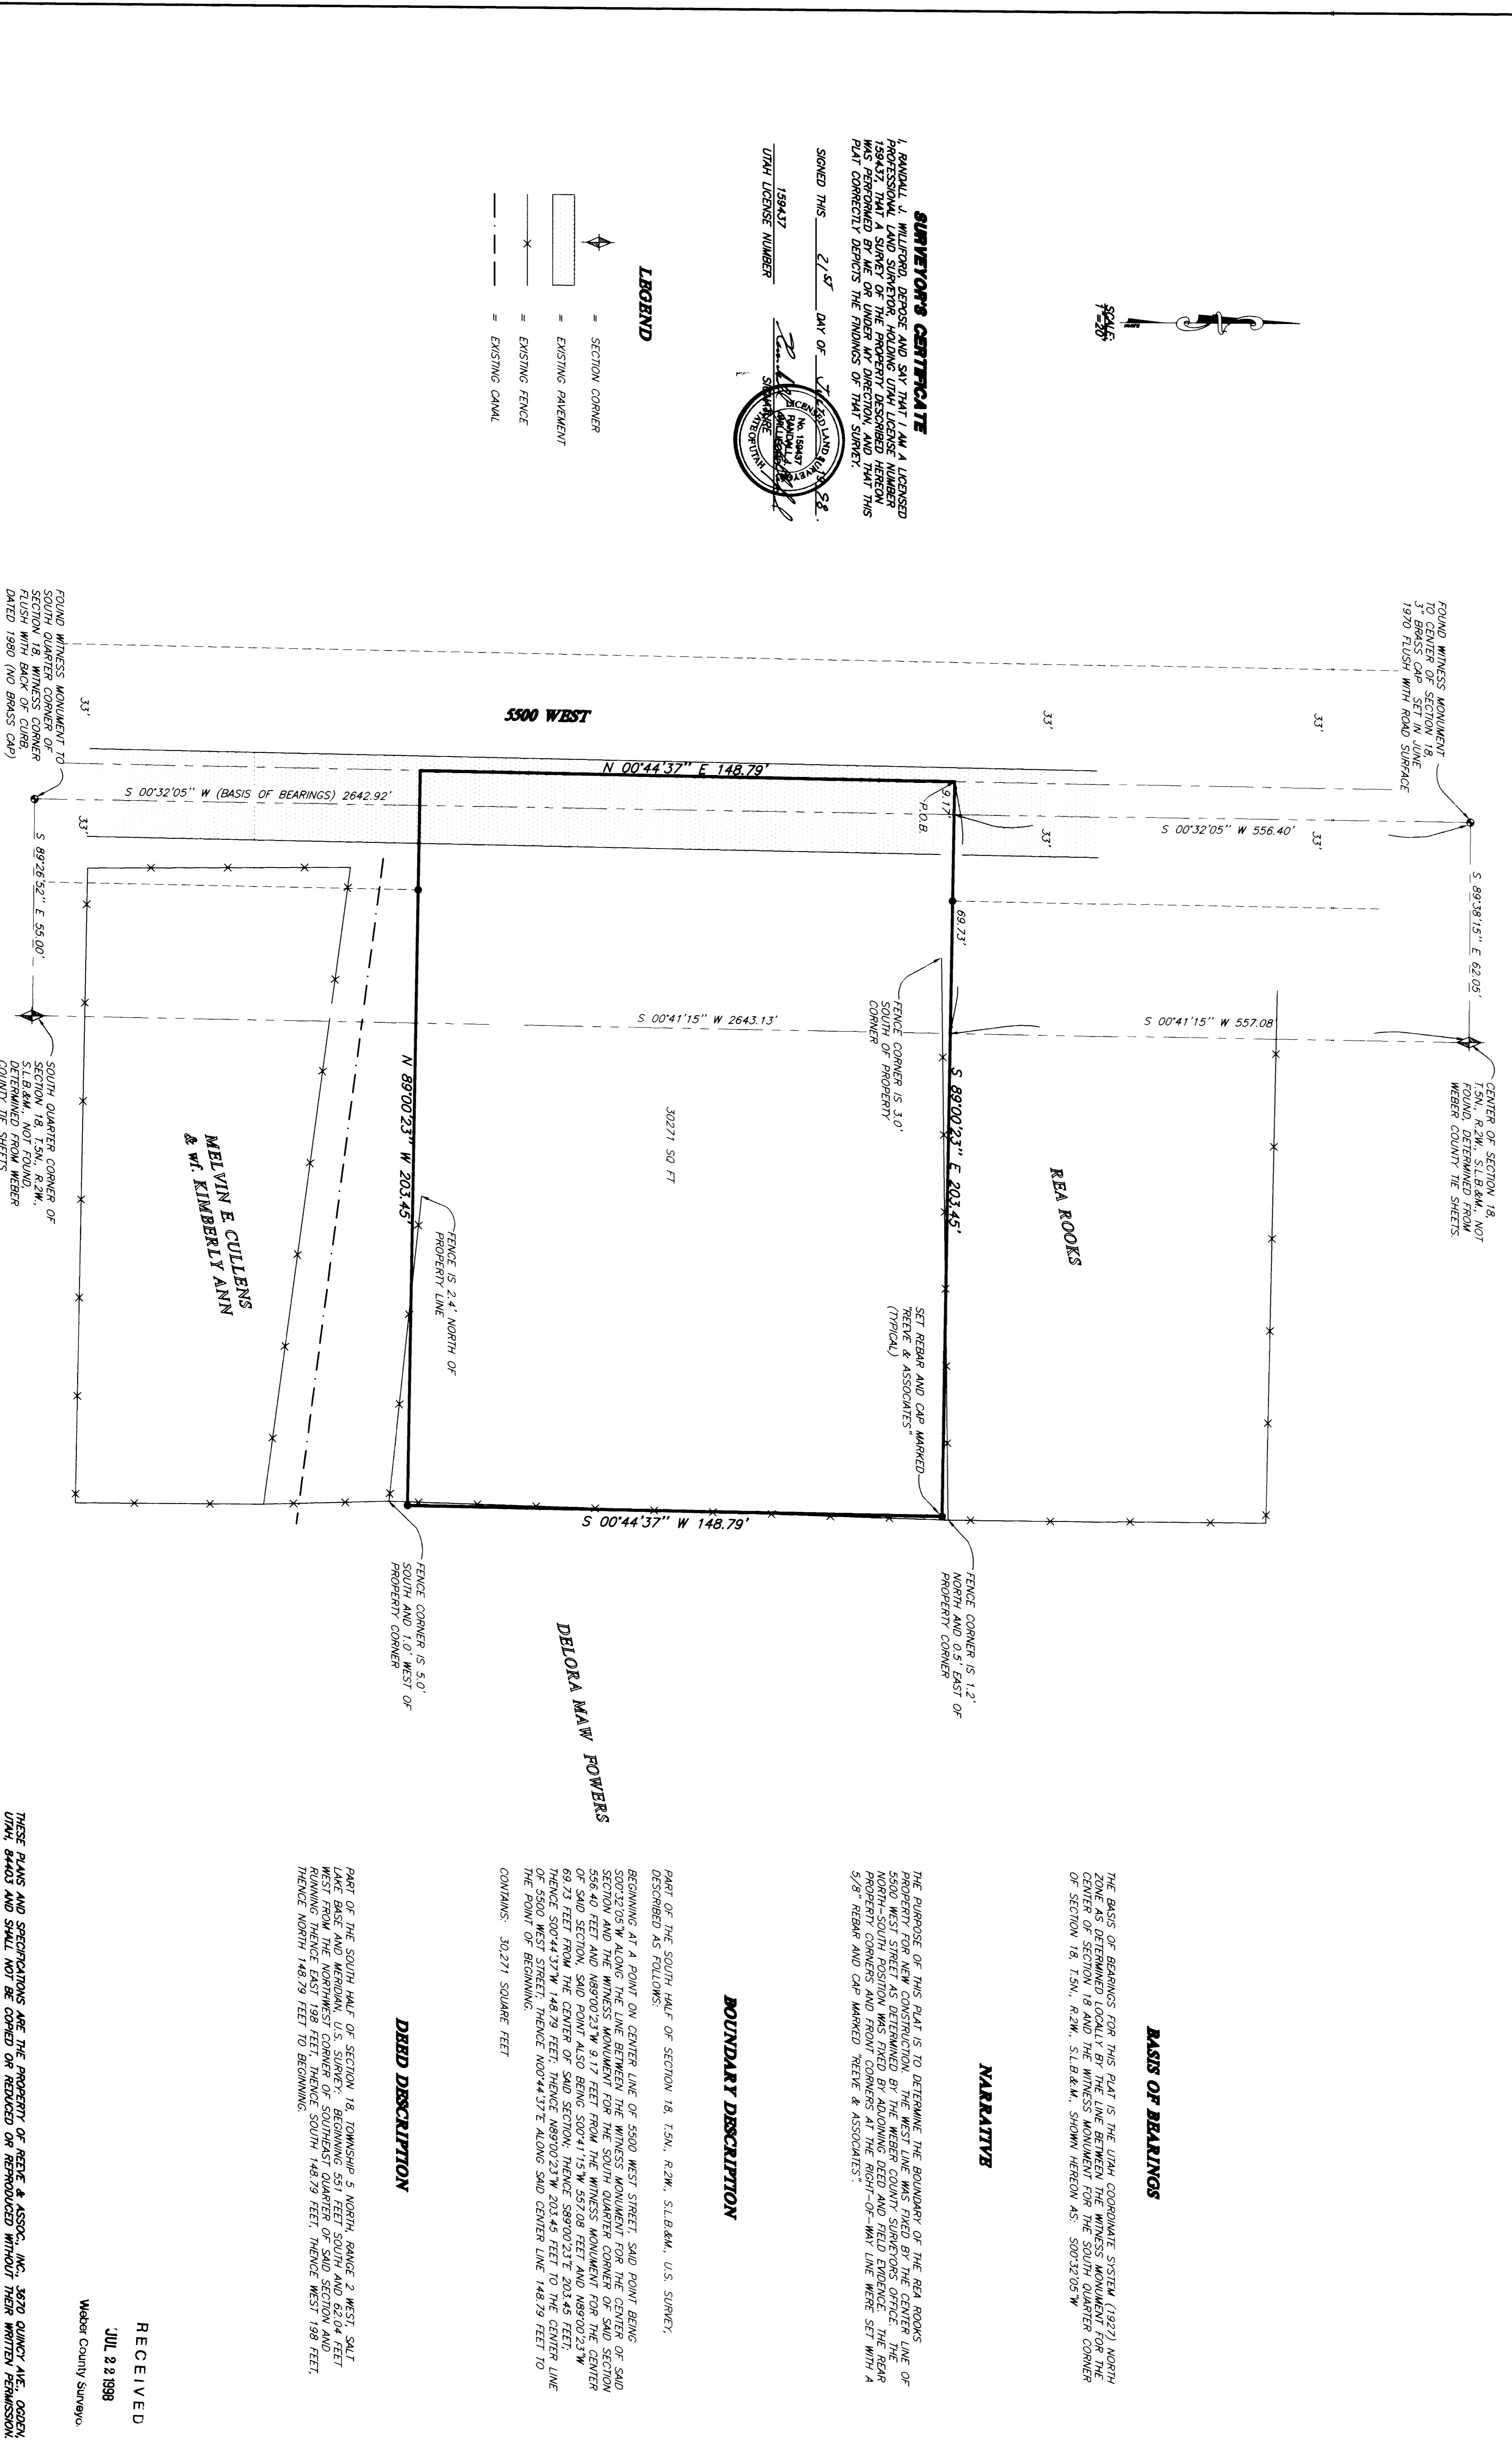

BASIS OF BEARINGS


NARRATIVE

THE PURPOSE OF THIS PLAT IS TO DETERMINE THE BOUNDARY OF THE REA ROOKS PROPERTY FOR NEW CONSTRUCTION. THE WEST LINE WAS FIRED BY THE CENTER LINE OF NORTH-SOUTH POSITION WAS FIRED BY ADJACENT DEED AND FIELD EVIDENCE. THE REAR PROPERTY CORNERS AND FRONT CORNERS AT THE RIGHT-OF-WAY LINE WERE SET WITH A 5/8\"/>

BOUNDARY DESCRIPTION

PART OF THE SOUTH HALF OF SECTION 18, T.5N., R.2W., S.18&M., U.S. SURVEY, DESCRIBED AS FOLLOWS:
 BEGINNING AT A POINT ON CENTER LINE OF 5500 WEST STREET, SAID POINT BEING S00°32'05\"/>

DEED DESCRIPTION


RECEIVED

JUL 22 1998


