

G:\DRAWINGS\SHARED\2910\01-ALTA\11a.dwg Tue Jul 21 11:21:54 1998 JACOB

REVISIONS	1.				
	2.				
	3.				
	4.				
	5.				
	6.				


PROJECT NO. 2910-01  
 DATE: 6-28-97  
 SCALE: 1"=60.0'  
 DRAWN BY: JAC  
 CHECKED BY: JAC

**REEVE & ASSOCIATES, INC.**  
 ENGINEERS PLANNERS & SURVEYORS  
 3670 QUINCY AVE. SUITE 101  
 OGDEN, UTAH 84403  
 (801) 621-3100 FAX (801) 621-2866

**ALTA IACSM SURVEY**


**W.W. GRAINGER INCORPORATED**  
 PART OF THE SOUTHWEST CORNER OF SECTION 36, T8N, R2W, S1&2 E, L.  
 OGDEN, UTAH  
 OGDEN, UTAH  
 SEPTEMBER, 1997

SHEET	1
SHEETS	1

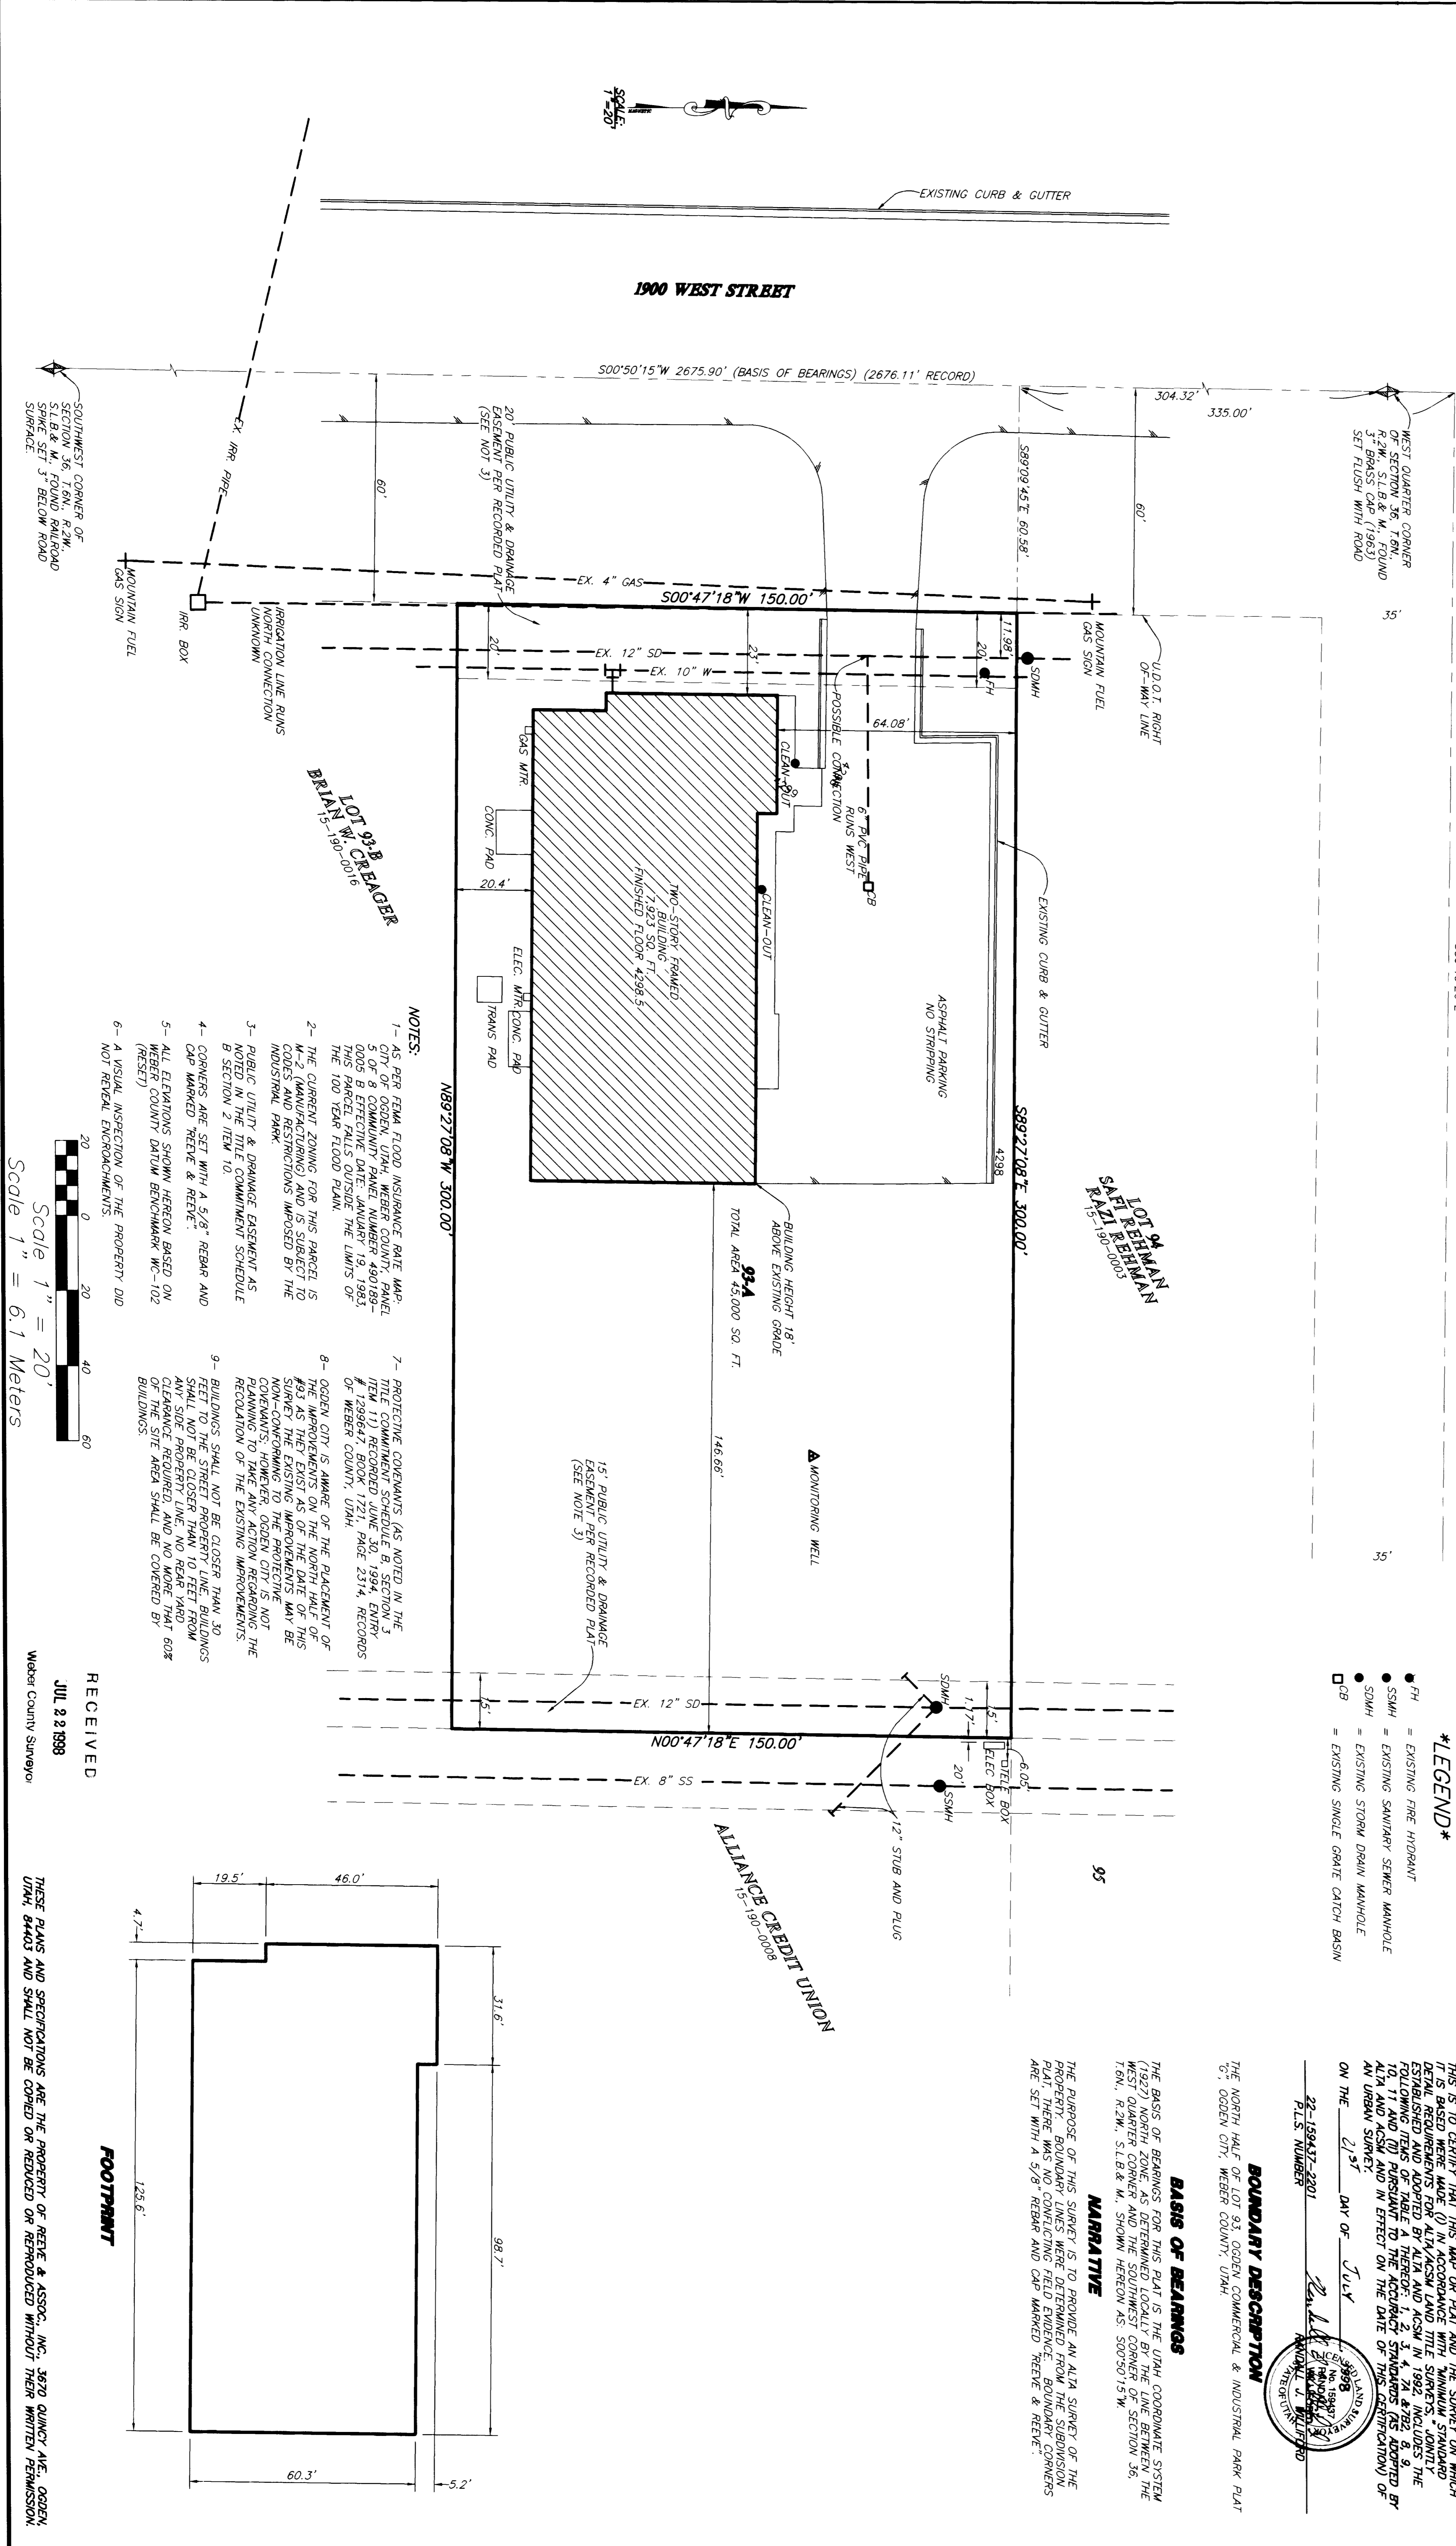

- NOTES:**
  - 2- THE CURRENT ZONING FOR THIS PARCEL IS M-2 (MANUFACTURING) AND IS SUBJECT TO CODES AND RESTRICTIONS IMPOSED BY THE INDUSTRIAL PARK.
  - 6- A VISUAL INSPECTION OF THE PROPERTY DID NOT REVEAL ENCROACHMENTS.
  - 8- OGDEN CITY IS AWARE OF THE PLACEMENT OF #33 AS THEY EXIST AS OF THE DATE OF THIS SURVEY. HOWEVER, OGDEN CITY IS NOT PLANNING TO TAKE ANY ACTION REGARDING THE RELOCATION OF THE EXISTING IMPROVEMENTS.

RECEIVED  
 JUL 28 1998  
 Weber County Surveyor

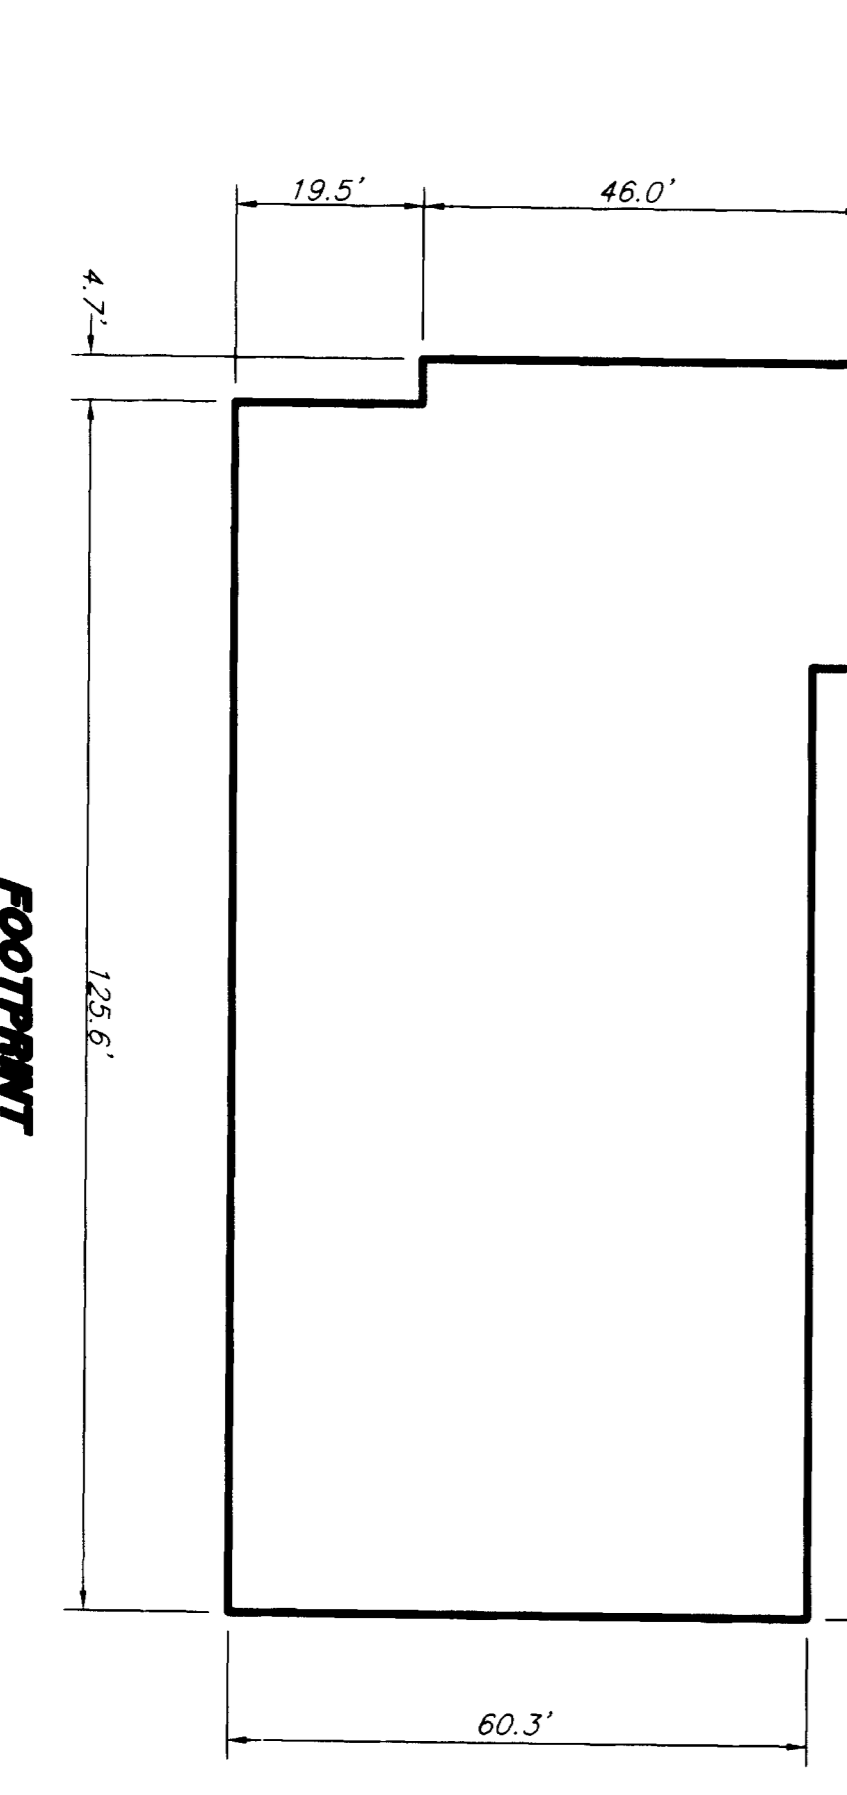

- LEGEND\***
- FH = EXISTING FIRE HYDRANT
  - SSMH = EXISTING SANITARY SEWER MANHOLE
  - SSMH = EXISTING STORM DRAIN MANHOLE
  - CCB = EXISTING SINGLE GRADE CATCH BASIN

**BASIS OF BEARINGS**  
 THE BASIS OF BEARINGS FOR THIS PLAT IS THE UTAH COORDINATE SYSTEM WEST QUARTER CORNER AND THE SOUTHWEST CORNER OF SECTION 36, T8N, R2W, S1&2 E, L. SHOWN HEREON AS 50050151W.

**NARRATIVE**  
 THE PURPOSE OF THIS SURVEY IS TO PROVIDE AN ALTA SURVEY OF THE PLAT HEREON. THERE WAS NO CONFLICTING FIELD EVIDENCE. BOUNDARY CORNERS ARE SET WITH A 5/8" REBAR AND CAP MARKED "REEVE & REEVE".

**BOUNDARY DESCRIPTION**  
 22-184317-2201  
 PLAT NUMBER  
 JULY 21 1998  
 W.W. GRAINGER INCORPORATED  
 SURVEYOR

THESE PLANS AND SPECIFICATIONS ARE THE PROPERTY OF REEVE & ASSOC., INC., 3670 QUINCY AVE., OGDEN, UTAH, 84403 AND SHALL NOT BE COPIED OR REPRODUCED WITHOUT THEIR WRITTEN PERMISSION.

Scale 1" = 20'  
 Scale 1" = 6.1 Meters

RECEIVED  
 JUL 28 1998  
 Weber County Surveyor

THESE PLANS AND SPECIFICATIONS ARE THE PROPERTY OF REEVE & ASSOC., INC., 3670 QUINCY AVE., OGDEN, UTAH, 84403 AND SHALL NOT BE COPIED OR REPRODUCED WITHOUT THEIR WRITTEN PERMISSION.

