

NUMBER	DELTA	RADIUS	LENGTH	TANGENT	CHORD	CD LENGTH
C1	10°23'21"	1209.96	219.40	110.00	S 05°11'41" W	219.10
C2	7°23'53"	20.00	25.62	14.91	N 52°31'04" W	23.90
C3	56°23'54"	50.00	31.76	14.44	S 34°01'04" E	31.23
C4	47°16'13"	200.00	165.00	97.92	S 22°31'06" E	180.36
C5	42°00'00"	50.00	42.25	28.72	S 65°31'46" W	44.52
C6	44°44'44"	20.00	25.62	14.41	N 26°18'58" W	23.90
C7	23°23'53"	20.00	25.62	14.41	S 65°31'46" W	44.52
C8	36°23'54"	50.00	31.76	14.44	N 44°48'37" W	31.23
C9	47°16'13"	200.00	165.00	97.92	N 55°56'52" W	180.36
C10	47°16'13"	229.31	239.31	120.00	N 15°36'09" E	238.97
C11	12°09'56"	692.58	146.98	73.77	N 82°51'57" W	146.71

CURVE DATA

BOUNDARY DESCRIPTION

A PORTION OF THE "PATIO SPRINGS UNIT NO. 1" SUBDIVISION, EDEEN DISTRICT, WEBER COUNTY, UTAH, DESCRIBED AS FOLLOWS:
ALL OF LOT 110, ALL OF LOT 96, AND ALL OF LOT 64

MARRATIVE

THE PURPOSE OF THIS SURVEY IS TO DETERMINE THE BOUNDARY OF LOTS 64 FOR RANBY GERARD, 96 FOR WAYNE WILSON, AND 110 FOR BRUCE BAILEY. EACH BOUNDARY CORNER WAS MONUMENTED BY A 3/8" REBAR AND CAP MARKED "REVE & REVE". STREET MONUMENTS WERE LOCATED AS SHOWN HEREON, AS SET BY WEBER COUNTY AND USED FOR ALL CONTROL.

BASIS OF BEARING

THE BASIS OF BEARING FOR THIS SURVEY IS THE "PATIO SPRINGS UNIT NO. 1 SUBDIVISION" MONUMENT SYSTEM, AS DETERMINED LOCALLY BY THE LINE BETWEEN THE FOUND MONUMENTS AT THE INTERSECTION OF PARKWAY LANE AND HANDICAP ROAD AND THE P.I. MONUMENT ON SAID HANDICAP ROAD SHOWN HEREON AS: 169°13'00"W


- * LEGEND *
- = FOUND CENTER LINE MONUMENTS AS NOTED HEREON
- = SET 4/8" REBAR & CAP MARKED "REVE & REVE" UNLESS OTHERWISE NOTED HEREON

RECEIVED
JUL 22 1998
Weber County Surveyor

SURVEYORS CERTIFICATE


SIGNED THIS 21ST DAY OF July 1998
159437
UTAH LICENSE NUMBER

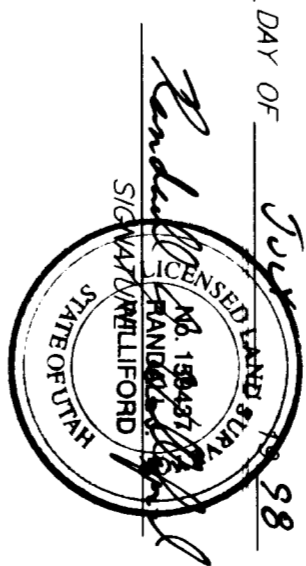

REVISIONS

1		4
2		5
3		6

PROJECT NO. 2286-01, 2287-01, 2288-01
DATE: APRIL 7, 1997
SCALE: 1"=80'
RESPOND: N
CHECKED: N

REEVE & REEVE, INC.
ENGINEERS PLANNERS & SURVEYORS
1000 QUINCY AVE. SUITE 101
COURT SQUARE
(801) 621-3100 FAX (801) 621-2666

RECORD OF SURVEY

PART OF PATIO SPRINGS
UNIT NUMBER 1
A PART OF THE SW 1/4 OF SECTION 22 AND THE SE 1/4 OF SECTION 21,
EDEEN DISTRICT, WEBER COUNTY, UTAH
MAY, 1993

SHEET 1
SHEETS