


**SUPERVISORS CERTIFICATE**

I, RANDALL J. WILFORD, DEPOSE AND SAY THAT I AM A LICENSED PROFESSIONAL LAND SURVEYOR, HOLDING UTAH LICENSE NUMBER 150417, AND THAT THE SURVEY AND PLAT HEREON WERE PERFORMED BY ME OR UNDER MY DIRECTION, AND THAT THIS PLAT CORRECTLY DEPICTS THE FINDINGS OF THAT SURVEY.

SIGNED THIS 20<sup>TH</sup> DAY OF \_\_\_\_\_ 19 92.

150417  
UTAH LICENSE NUMBER


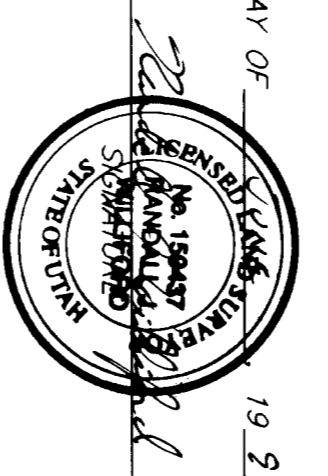


**\* LEGEND \***

▬ = EXISTING BUILDING

—x— = EXISTING FENCE LINE

○ = SET 5/8" REBAR AND CAP MARKED REVEE & REVEE

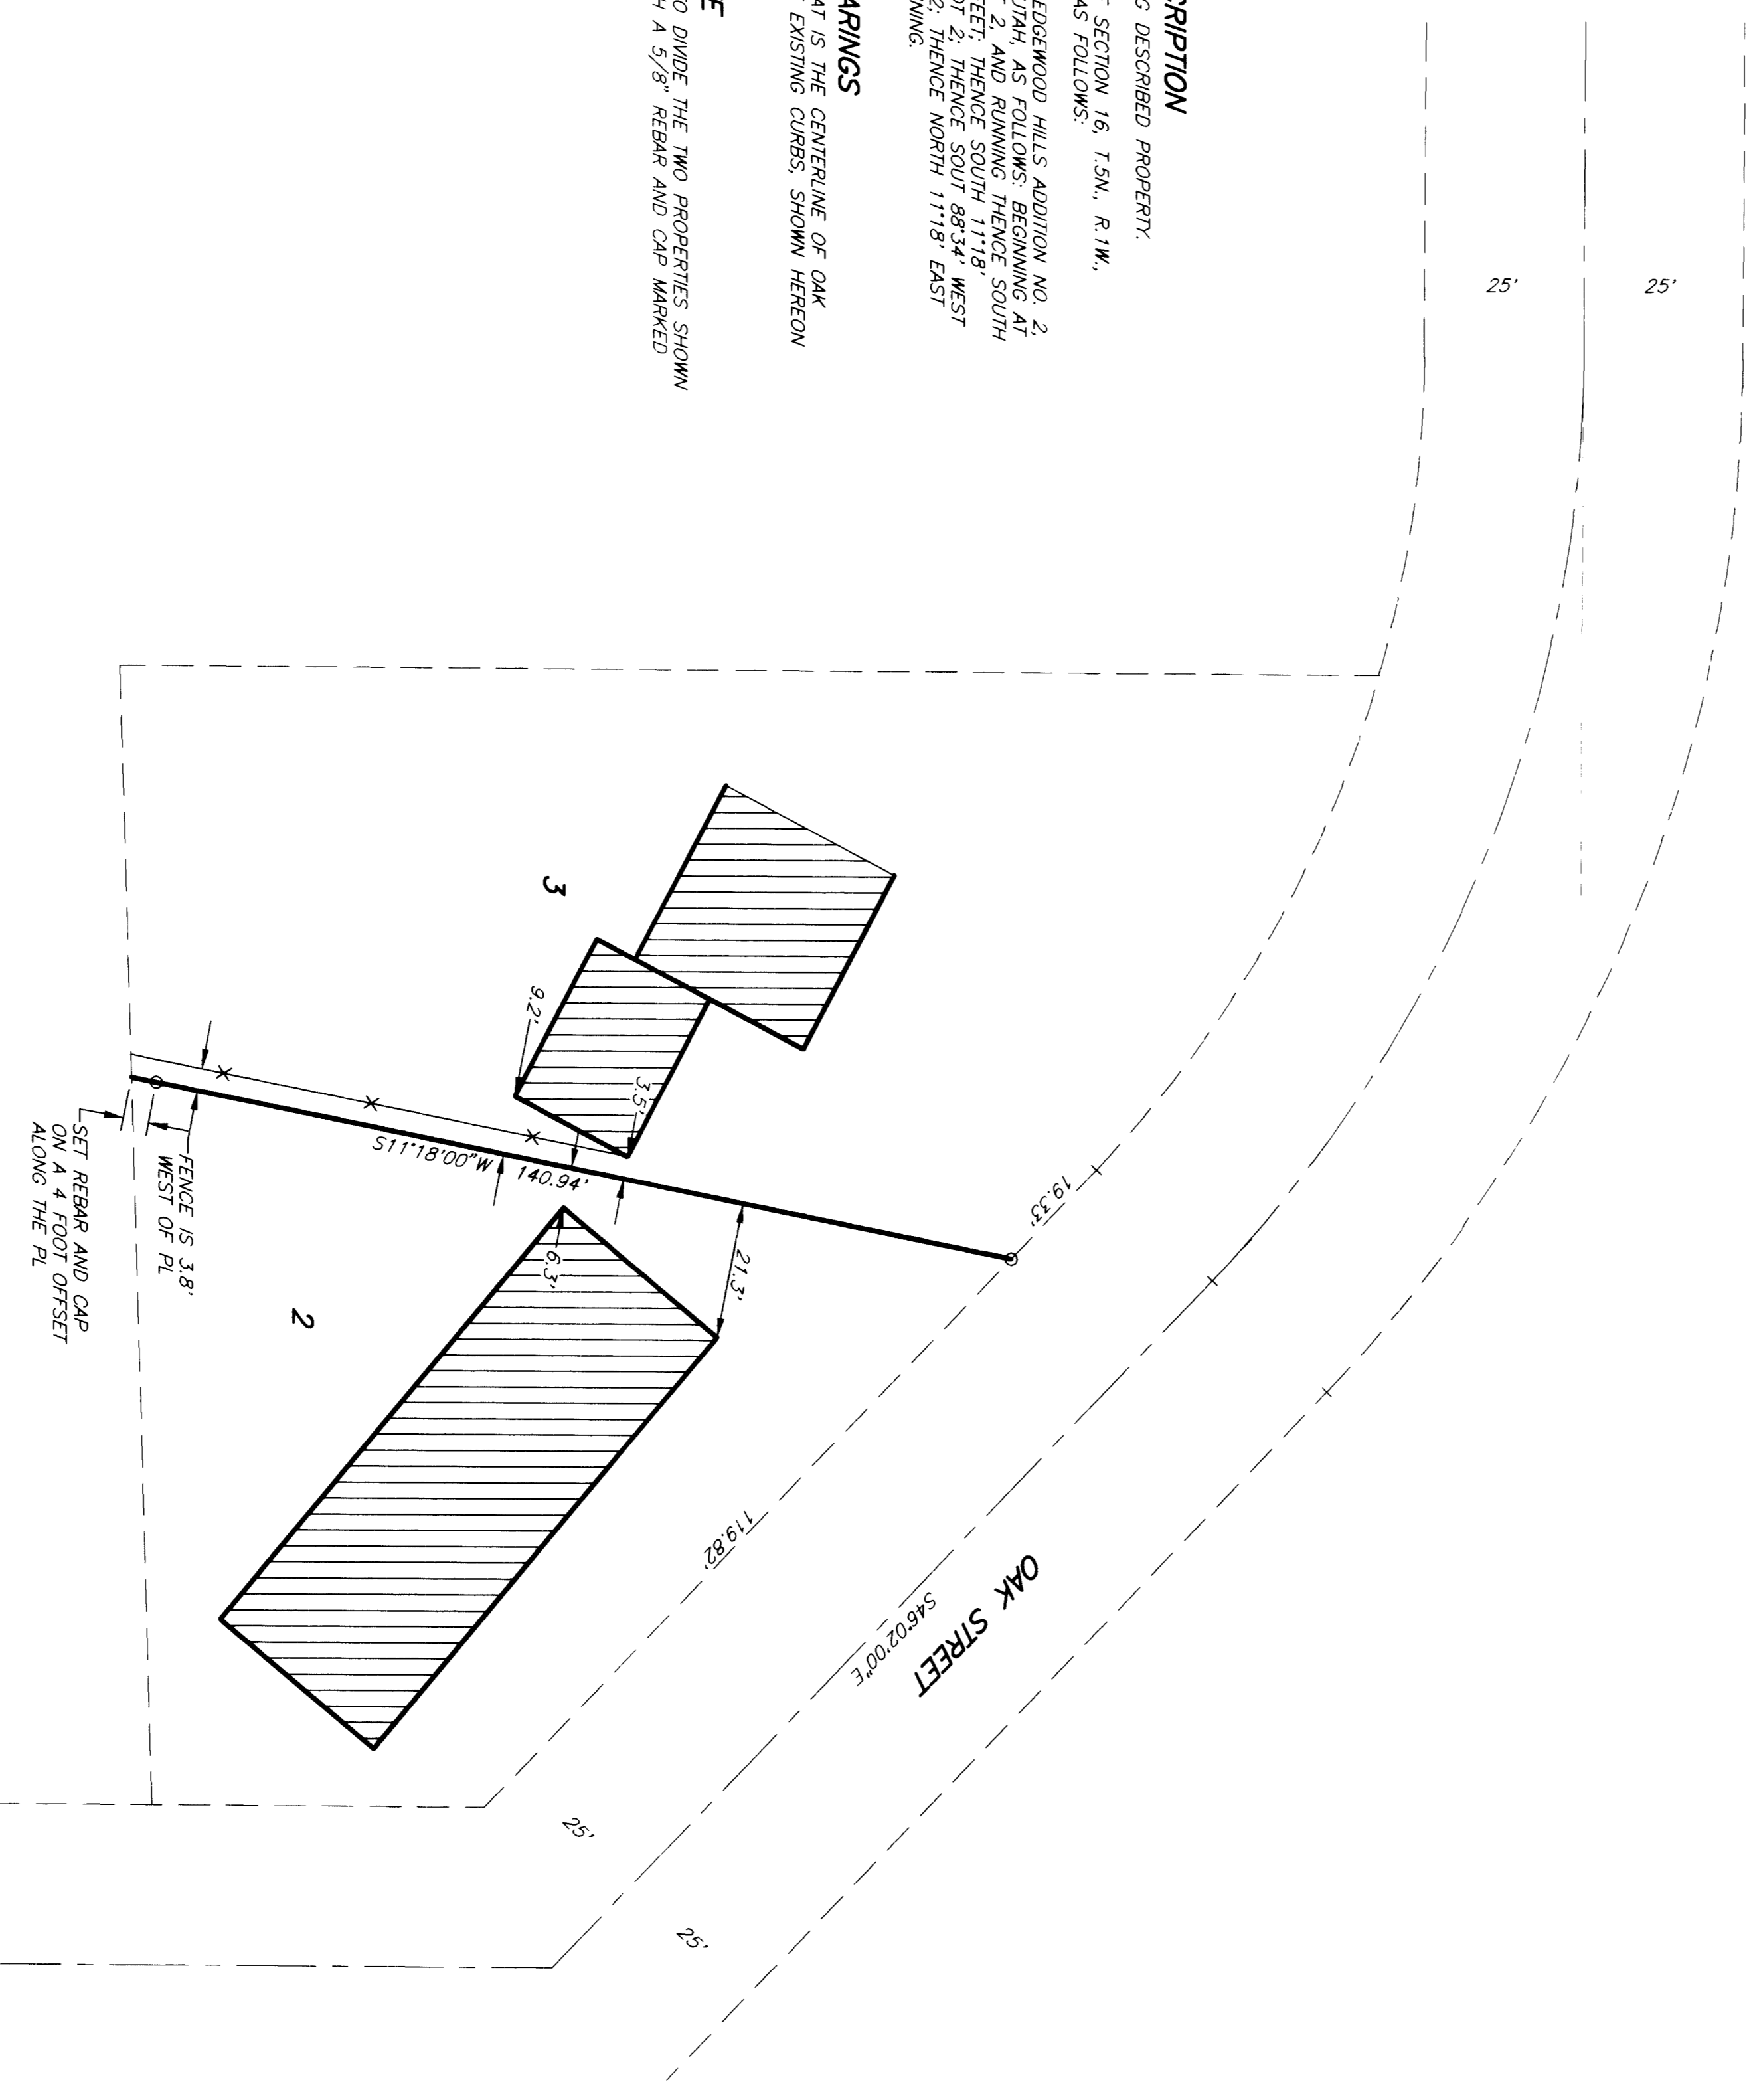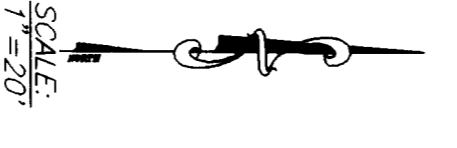

**BOUNDARY DESCRIPTION**

THE EASTERLY LINE OF THE FOLLOWING DESCRIBED PROPERTY, PART OF THE NORTHEAST QUARTER OF SECTION 16, T.5N., R.1W., S.L.B. & M., U.S. SURVEY, DESCRIBED AS FOLLOWS:


**BASIS OF BEARINGS**

THE BASIS OF BEARINGS FOR THIS PLAT IS THE CENTERLINE OF OAK STREET AS DETERMINED BY SPLITTING THE EXISTING CURBS, SHOWN HEREON AS SHADOWS.

**MARRATIVE**


RECEIVED  
JUL 2 8 1998  
Weber County Surveyor

REVISIONS

1	4
2	5
3	6

PROJECT NO. 2827-81  
DATE 1-2-92  
SCALE 1"=20'

SUPERVISOR: R. WILFORD  
DRAWN: JAE  
CHECKED:

**REEVE & ASSOCIATES, INC.**  
ENGINEERS, PLANNERS & SURVEYORS  
3670 QUINCY AVE. SUITE NO. 1  
OGDEN, UTAH 84401 (801) 621-2868

RECORD OF SURVEY

EDGEWOOD HILLS LOTS 2 & 3  
A PART OF THE NE 1/4 OF SECTION 16, T.5N. & THE S.E. 1/4 OF SECTION 17, S.17E. & M., U.S. SURVEY  
SCALE 1"=20'

SHEET 1 OF 1  
SHEETS