

NORTH QUARTER CORNER OF SECTION 13, T.6N., R.1E., S.L.B.M., FOUND BLM MONUMENT 1' ABOVE GROUND

NORTH QUARTER CORNER OF SECTION 18, T.6N., R.2E., S.L.B.M., FOUND 3" WEBER COUNTY MONUMENT

**BASES OF BEARINGS**



**NARRATIVE**



**SURVEYED DESCRIPTION**



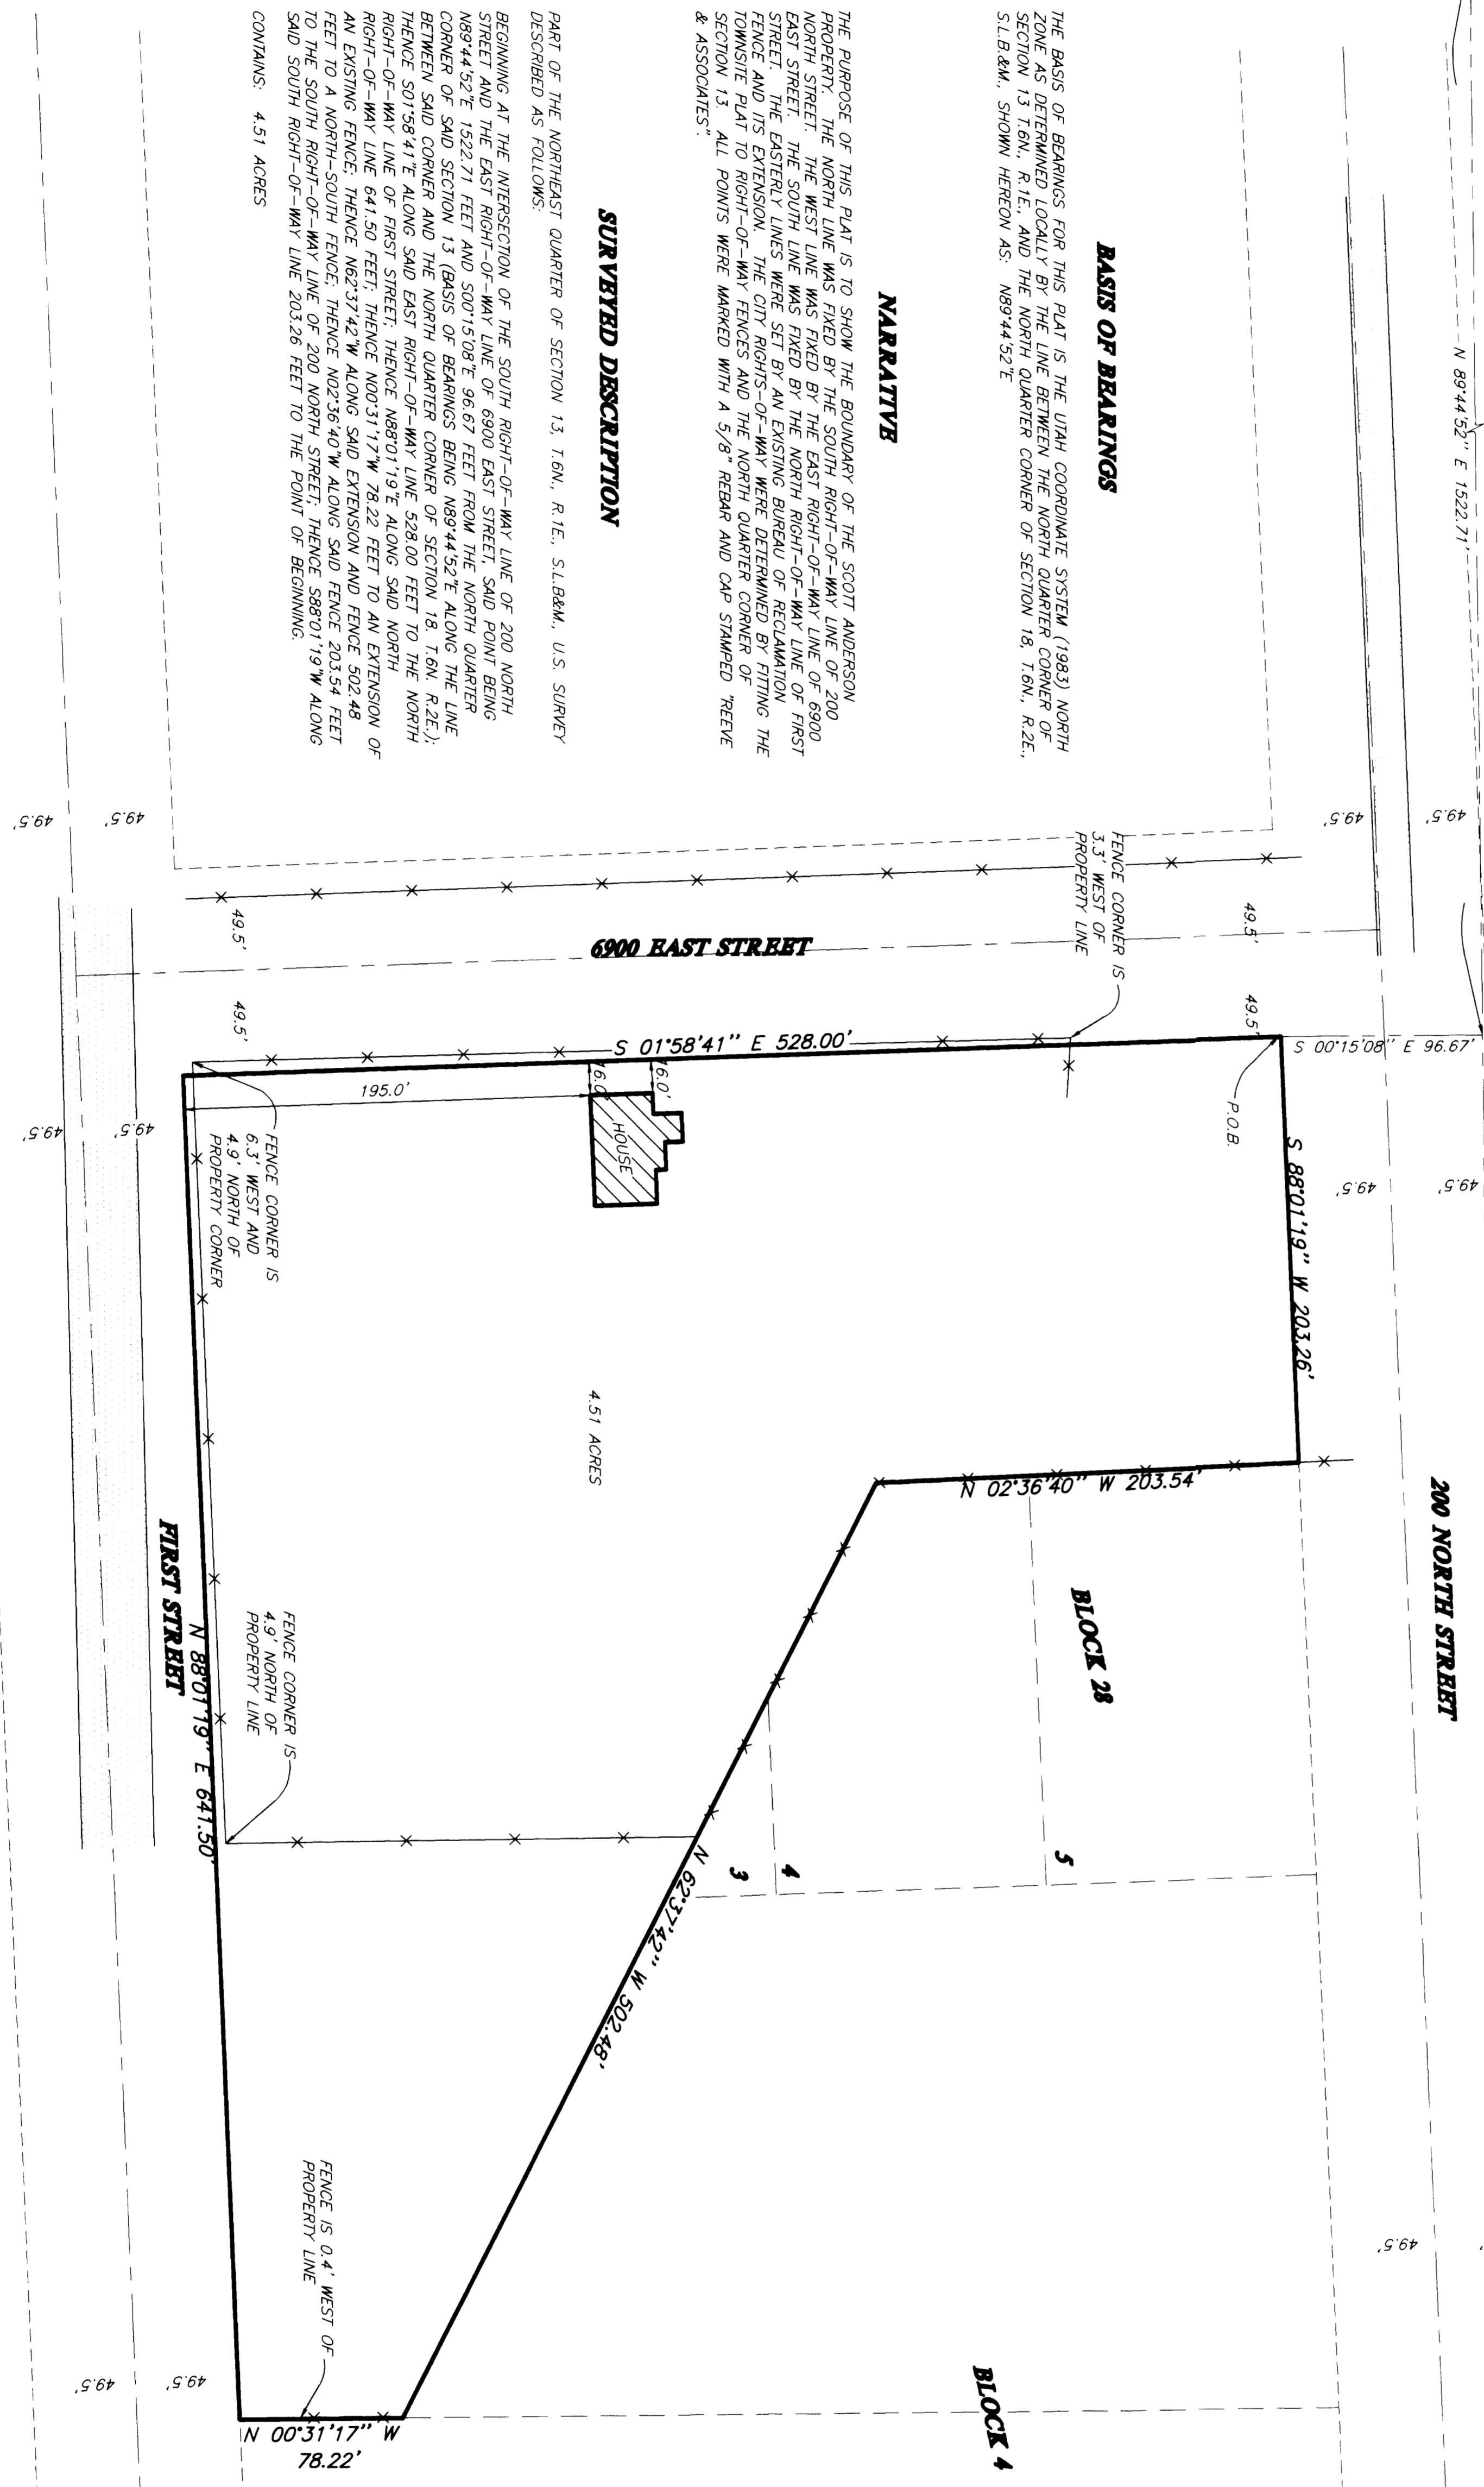

**SURVEYOR'S CERTIFICATE**

I, RANDALL J. WILFONG, DEPOSE AND SAY THAT I AM A LICENSED SURVEYOR IN THE STATE OF UTAH AND THAT I HAVE PERSONALLY AND INDEPENDENTLY CONDUCTED THE SURVEY AND THAT THE PLAT CORRECTLY REFLECTS THE FINDINGS OF THAT SURVEY.

SIGNED THIS 22<sup>ND</sup> DAY OF SEPTEMBER 1998.  
158437  
UTAH LICENSE NUMBER  
[Signature]  
[Signature]



**LEGEND**

- +— SECTION CORNER
- x— EXISTING FENCE LINE
- EXISTING PAVEMENT
- ▨— EXISTING BUILDING

RECEIVED  
JUL 23 1998  
Weber County Surveyor

THESE PLANS AND SPECIFICATIONS ARE THE PROPERTY OF REEVE & ASSOC., INC., 3670 QUINCY AVE., OGDEN, UTAH. REBARS AND SHALL NOT BE COPIED OR REDUCED OR REPRODUCED WITHOUT THEIR WRITTEN PERMISSION.

**ANDERSON PROPERTY**  
PART OF THE NORTHEAST QUARTER OF SECTION 13, T.6N., R.1E., S.L.B.M., HAINSFIELD, WEBER COUNTY, UTAH, 1998

**RECORD OF SURVEY**

**REEVE & ASSOCIATES, INC.**  
ENGINEERS, PLANNERS & SURVEYORS  
3670 QUINCY AVE., SUITE NO. 1  
OGDEN, UTAH 84403  
(801) 657-5100 FAX (801) 621-2866  
TOLL-FREE 1-888-494-5100

PROJECT NO.: 98-021  
DATE: 7-15-98  
SCALE: 1"=50'  
DRAWN BY: K. BECKER  
CHECKED BY: [Signature]

REVISIONS  
1. \_\_\_\_\_  
2. \_\_\_\_\_  
3. \_\_\_\_\_  
4. \_\_\_\_\_  
5. \_\_\_\_\_  
6. \_\_\_\_\_