

1.	REVISIONS
2.	
3.	
4.	
5.	
6.	

PROJECT NO.	JUL-91	DATE	7-2-98
DRAWN BY	L.C.H.	CHECKED BY	L.C.H.
OWNER	K. GOSWAMI	APPROVED BY	


**REEVE & ASSOCIATES, INC.**  
 3670 QUINCY AVE. SUITE 101  

**RECORD OF SURVEY**

**LOT 52, OLYMPIUS HEIGHTS SUBDIVISION**  
 PART OF THE NORTHWEST QUARTER OF SECTION 27 T.6N. R.1W. S.B.M., POSITION DETERMINED BY SURVEY OF 1841, 1989

SHEET	1
SHEETS	1

RECEIVED  
 JUL 9 3 1998  
 WEBER COUNTY SURVEYOR

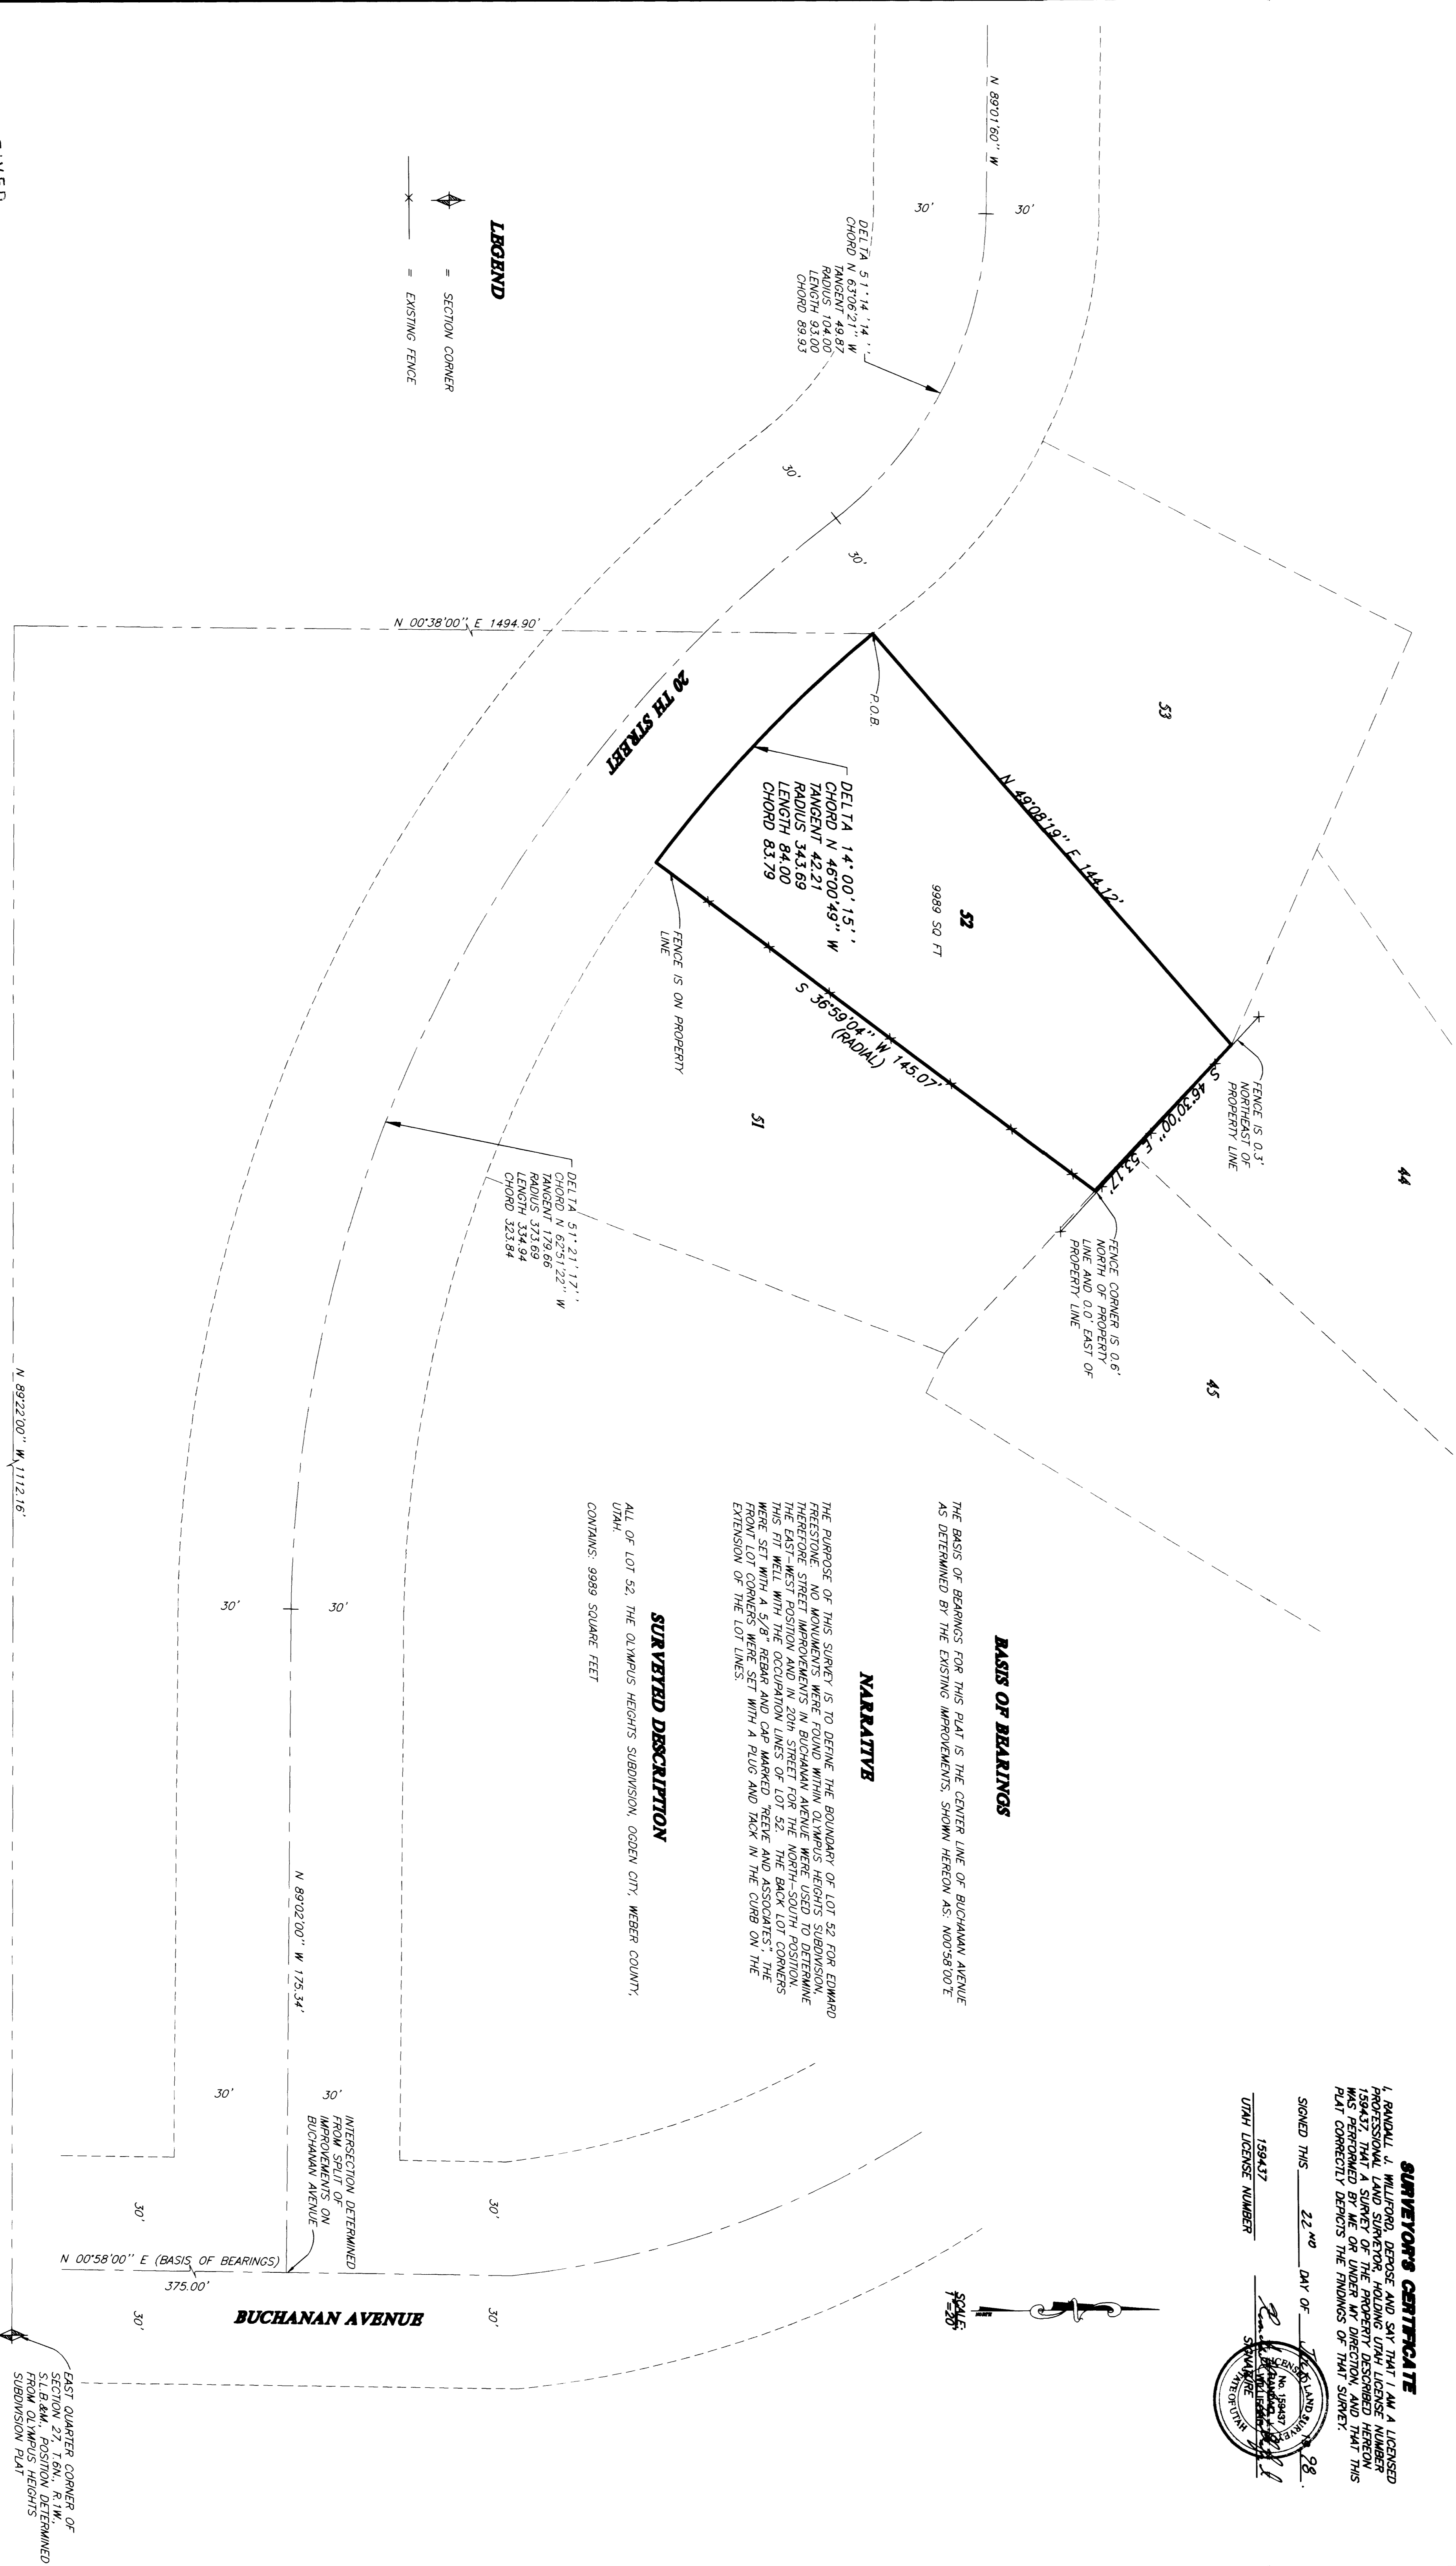

**NARRATIVE**  


**SURVEYED DESCRIPTION**  
 ALL OF LOT 52, THE OLYMPIUS HEIGHTS SUBDIVISION, OGDEN CITY, WEBER COUNTY, UTAH.  
 CONTAINS: 9989 SQUARE FEET

**BASIS OF BEARINGS**  
 THE BASIS OF BEARINGS FOR THIS PLAT IS THE CENTER LINE OF BUCHANAN AVENUE AS DETERMINED BY THE EXISTING IMPROVEMENTS SHOWN HEREON AS: N00°58'00"E

**SURVEYOR'S CERTIFICATE**  
 SIGNED THIS 22nd DAY OF JULY 1998.  
 RANDALL J. WILLIFORD  
 SURVEYOR

THESE PLANS AND SPECIFICATIONS ARE THE PROPERTY OF REEVE & ASSOC., INC., 3670 QUINCY AVE., OGDEN, UTAH. PLANS AND SPECIFICATIONS SHALL NOT BE COPIED OR REPRODUCED OR REPRODUCED WITHOUT THEIR WRITTEN PERMISSION.