


000205

000205

000205

000205

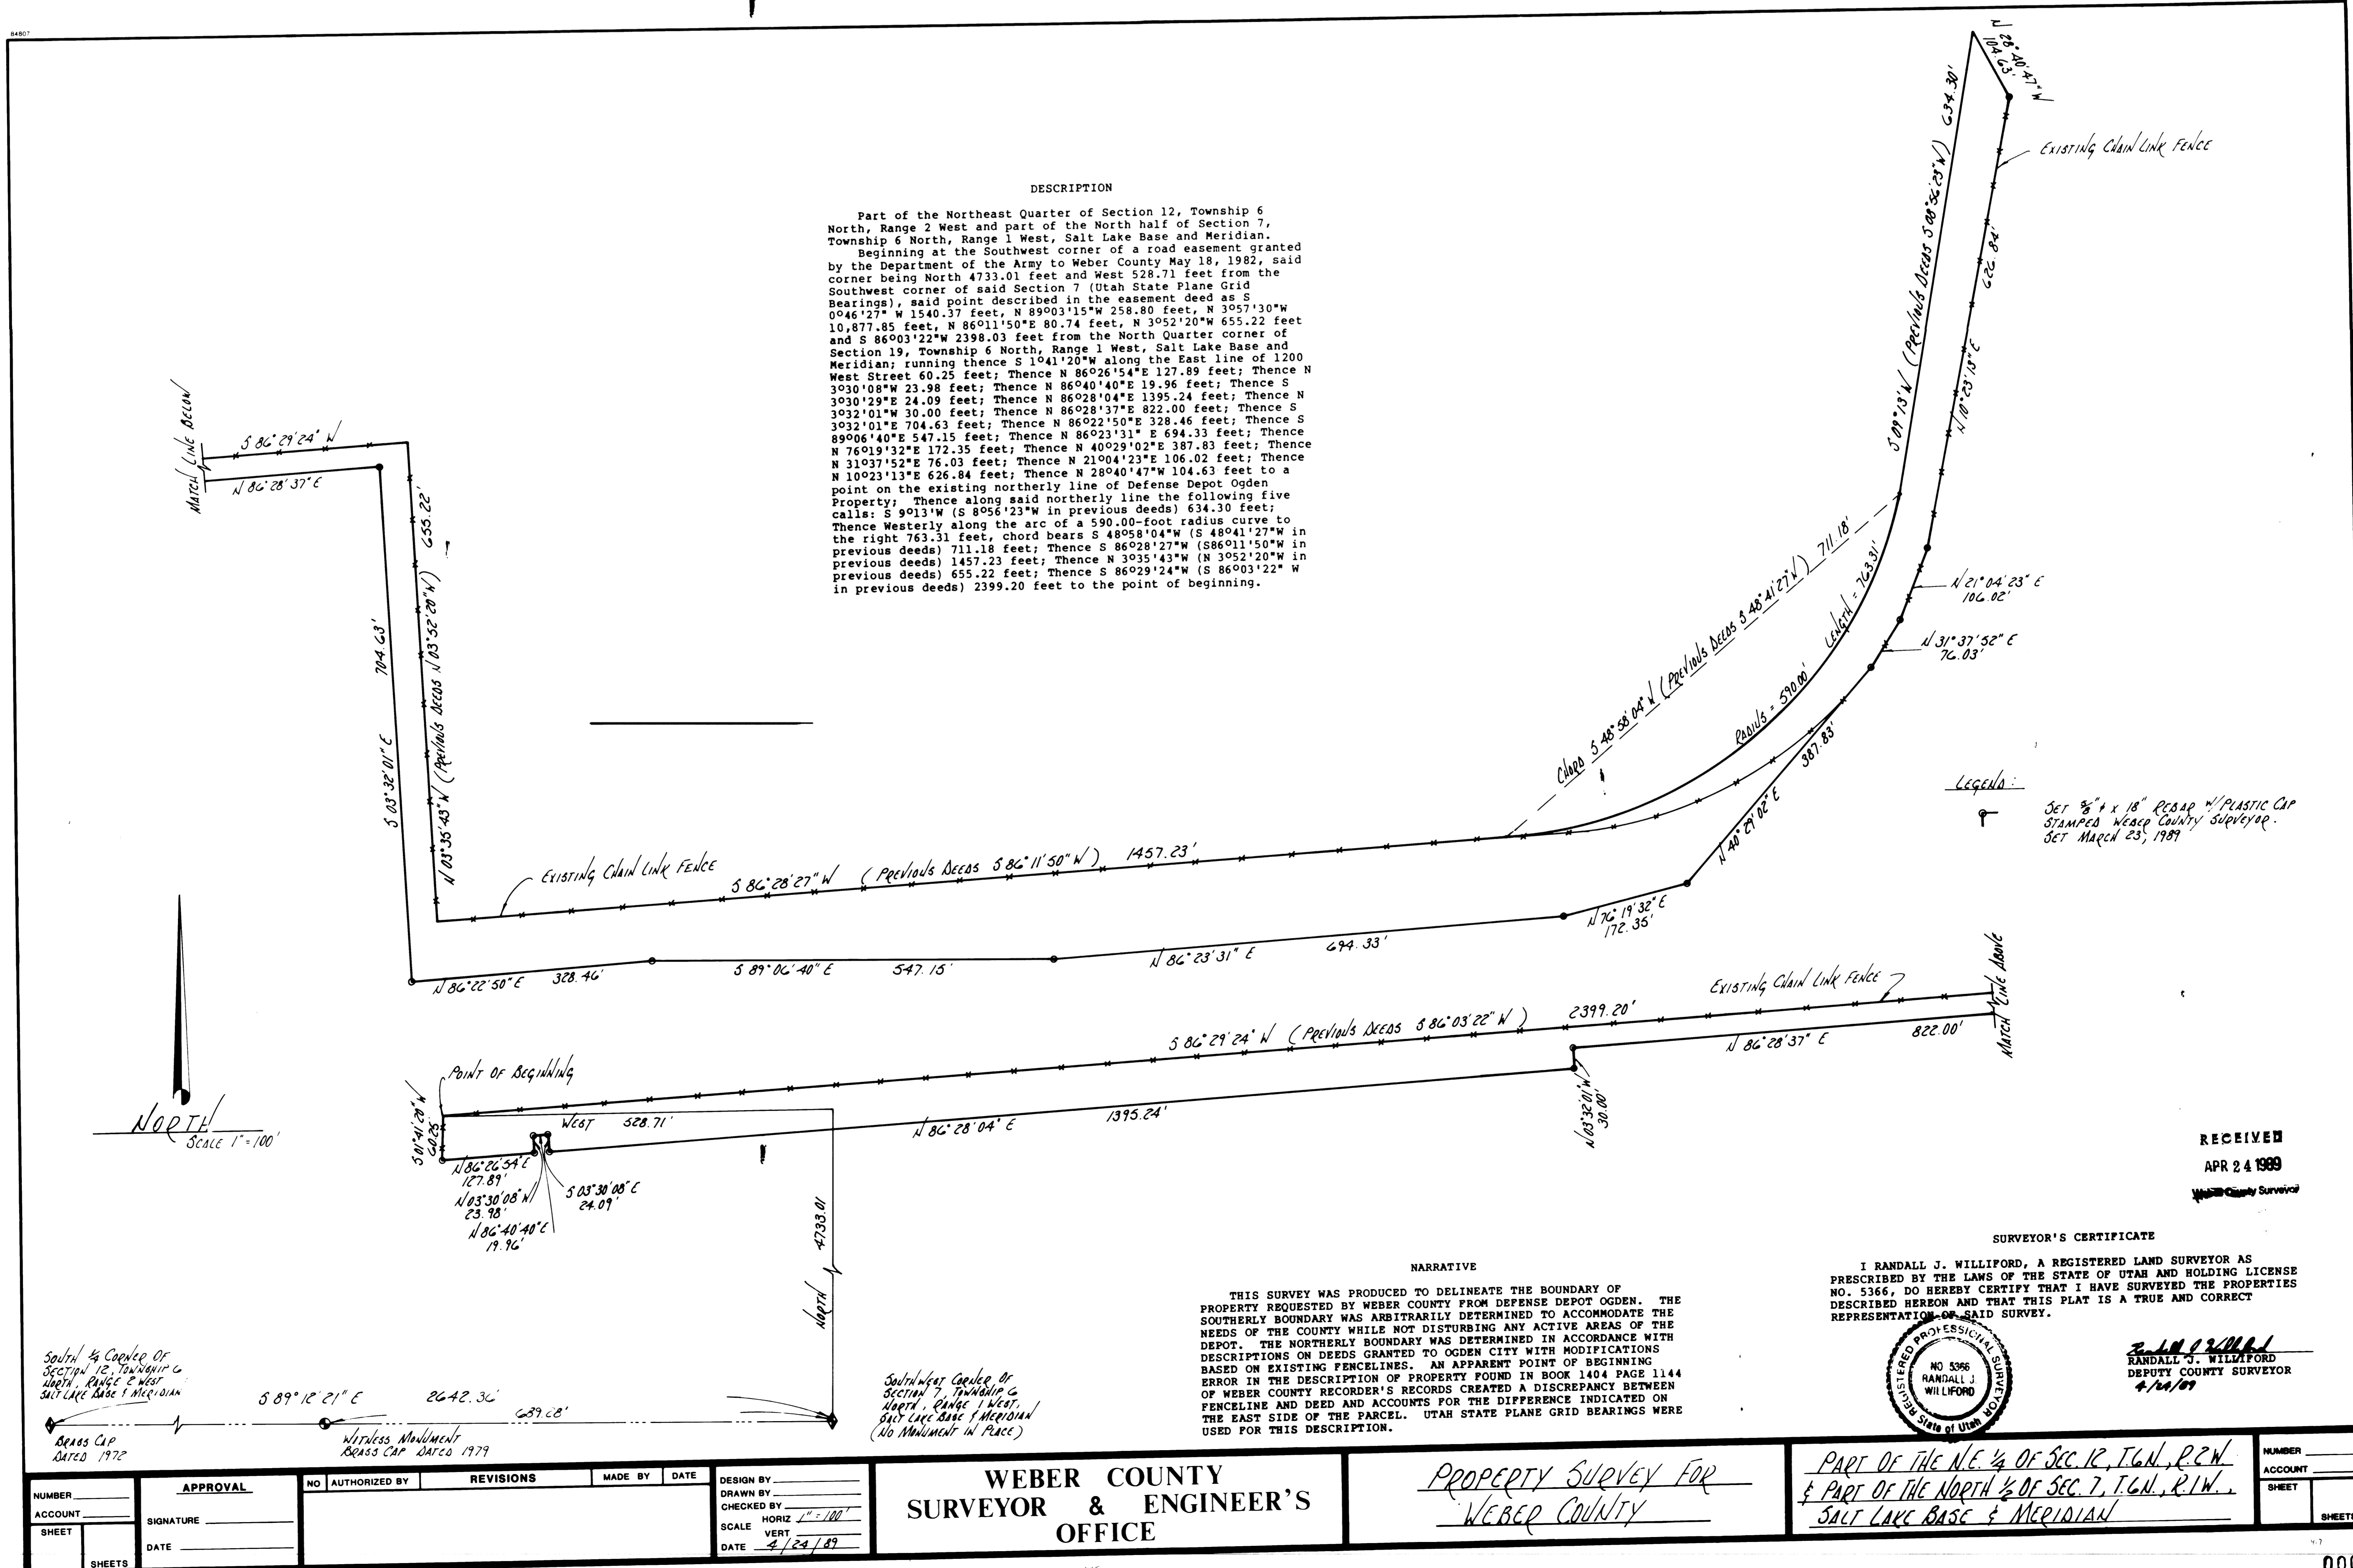

000205