

ROUND OGDEN CITY MONUMENT
2300 SOUTH

ROUND OGDEN CITY MONUMENT
MONROE STREET &
ROAD OF SERVICE
(ELEV=4380.31)

2300 SOUTH STREET

BLOCK 9, PLAT B



BASE OF BEARING
N 77°10' (R)
771.40 (R)

ROUND OGDEN CITY MONUMENT
DANBY STREET &
2300 SOUTH

DATE: FEBRUARY 21, 1997


CERTIFICATE OF SURVEY
I, A RONALD JOHANSSON, REGISTERED LAND SURVEYOR, STATE OF UTAH, LICENSE NUMBER 291970, CERTIFY THAT I HAVE SUPERVISED A SURVEY ON THE GROUND AS SHOWN HEREON.

R. RONALD JOHANSSON, L.S.

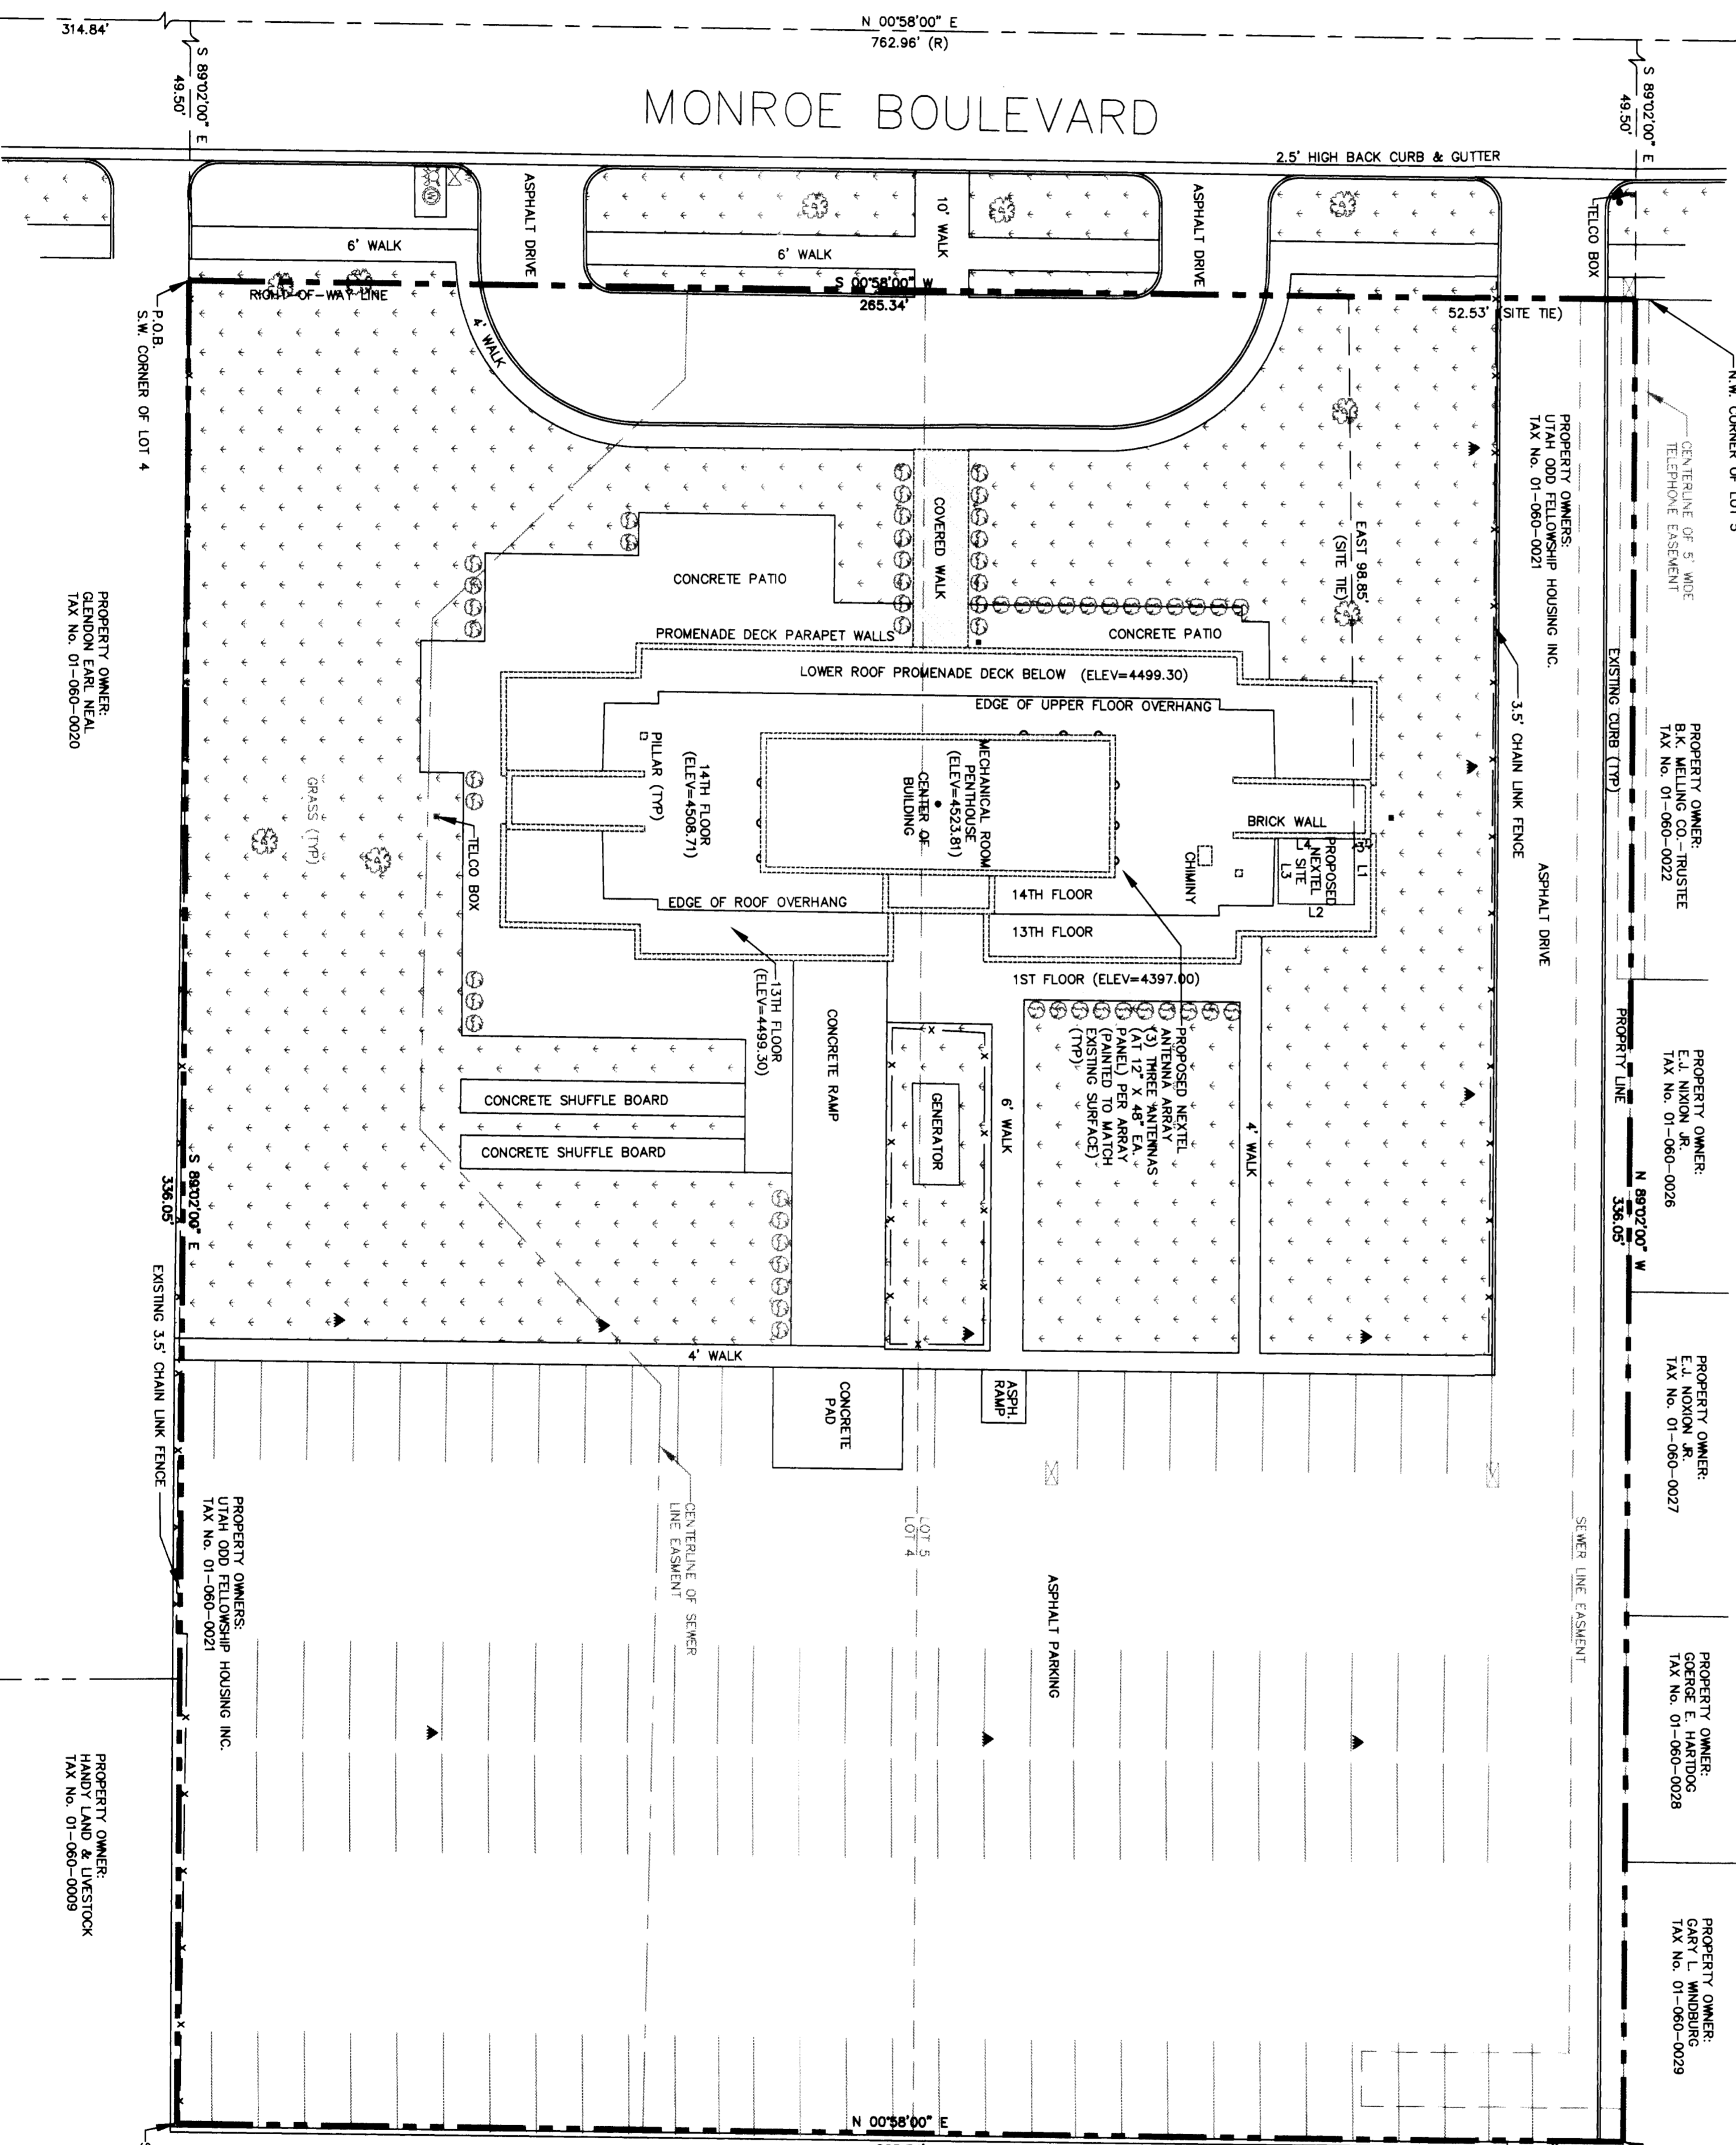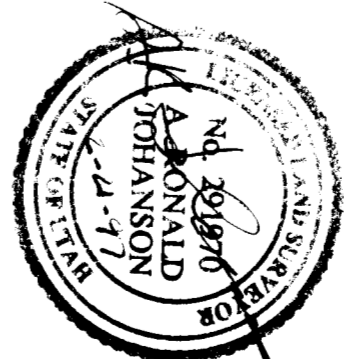

LINE	DIRECTION	DISTANCE
L1	S 89°22'00" E	12.00'
L2	S 00°33'15" W	14.00'
L3	N 89°28'45" W	12.00'
L4	N 00°33'15" E	14.00'


RECEIVED
SEP 18 1998
Weber County Survey.

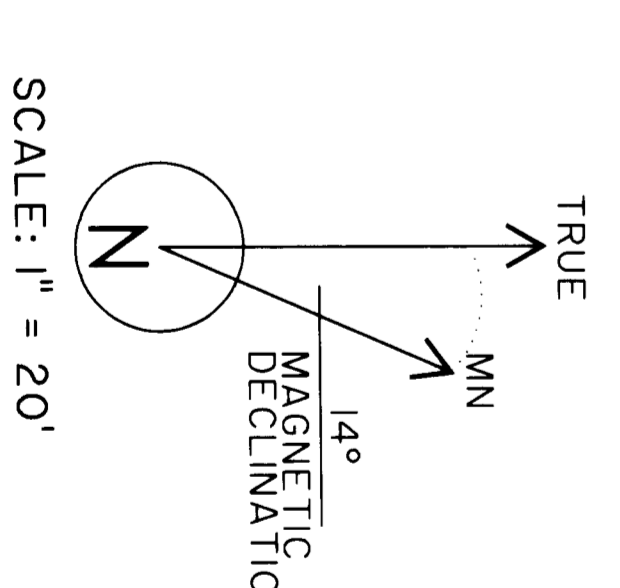

PROPOSED SITE DESCRIPTION:
BEGINNING AT A POINT ON A WALL ON A BUILDING ROOF SOUTH ORSPORF WEST 52.53' AND EAST 68.45 FEET FROM THE NORTHWEST CORNER OF LOT 5, SAID CORNER OF LOT 5, BEING NORTH 00°58'00" EAST 314.84 FEET AND SOUTH 89°22'00" EAST 49.50 FEET AND NORTH 00°58'00" WEST 265.34 FEET RUNNING THENCE SOUTH 89°28'45" EAST 12.00 FEET; THENCE SOUTH 00°33'15" WEST 14.00 FEET TO A POINT ON ABOVE SAID WALL; THENCE NORTH 89°28'45" WEST 14.00 FEET TO A WALL AND POINT OF BEGINNING.
CONTAINS: 0.004 ACRES (AS DESCRIBED)

NARRATIVE:
1. THE PURPOSE OF THIS SURVEY IS TO LOCATE AND SURVEY A PROPOSED COMMUNICATIONS TOWER SITE.
2. THE BASIS OF BEARING USED FOR THIS SURVEY IS AS SHOWN ON THIS PLAN, FROM FOUND MONUMENTS AS LOCATED IN THE FIELD.
(R) = RECORDED DISTANCE (RECORDED SURVEY)
(M) = MEASURED DISTANCE (RECORD) (THE REPORT ETC.)
(GND) = STATE PLANE COORDINATES (COUNTY SURVEYORS OFFICE) LONGITUDE.

LEGEND:

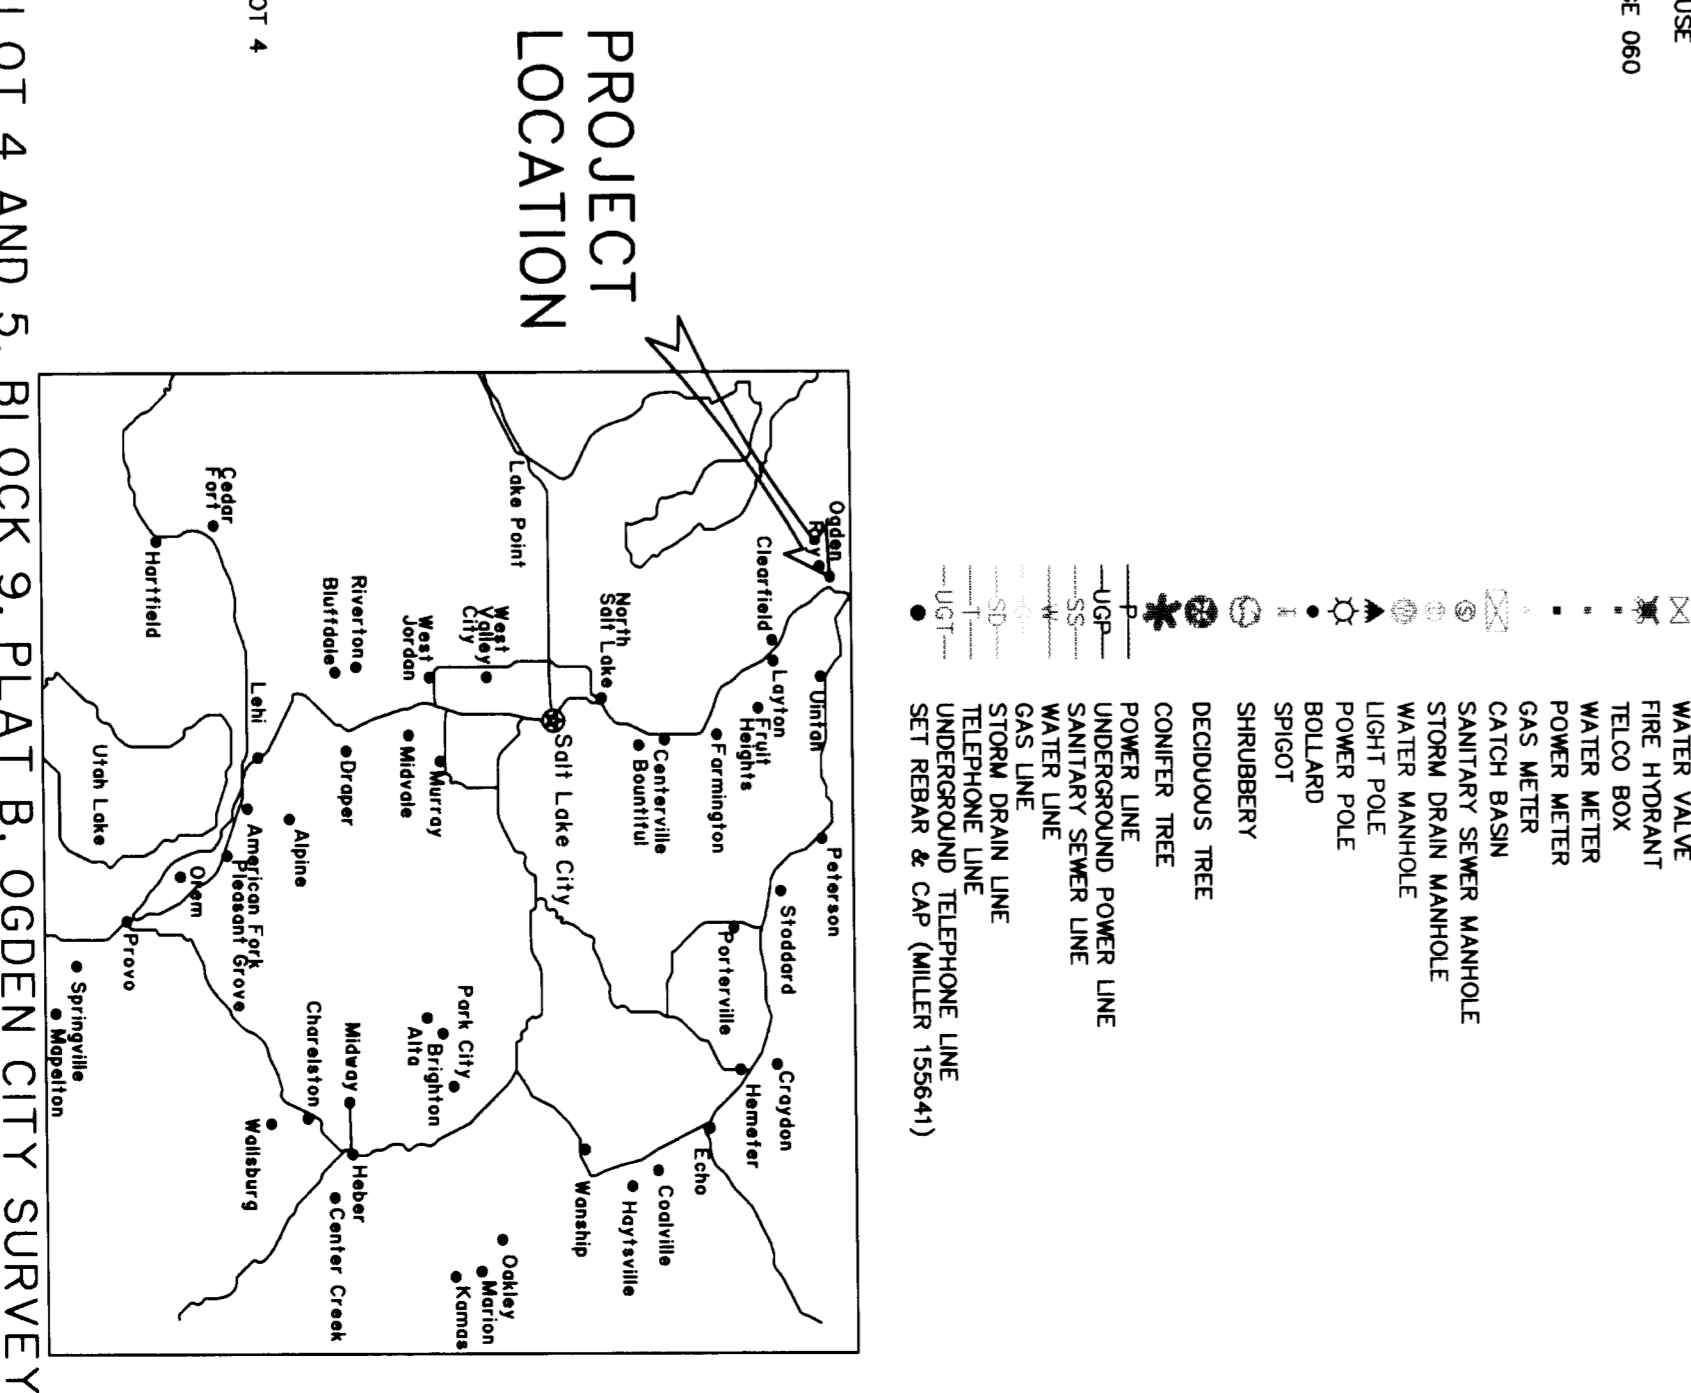

ALL F.C.C. AND F.A.A. REGULATIONS/REQUIREMENTS WILL BE OBSERVED AND MET. PROJECT FACILITY IS UNMANNED AND NOT FOR HUMAN HABITATION.


STATE PLANE COORDINATES MAD 83 (F.T.)
NORTHING = 3609823.90 EASTING = 1044237.65
STATE PLANE COORDINATES MAD 27 (F.T.)
NORTHING = 324806.03 EASTING = 1874028.51

GEOMETRIC COORDINATES NAD 83
EASTING = 1044237.65
NORTHING = 3609823.90
LONGITUDE = W 117° 57' 31.292927"
LATITUDE = N 40° 13' 26.8882"
LONGITUDE = W 117° 57' 28.53300"
STATE OF UTAH, NORTH ZONE.

LOT 4 AND 5, BLOCK 9, PLAT B, OGDEN CITY SURVEY

PROPOSED SITE LOCATION SURVEY FOR:
NEXTTEL COMMUNICATIONS

ALL OF LOT 4 AND 5, BLOCK 9, PLAT B, OGDEN CITY SURVEY

SITE NO. UT-0082DT / OGDEN-FELLOWSHIP MANOR
2334 SO. MONROE BLVD., OGDEN CITY, WEBER COUNTY, UTAH

DATE OF SURVEY: FEBRUARY 14, 1997

PREPARED BY MILLER ASSOCIATES, INC.
PROFESSIONAL LAND SURVEYORS
3225 WEST CALIFORNIA AVENUE
SALT LAKE CITY, UTAH 84119

JOB NO.