

**SURVEYOR'S CERTIFICATE**  
 I, RANDALL L. WILSON, SURVEYOR, HOLDING UTAH LICENSE NUMBER 159437, THAT A SURVEY OF THE PROPERTY DESCRIBED HEREON WAS PERFORMED BY ME OR UNDER MY DIRECT SUPERVISION THAT THIS PLAT CORRECTLY DEPICTS THE FINDINGS OF THAT SURVEY.

SIGNED THIS 16<sup>TH</sup> DAY OF SEPTEMBER 19 98.

159437  
 UTAH LICENSE NUMBER

**DEED DESCRIPTION**  
TO BEGINNING.

LESS OUT CLAIM REED BOOK 1839 PAGE 78 DESCRIBED AS FOLLOWS:  



**LEGEND**  
 = SECTION CORNERS  
 = EXISTING FENCE  
 = DIRT ROAD  
 = CENTER LINE OF CANAL

**REVISIONS**

1.					
2.					
3.					
4.					
5.					
6.					

**REVEE & ASSOCIATES, INC.**  
 ENGINEERS  
 3870 QUINCY AVE. SUITE 101  
 SALT LAKE CITY, UTAH 84141-6311-2666  
 (801) 487-1700 FAX (801) 488-4943-3100



**RECORD OF SURVEY**





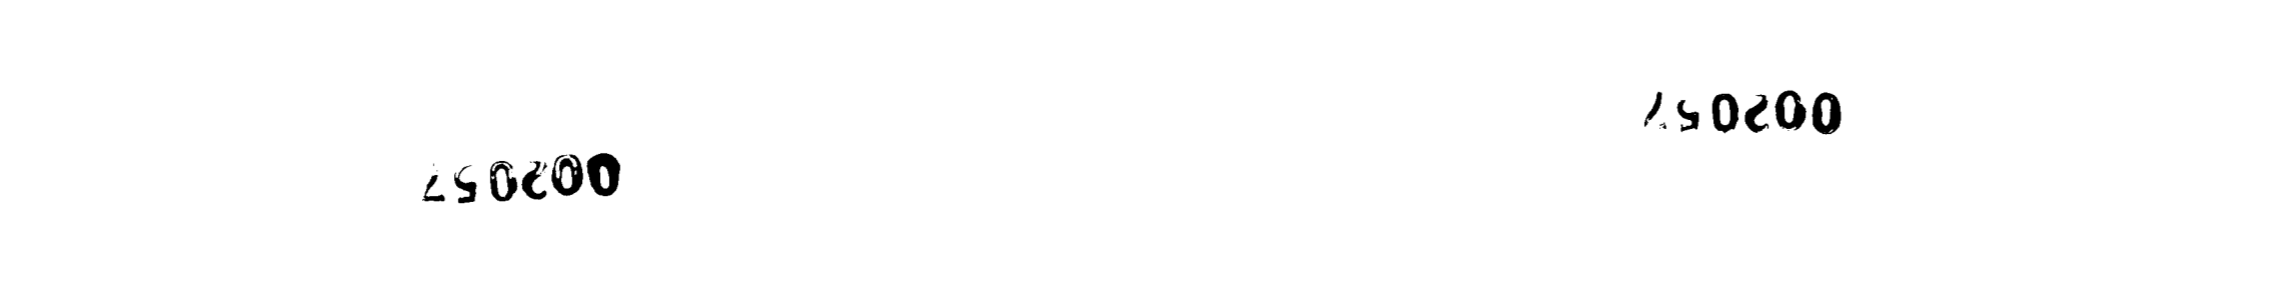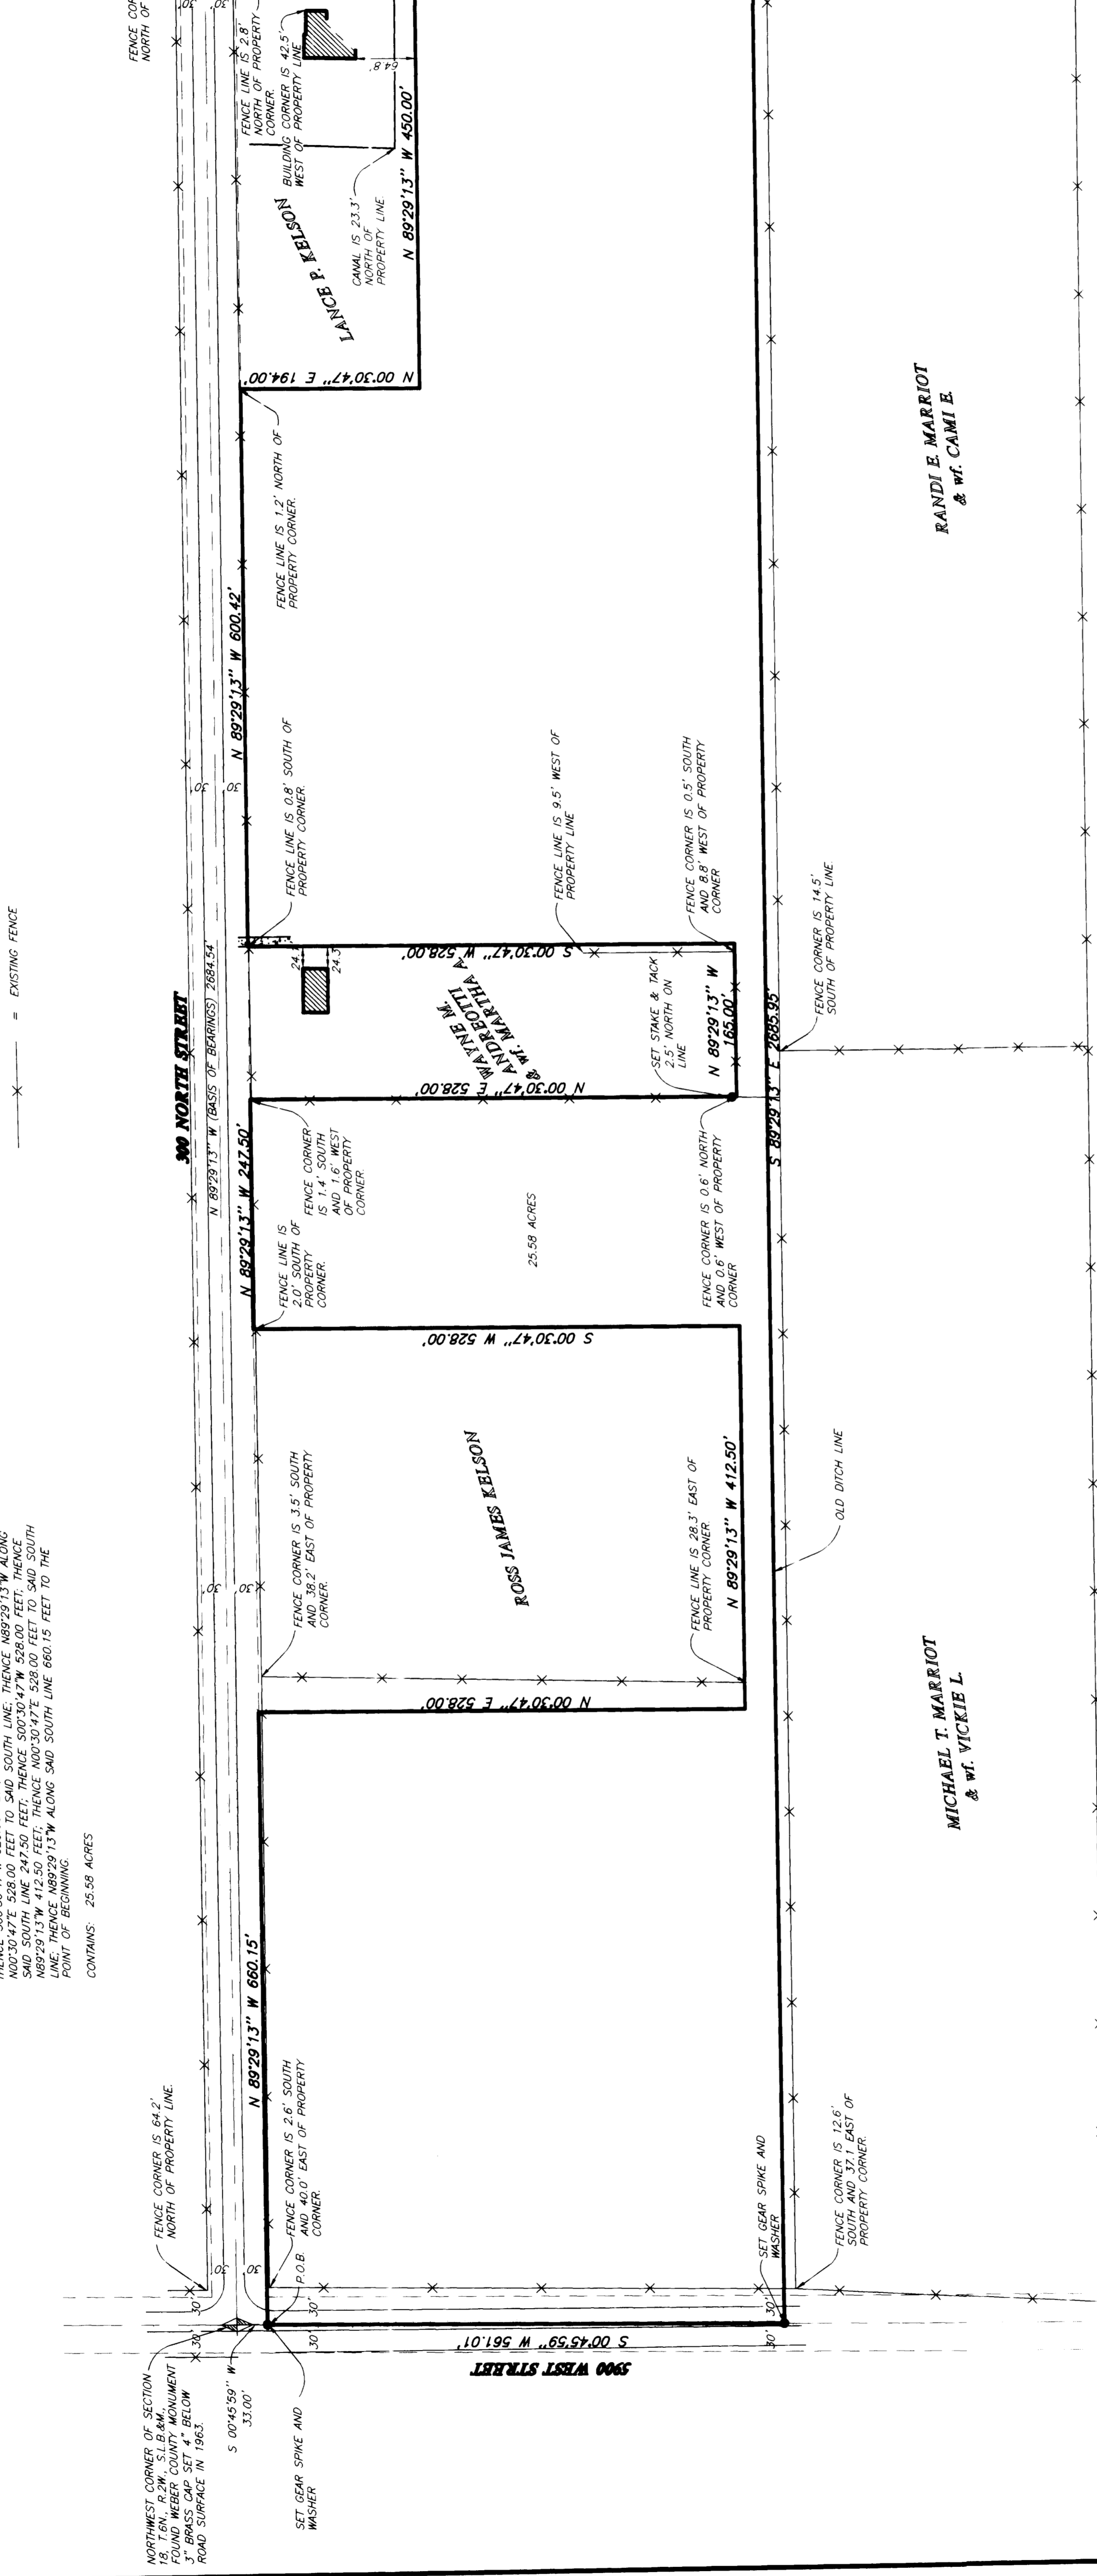

RECEIVED  
 SEP 8 9 1998  
 WEBSTER COUNTY SURVEYOR

THESE PLANS AND SPECIFICATIONS ARE THE PROPERTY OF REEVE & ASSOC., INC., 3870 QUINCY AVE., OGDEN, UTAH, 84403 AND SHALL NOT BE COPIED OR REDUCED OR REPRODUCED WITHOUT THEIR WRITTEN PERMISSION.

SHEET 1

**MITCHELL PROPERTY**  
 PART OF THE NORTHWEST QUARTER, WEBSTER COUNTY, UTAH  
 JULY, 1988

**RECORD OF SURVEY**


PROJECT NO. 2482-02 SURVEYOR: R. BELLEFLORE  
 DATE: 7-28-98 DRAWN: N. GARDN.  
 SCALE: 1"=100' CHECKED:

REVISIONS

1.					
2.					
3.					
4.					
5.					
6.					

002057

002057





