

NORTH QUARTER CORNER OF SECTION 10, T.5N., R.1W., LOCATION DETERMINED FROM OGDEN CITY MONUMENT ESTIMATES PHASE ONE PLAN

S 89°59'50" E (BASIS OF BEARINGS) 343.89'

OGDEN CITY MONUMENT LOCATION DETERMINED FROM ESTIMATES PHASE ONE PLAN

S 30°54'00" E 611.47'


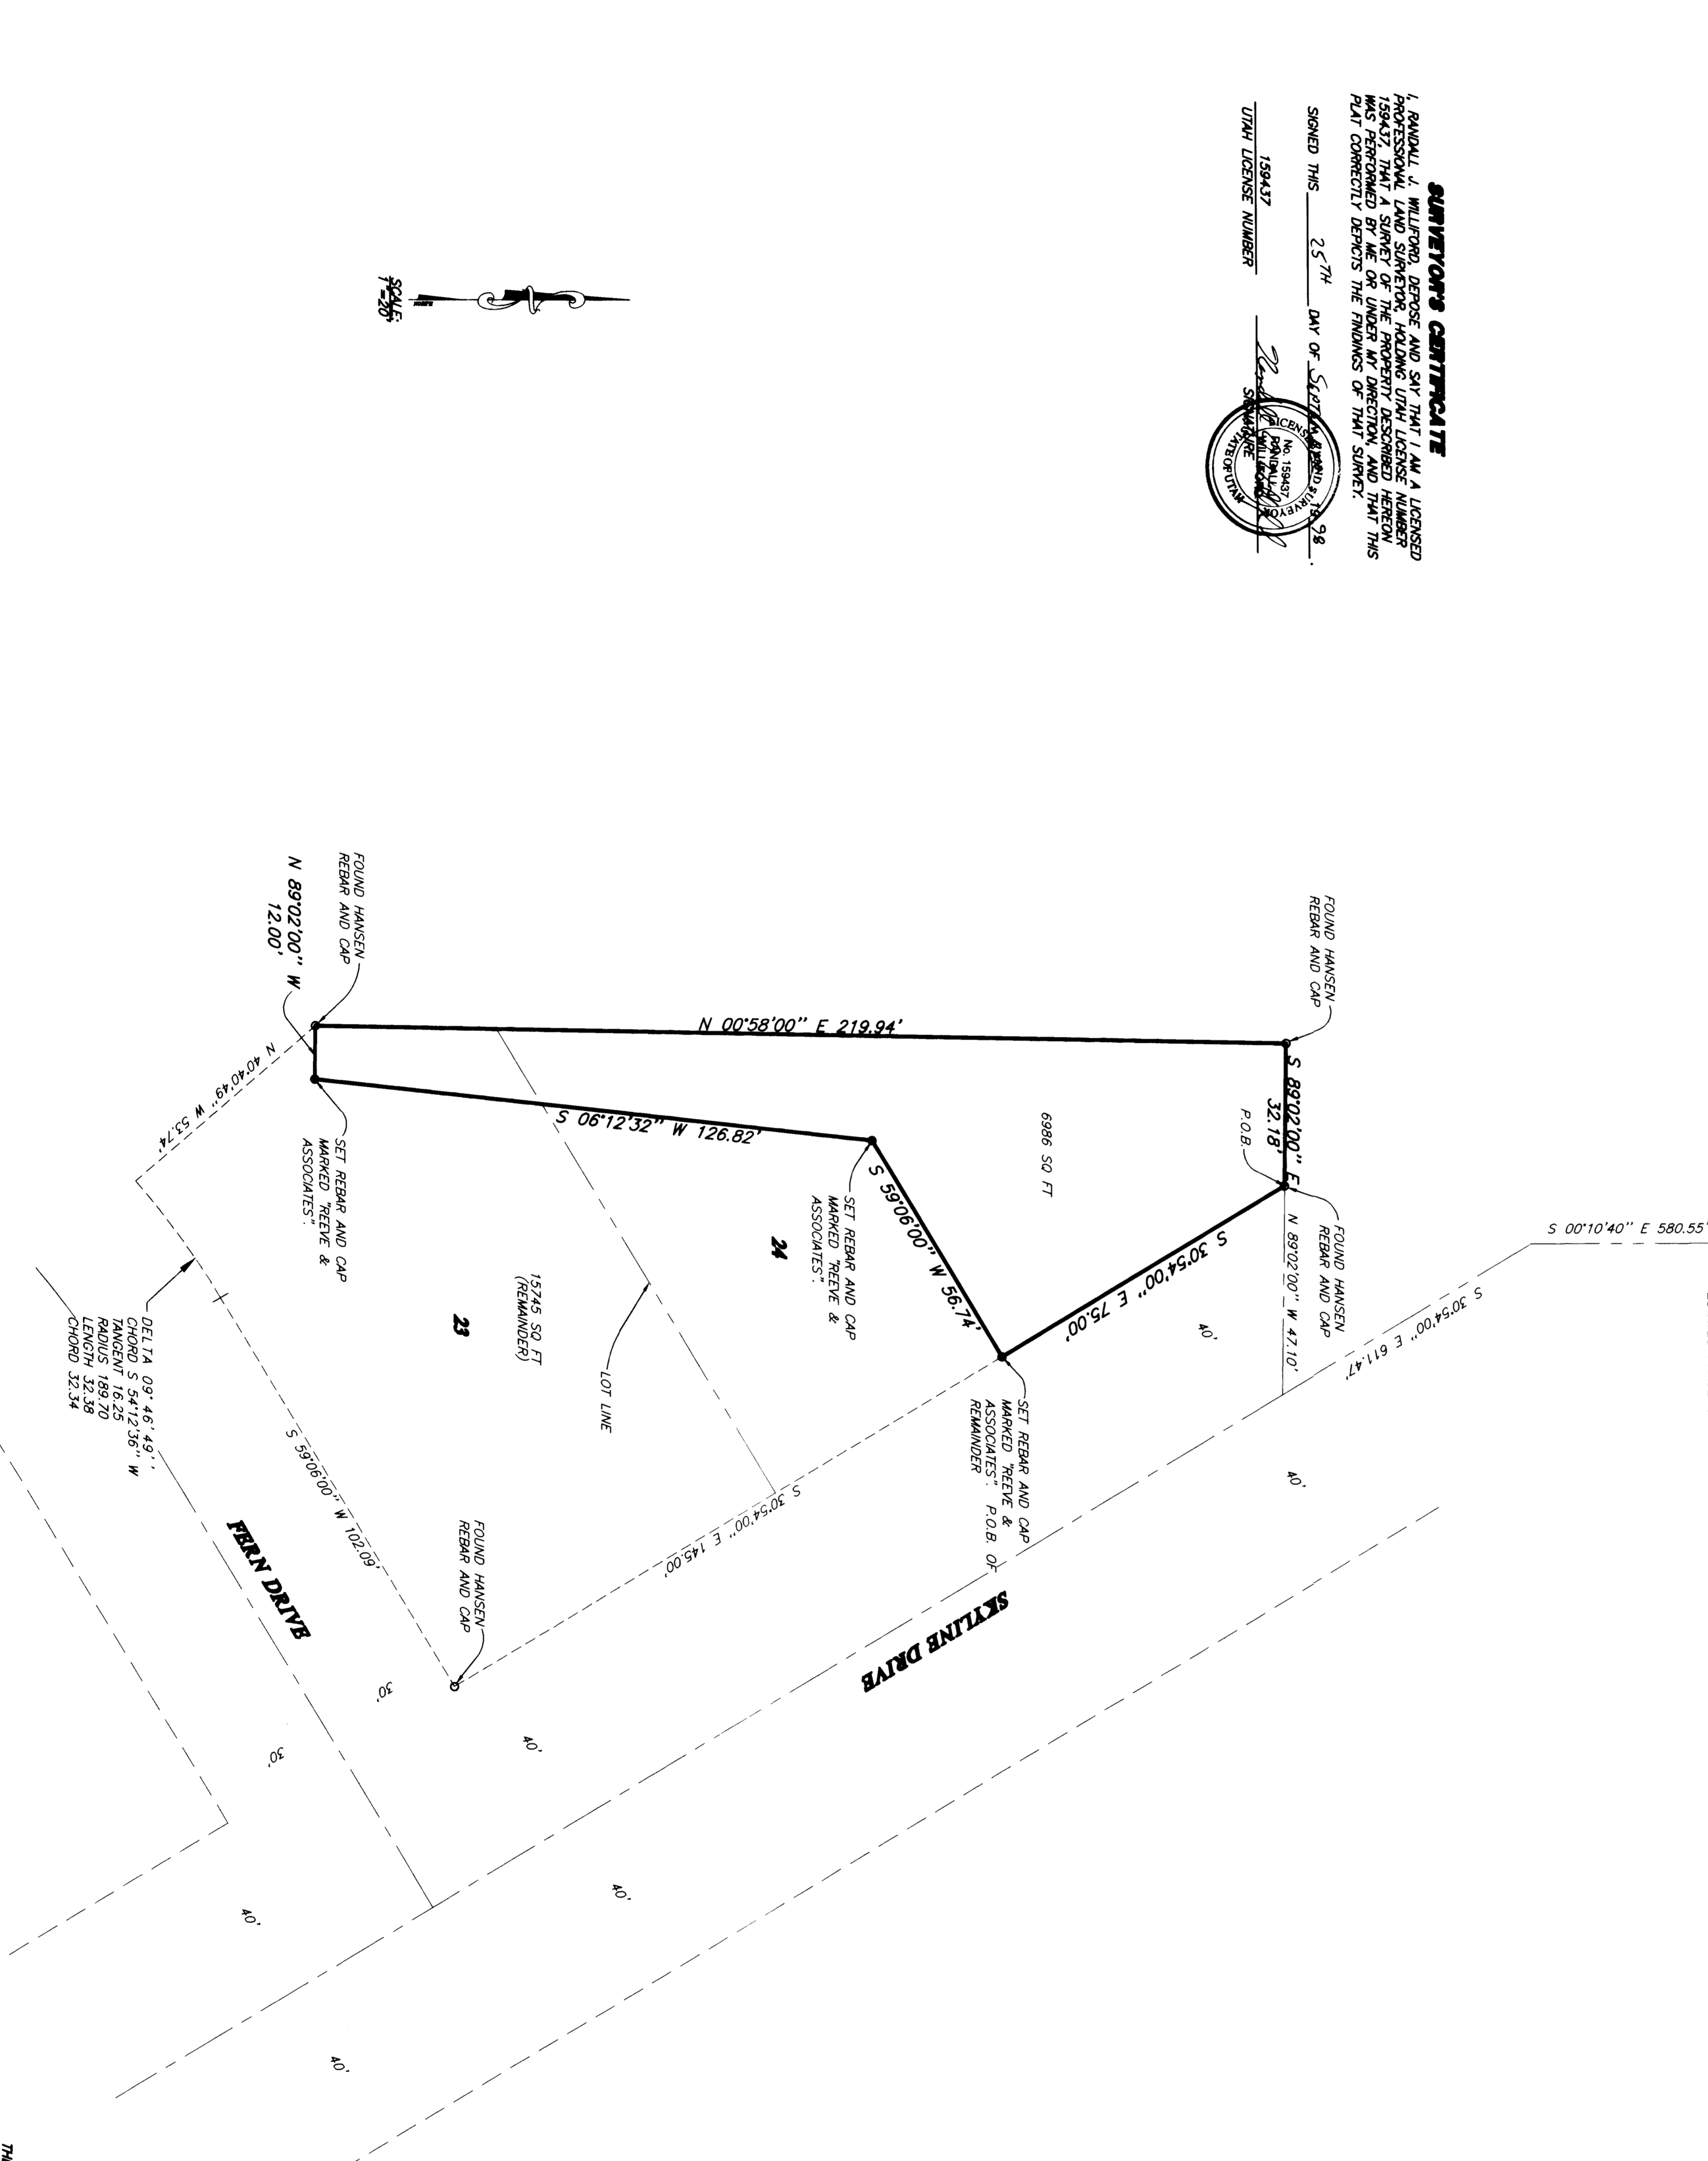
S 00°10'40" E 580.55'

SURVEYOR'S CERTIFICATE


SIGNED THIS 25TH DAY OF SEPTEMBER 1998


BASIS OF BEARINGS


NARRATIVE


SURVEYED DESCRIPTION

PART OF LOTS 24 AND 23, OAK VIEW ESTATES PHASE ONE, OGDEN CITY, WEBER COUNTY, UTAH DESCRIBED AS FOLLOWS:




REMAINDER DESCRIPTION

PART OF LOTS 24 AND 23, OAK VIEW ESTATES PHASE ONE, OGDEN CITY, WEBER COUNTY, UTAH DESCRIBED AS FOLLOWS:



CONTAINS: 15745 SQUARE FEET

RECEIVED
SEP 29 1998
Weber County Surveyors

REVISIONS

1.	
2.	
3.	
4.	
5.	
6.	

PROJECT NO.: 2882-28
DATE: 7-2-98
SCALE: 1"=40'

DRAWN BY: J. GUNN
CHECKED: [Signature]

REEVE & ASSOCIATES, INC.
ENGINEERS PLANNERS & SURVEYORS
3070 QUINCY AVE. SUITE 101
OGDEN, UTAH 84403
(801) 621-3100 FAX (801) 621-2686
TOLL-FREE 1-800-644-3100

LOT LINE ADJUSTMENT

PART OF LOTS 23 & 24 OAK VIEW ESTATES PHASE ONE
PART OF THE NORTHWEST QUARTER OF SECTION 10, T.5N., R.1W., S.L.B.M.
OGDEN CITY, UTAH

SHEET 1 OF 1 SHEETS