

BOUNDARY DESCRIPTION


PARCEL -1
PART OF THE SOUTHWEST QUARTER OF SECTION 5, T.5N., R.1W., S.L.B.& M., U.S. SURVEY, DESCRIBED AS FOLLOWS:


PARCEL -2
PART OF THE SOUTHWEST QUARTER OF SECTION 5, T.5N., R.1W., S.L.B.& M., U.S. SURVEY, DESCRIBED AS FOLLOWS:


PARCEL -3
PART OF THE SOUTHWEST QUARTER OF SECTION 5, T.5N., R.1W., S.L.B.& M., U.S. SURVEY, DESCRIBED AS FOLLOWS:


WEST QUARTER CORNER OF SECTION 5, T.5N., R.1W., S.L.B.& M., U.S. SURVEY, COUNTY BRASS CAP (1965)

SURVEYORS CERTIFICATE
I, DANIEL M. WILSON, DEPOSE AND SAY THAT I AM A LICENSED PROFESSIONAL SURVEYOR AND THAT I HAVE PERSONALLY AND INDEPENDENTLY EXAMINED THE RECORDS AND THAT A SURVEY OF THE PROPERTY DESCRIBED HEREON WAS PERFORMED BY ME OR UNDER MY DIRECTION AND THAT THIS PLAN CORRECTLY REFLECTS THE FINDINGS OF SAID SURVEY.
SIGNED THIS 25TH DAY OF SEPTEMBER, 1998.
199437
UTAH LICENSE NUMBER
DANIEL M. WILSON
SURVEYOR

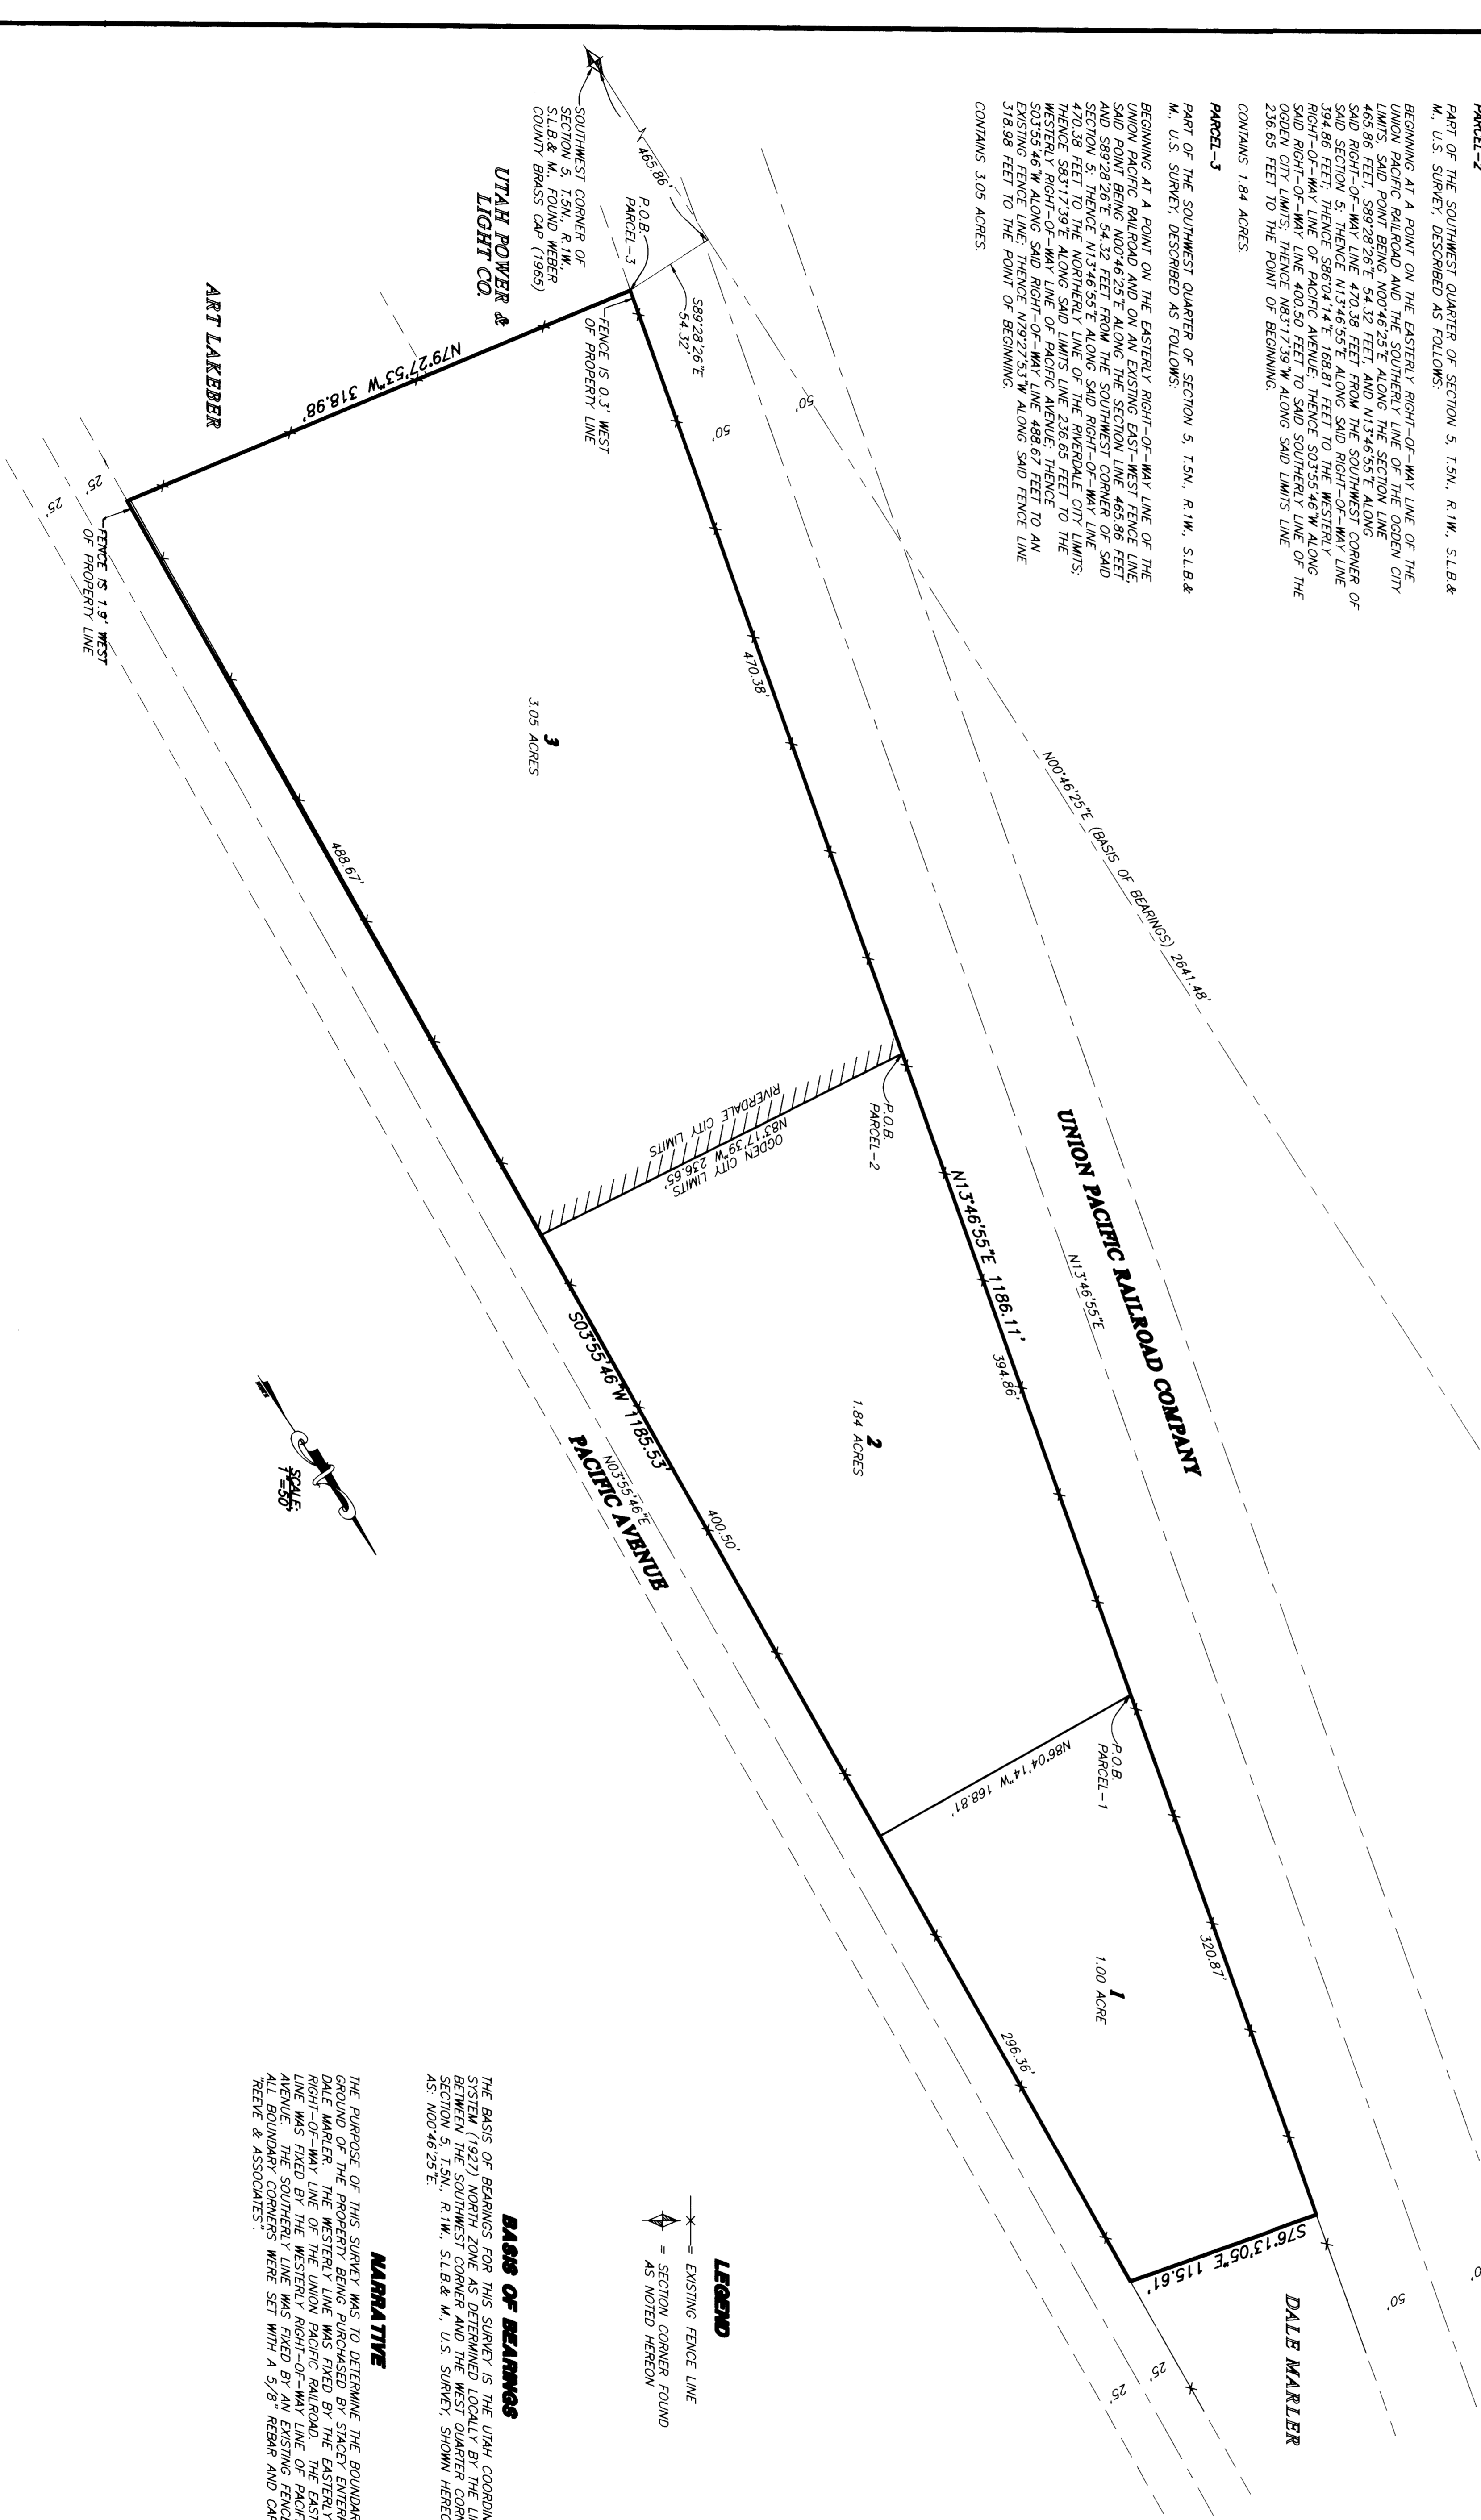

LEGEND
--- EXISTING FENCE LINE
--- SECTION CORNER FOUND AS NOTED HEREON

BASES OF BEARINGS

MARRA TIVE
ALL BOUNDARY CORNERS WERE SET WITH A 5/8" REBAR AND CAP MARKED REEVE & ASSOCIATES.

RECEIVED
SEP 29 1998

REVISIONS

1.		4.	
2.		5.	
3.		6.	

PROJECT NO.: 1998-01
DATE: 1-2-98
SCALE: 1"=50'

DESIGNED BY: JWB
CHECKED BY: JWB
DRAWN BY: JWB
DATE: 1-2-98

REEVE & ASSOCIATES, INC.
ENGINEERS PLANNERS & SURVEYORS
3670 QUINCY AVE. SUITE NO. 1
(801) 621-5100 FAX (801) 621-4866
TOLL-FREE 1-800-694-5100

RECORD OF SURVEY

STACEY ENTERPRISES
DECEMBER, 1997

SHEET 1 OF 1 SHEETS