


**SURVEYOR'S CERTIFICATE**


SIGNED THIS 16<sup>TH</sup> DAY OF NOVEMBER, 1998.

UTAH LICENSE NUMBER

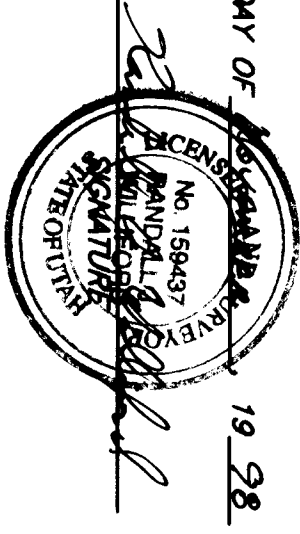

**BASIS OF BEARINGS**

THE BASIS OF BEARINGS FOR THIS PLAT IS THE UTAH COORDINATE SYSTEM (UTZ) NORTH ZONE AS DETERMINED BY THE NATIONAL BUREAU OF STANDARDS AND THE NORTHEAST CORNER OF SECTION 32, T6N, R2W, S18&M, U.S. SURVEY, SHOWN HEREON AS: N01°07'03"E

**NARRATIVE**

THE PURPOSE OF THIS SURVEY IS TO DETERMINE THE TRUE LOCATION OF THE COMMON LINE BETWEEN THE WILFORD AND MONTGOMERY TRACTS. THE WILFORD TRACT WAS FIRST CREATED IN 1975 WHEN FRED MALIN SURVEYED A LARGER TRACT FOR THE PURPOSE OF DIVIDING THE PROPERTY BETWEEN HIS TWO DAUGHTERS, MARCENE W. MONTGOMERY & JUSTICE MARCENE W. MONTGOMERY. THE MALIN TRACT WAS DIVIDED INTO TWO SEPARATE PARCELS, INCLUDING THE WEST END OF THE COMMON LINE. THE MALIN TRACT WAS SURVEYED BY FRED MALIN IN 1975 AND HIS SURVEY PLAT BECAME THE BASIS OF BEARINGS FOR THIS SURVEY. 

**SURVEYED DESCRIPTION OF COMMON BOUNDARY**


PART OF THE NORTHEAST QUARTER OF SECTION 32, T6N, R2W, S18&M, U.S. SURVEY, DESCRIBED AS FOLLOWS:  
BEGINNING AT A POINT ON THE SECTION LINE N01°07'03"E ALONG THE 340 LINE 424.55 FEET FROM THE EAST QUARTER CORNER OF SAID SECTION; THENCE S87°56'35"W 634.71 FEET AND N87°28'33"W 670.28 FEET.

**LEGEND**

- SECTION CORNER
- EXISTING FENCE
- SURVEY LINE BY CYNTHIA ROBINETT
- SURVEY LINE BY GLENN RAVENBERG

- REVISIONS**
- |    |  |    |
|----|--|----|
| 1. |  | 4. |
| 2. |  | 5. |
| 3. |  | 6. |

PROJECT NO. \_\_\_\_\_ DATE: 11-12-98  
DRAWN BY: \_\_\_\_\_ CHECKED BY: \_\_\_\_\_  
SCALE: 1"=40' SURVEYOR: K. GUNN



**REEVE & ASSOCIATES, INC.**  
ENGINEERS, PLANNERS & SURVEYORS  
3670 CORNELL DR. SUITE 100  
SALT LAKE CITY, UT 84119  
(801) 487-3100 FAX (801) 487-2868  
1021-718E 1-888-484-3100

**RECORD OF SURVEY**

**ARLENE WAYMONT**  
PART OF THE NORTHEAST QUARTER OF SECTION 32, T6N, R2W, S18&M, U.S. SURVEY  
WEBER COUNTY, UTAH  
1989

SHEET 1 OF 1

