


SURVEYORS' CERTIFICATE

I, Chester L. Nelson, do hereby certify that I am a Registered Land Surveyor and that I hold Certificate No. 4263 (152036) as prescribed by the laws of the State of Utah, and that I have made a satisfactory search of the records of the Weber County Records office as described below and shown per this plat.

8-20-98
DNB

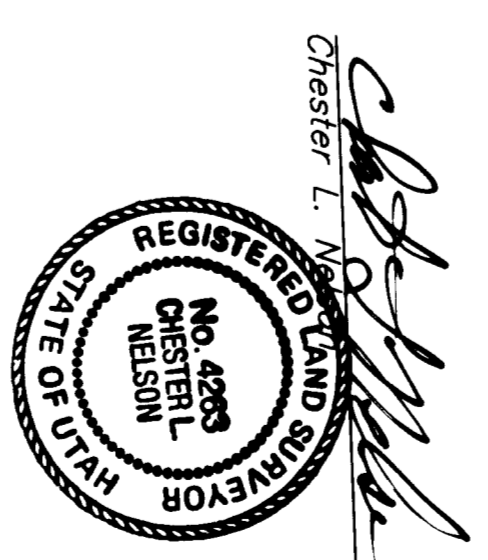

LEGEND:

- () DISTANCE AND OR BEARING PER DEED OR PLAT.
- NO PARALLELS IS MEASURED DISTANCE OR ROTATED PLAT OR DEED BEARING TO STATE PLANE AND BEARING.
- EXISTING FENCES.
- Existing Trees.

RECEIVED
NOV 1 9 1998
Weber County Surveyor

CONSTRUCTION & LAND SURVEYORS 810 CANYON ROAD OGDEN, UTAH 84404 (801) 399-4835	
CLIENT:	Kim Keller
SURVEY LOCATION:	1/4 SEC. 36 TOWNSHIP 6 NORTH, RANGE 2 WEST, SALT LAKE BASIN & MERRIMAN
SURVEY DATE:	7-7-98
JOB No.	PS98-35

PREPARED BY:
CONSTRUCTION & LAND SURVEYORS
 810 CANYON ROAD
 OGDEN, UTAH 84404
 PH. (801) 399-4835 FAX (801) 627-1088