


LOT LINE ADJUSTMENT FOR POWELL SUBDIVISION
A PART OF THE WEST 1/2 SEC. 15 AND THE EAST 1/2 SEC. 16
T6N, R2W, SLB AND M, U.S. SURVEY
WEBER COUNTY, UTAH
SEPT. 1998

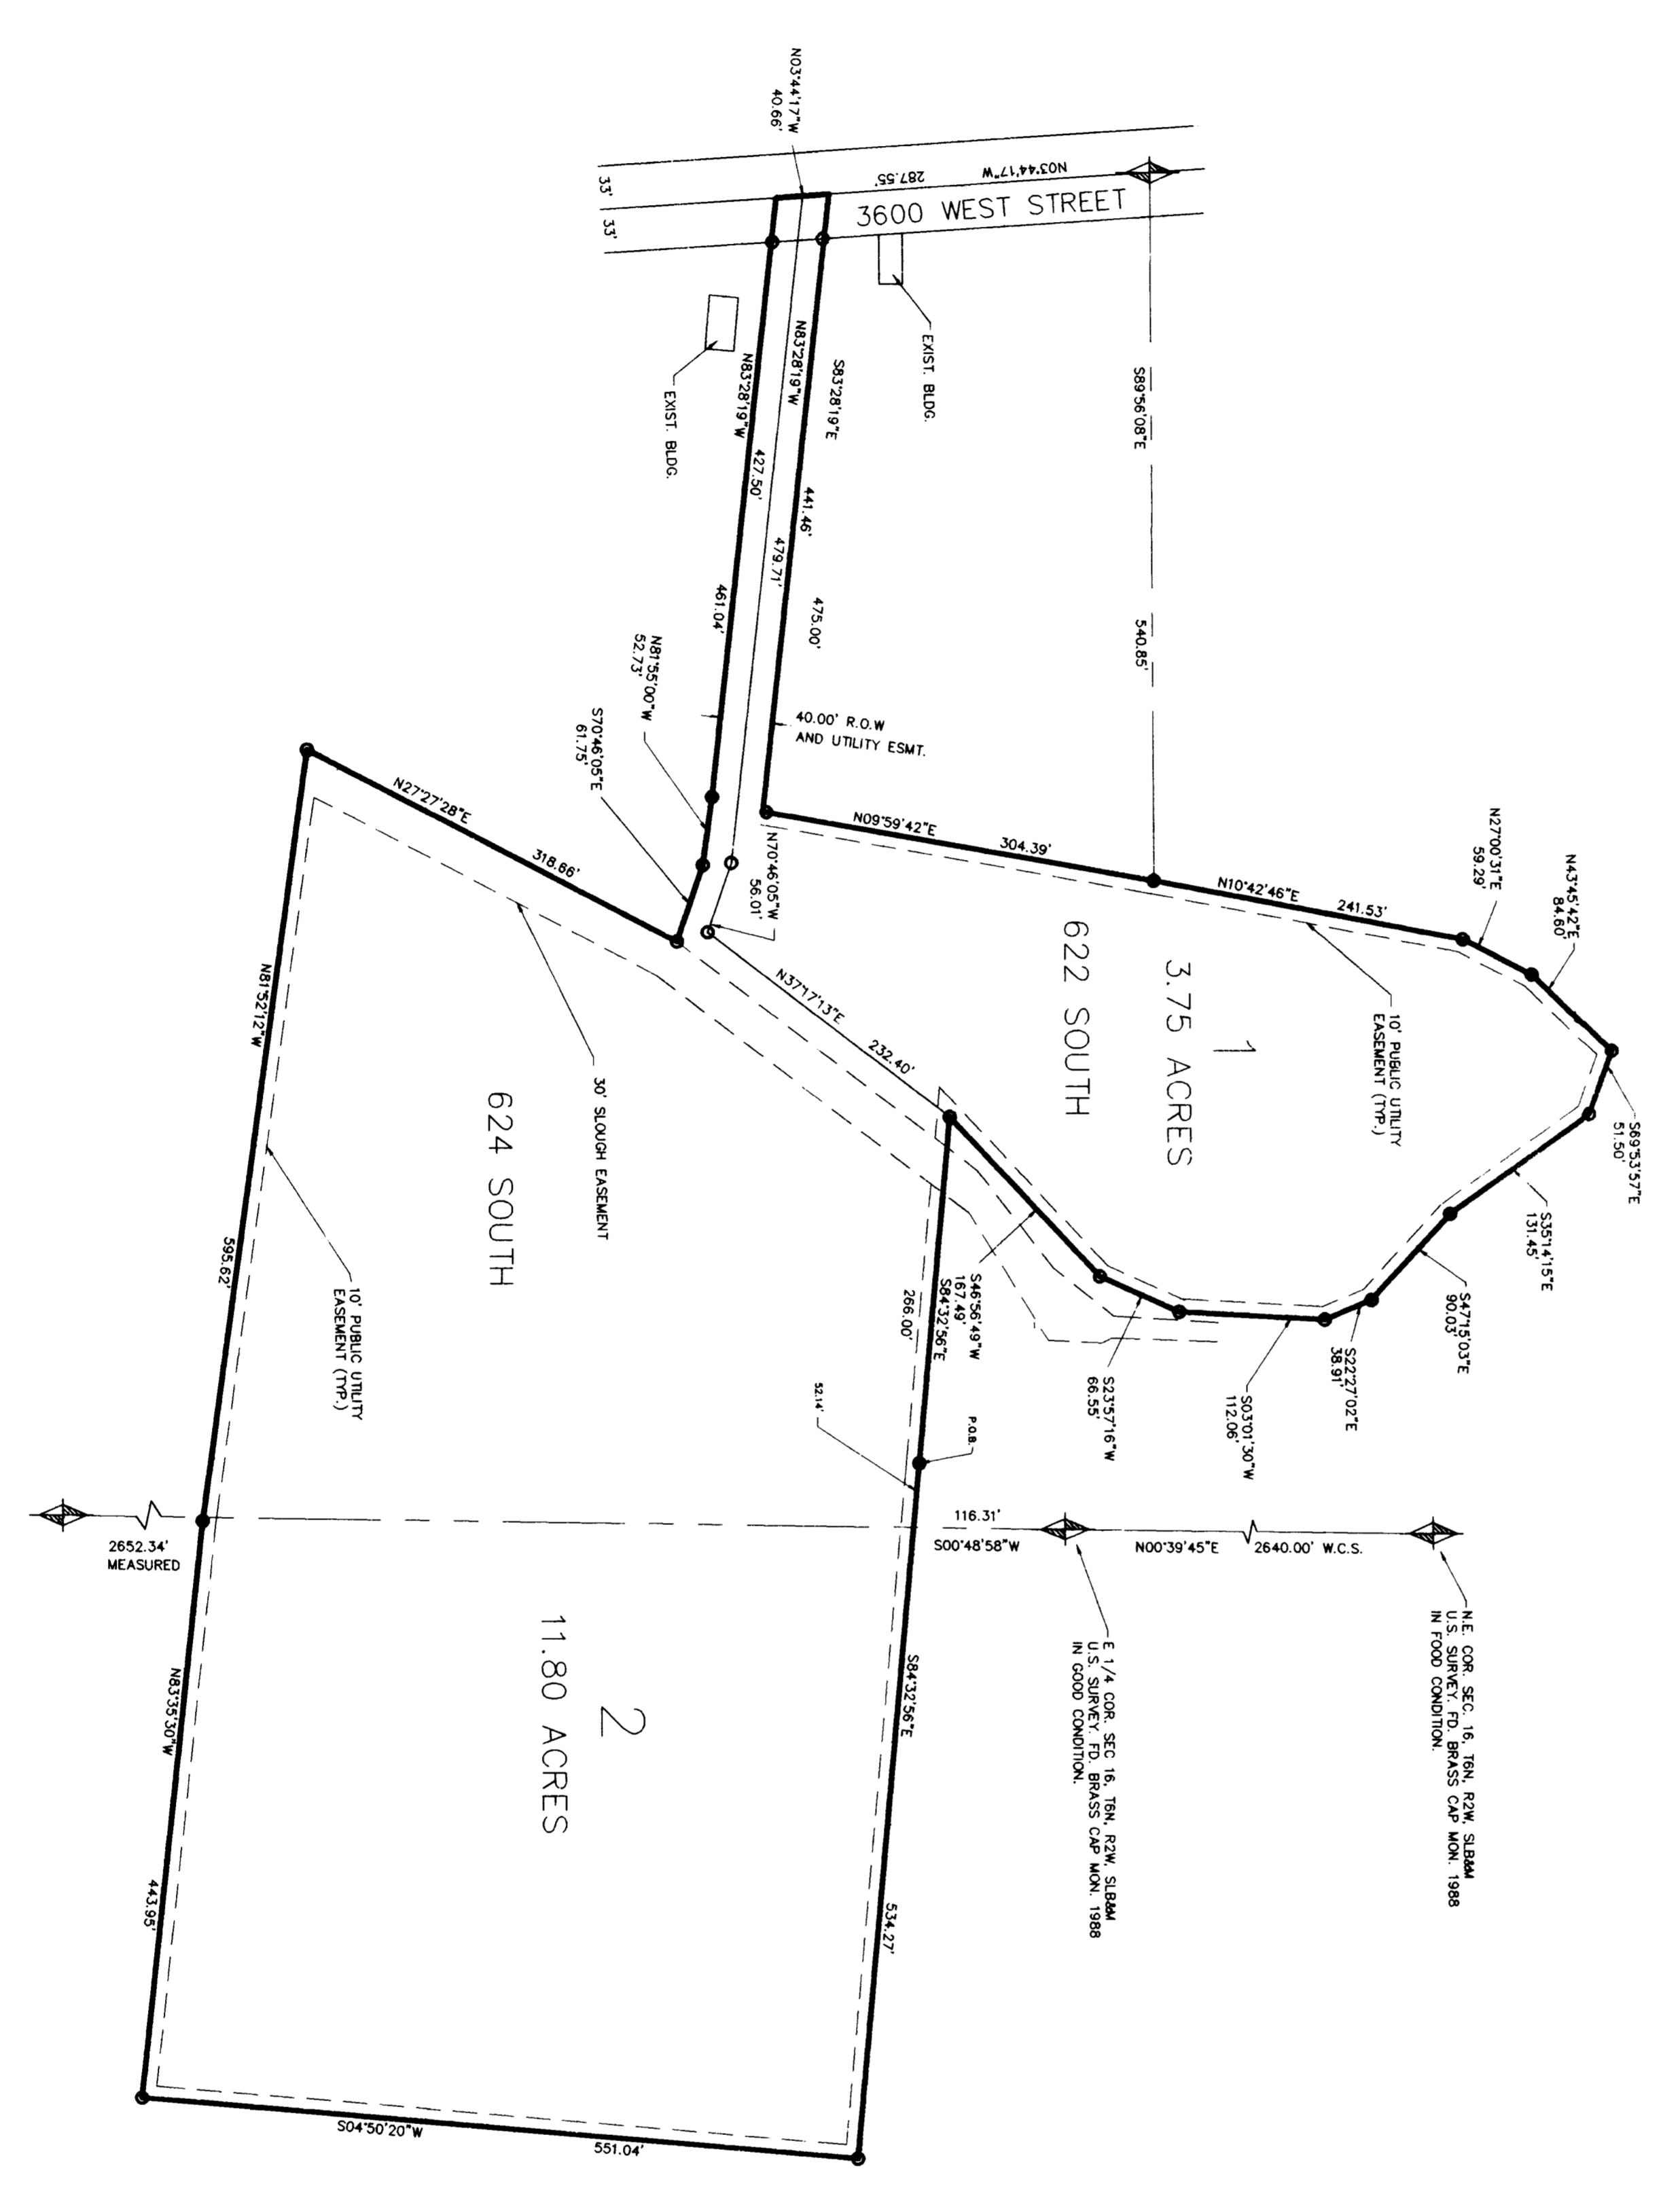

SCALE: 1" = 100'
○ = FND. REBAR & CAP

002106

SURVEYOR'S CERTIFICATE

I, DALLAS K. BLITZERS, A PROFESSIONAL LICENSED LAND SURVEYOR AS PRESCRIBED BY THE LAWS OF THE STATE OF UTAH, HAVE MADE A SURVEY OF THE ABOVE DESCRIBED PROPERTY AND THE PLAT HEREON IS A TRUE AND CORRECT REPRESENTATION OF SAID SURVEY.
DATE: NOV 30 1998 SIGNED: *[Signature]*



BOUNDARY DESCRIPTION


CONTAINS 15.20 ACRES.

NOTES

THE PURPOSE OF THIS SURVEY WAS TO CHANGE THE LOT CONFIGURATION OF THIS SUBDIVISION. THE ORIGINAL SUBDIVISION WAS SURVEYED BY WEBER COUNTY SURVEYOR DALLAS K. BLITZERS ON SEPTEMBER 15, 1998. THE SURVEY WAS RESET USING DECAT BARNES PROPERTY CORNERS FOUND AT THE PROPERTY.

RECEIVED

DEC 11 1998
Weber County Surveyor

LANDMARK SURVEYING
2445 GRAND AVENUE SUITE 110-10000, UTAH 84401
PHONE 877-44014

CLIENT: WARREN POWELL
LOCATION: T6N, R2W, SLB AND M, U.S. SURVEY
SURVEYED: JUNE 1998

002106