


OGDEN COMMERCIAL & INDUSTRIAL PARK-PLAT I & J-AMENDED CERTIFICATION OF SURVEY

002110

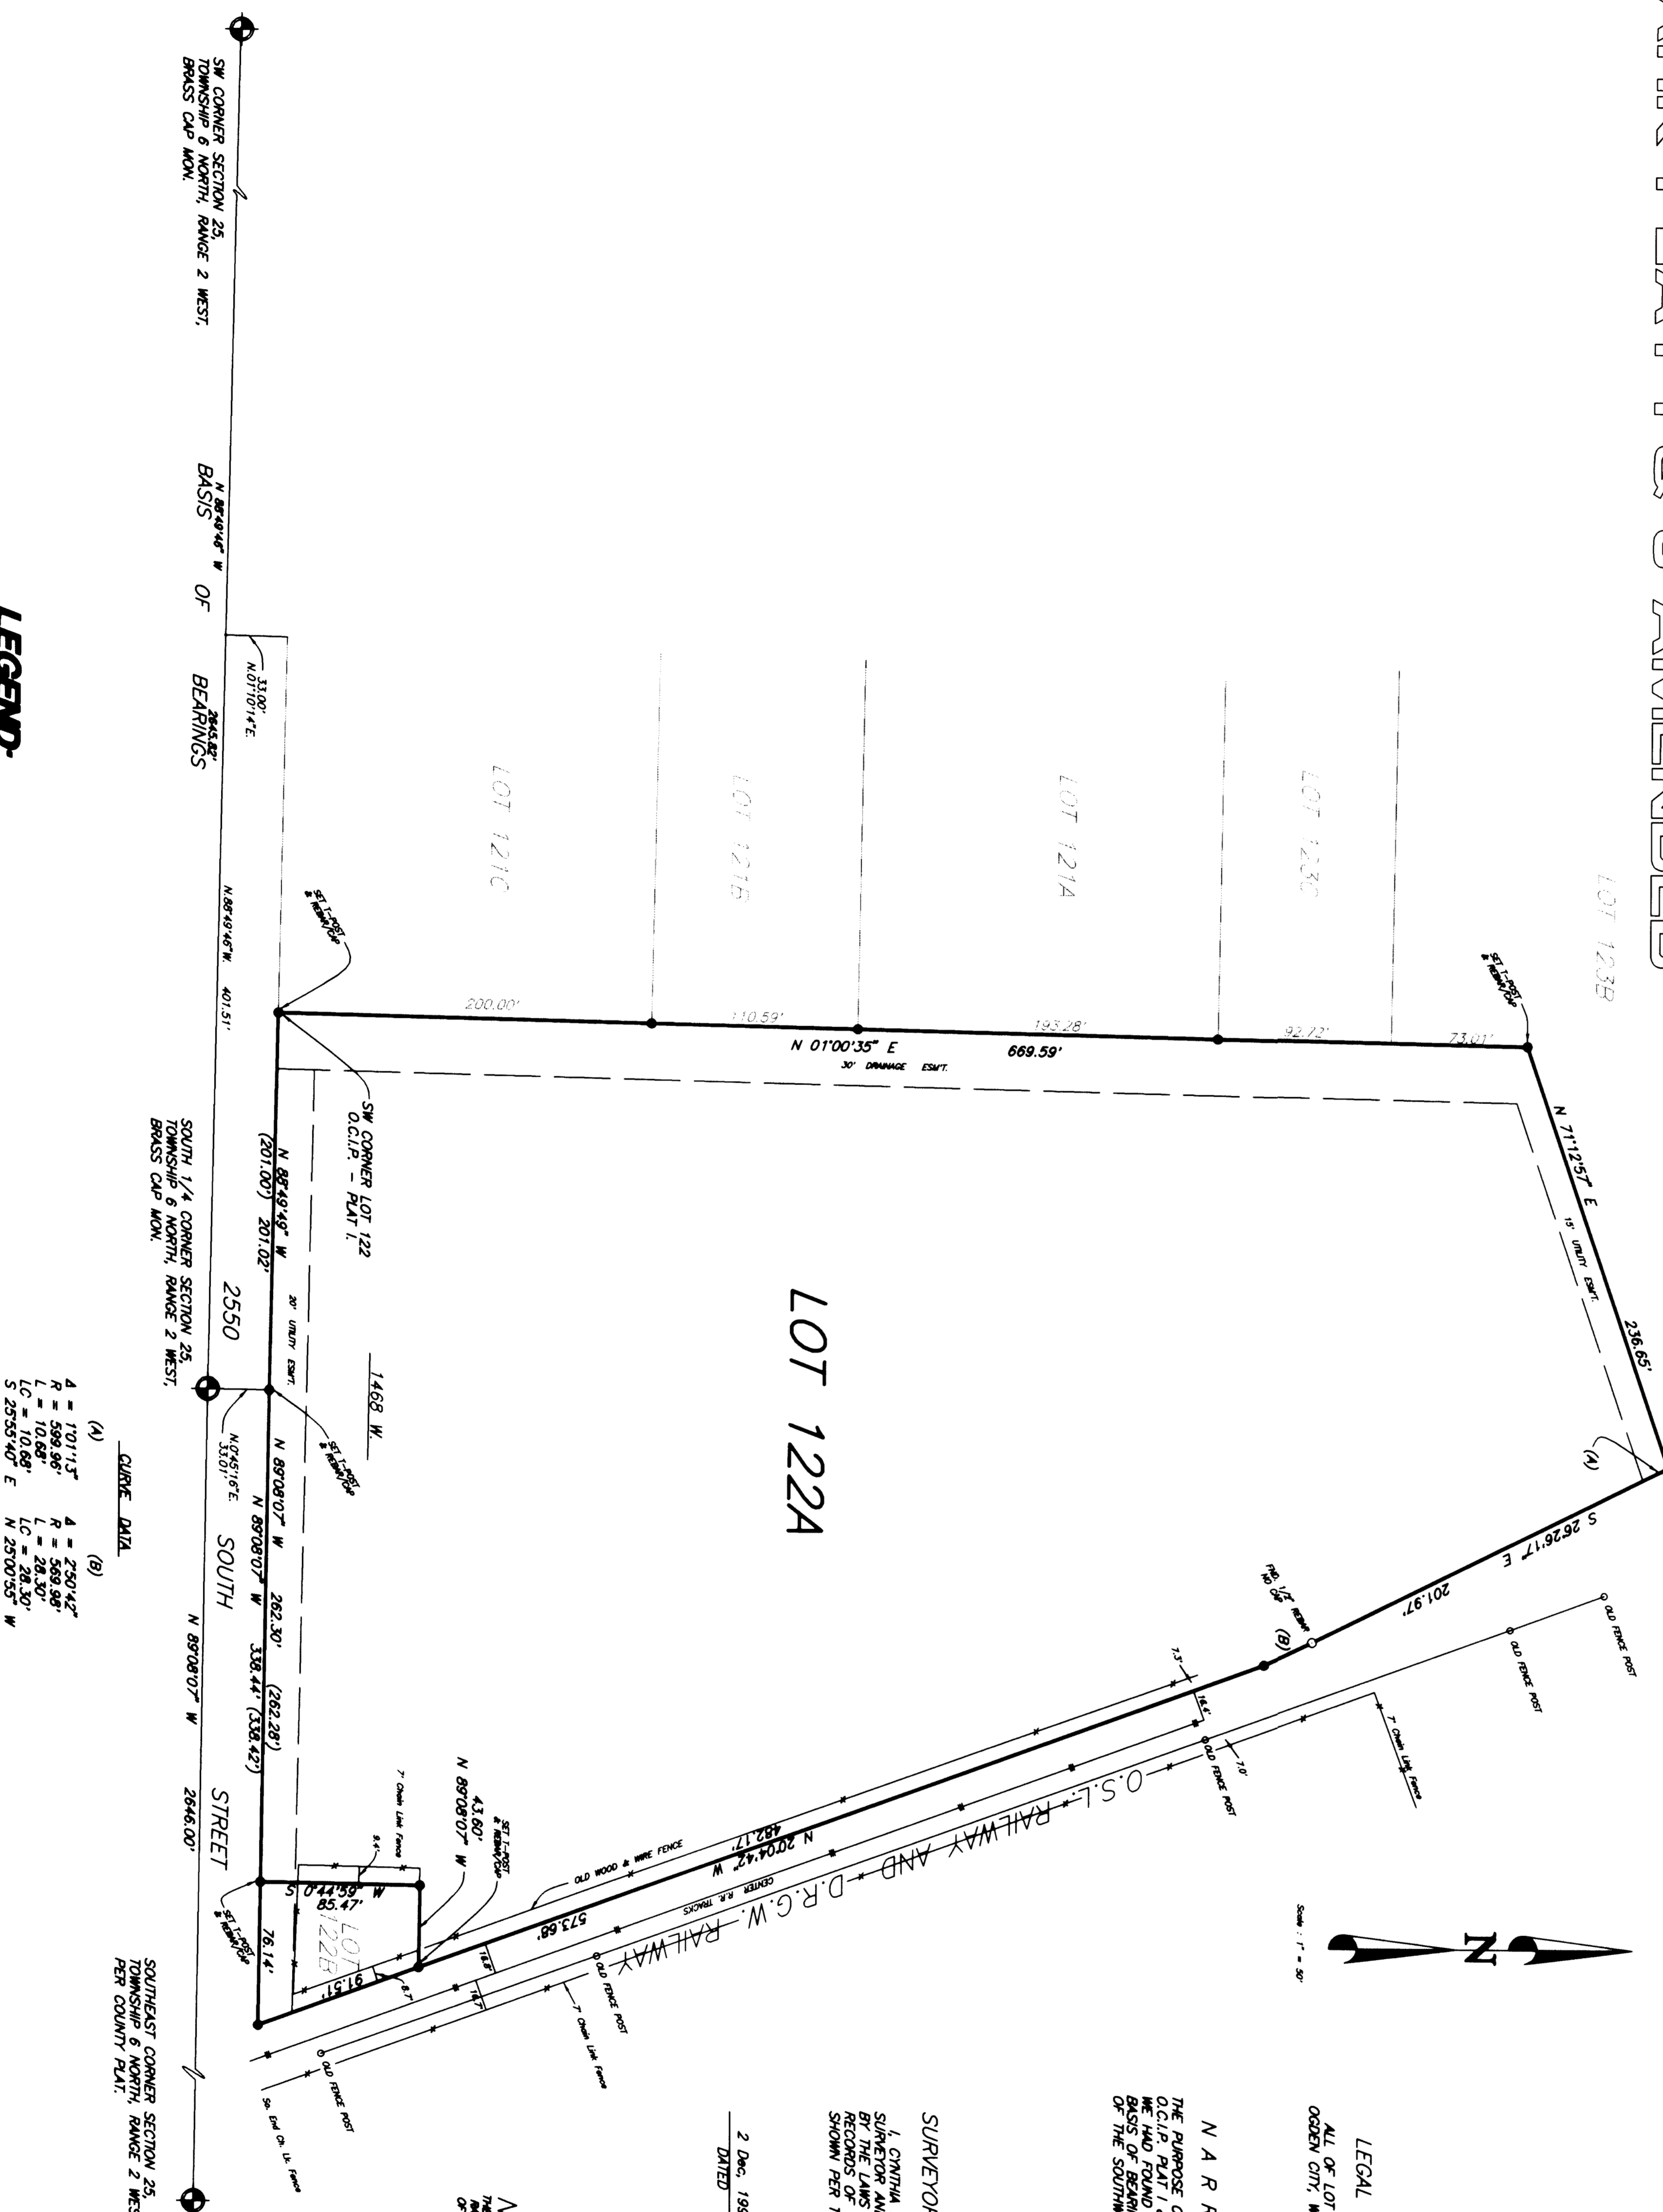

LEGEND:

- () DISTANCE AND OR BEARING PER DEED OR PLAT.
- NO PARENTHESES IS MEASURED DISTANCE OR ROTATED PLAT OR BEED BEARING TO STATE PLANE AND BEARING.
- * * * EXISTING FENCES.
- * CHANGES CONNECTED BY ALTIMETER.
- SET 5/8" REBAR & C.I.S. CAPS EXCEPT WHERE NOTED.

CURVE DATA


LEGAL DESCRIPTION

ALL OF LOT 1224, OGDEN COMMERCIAL & INDUSTRIAL PARK, PLATS I & J, AMENDED, OGDEN CITY, WEBER COUNTY, UTAH.

NARRATIVE


SURVEYORS CERTIFICATE






RECEIVED
DEC 17 1998
Weber County Surveyor

CLIENT:
R. & O. Construction

SURVEY LOCATION:
OGDEN, UTAH 84404

SURVEY DATE: 12/02/98

JOB NO. PS97-43D

PREPARED BY:
CONSTRUCTION & LAND SURVEYORS
810 CANYON ROAD
OGDEN, UTAH 84404
PH: (801) 399-4935 FAX: (801) 827-1088