


C:\DWG\0h111ps\44191 Mon Mar 03 08:36:56 1997 PLOTTED BY DEBBIE'S MACHINE

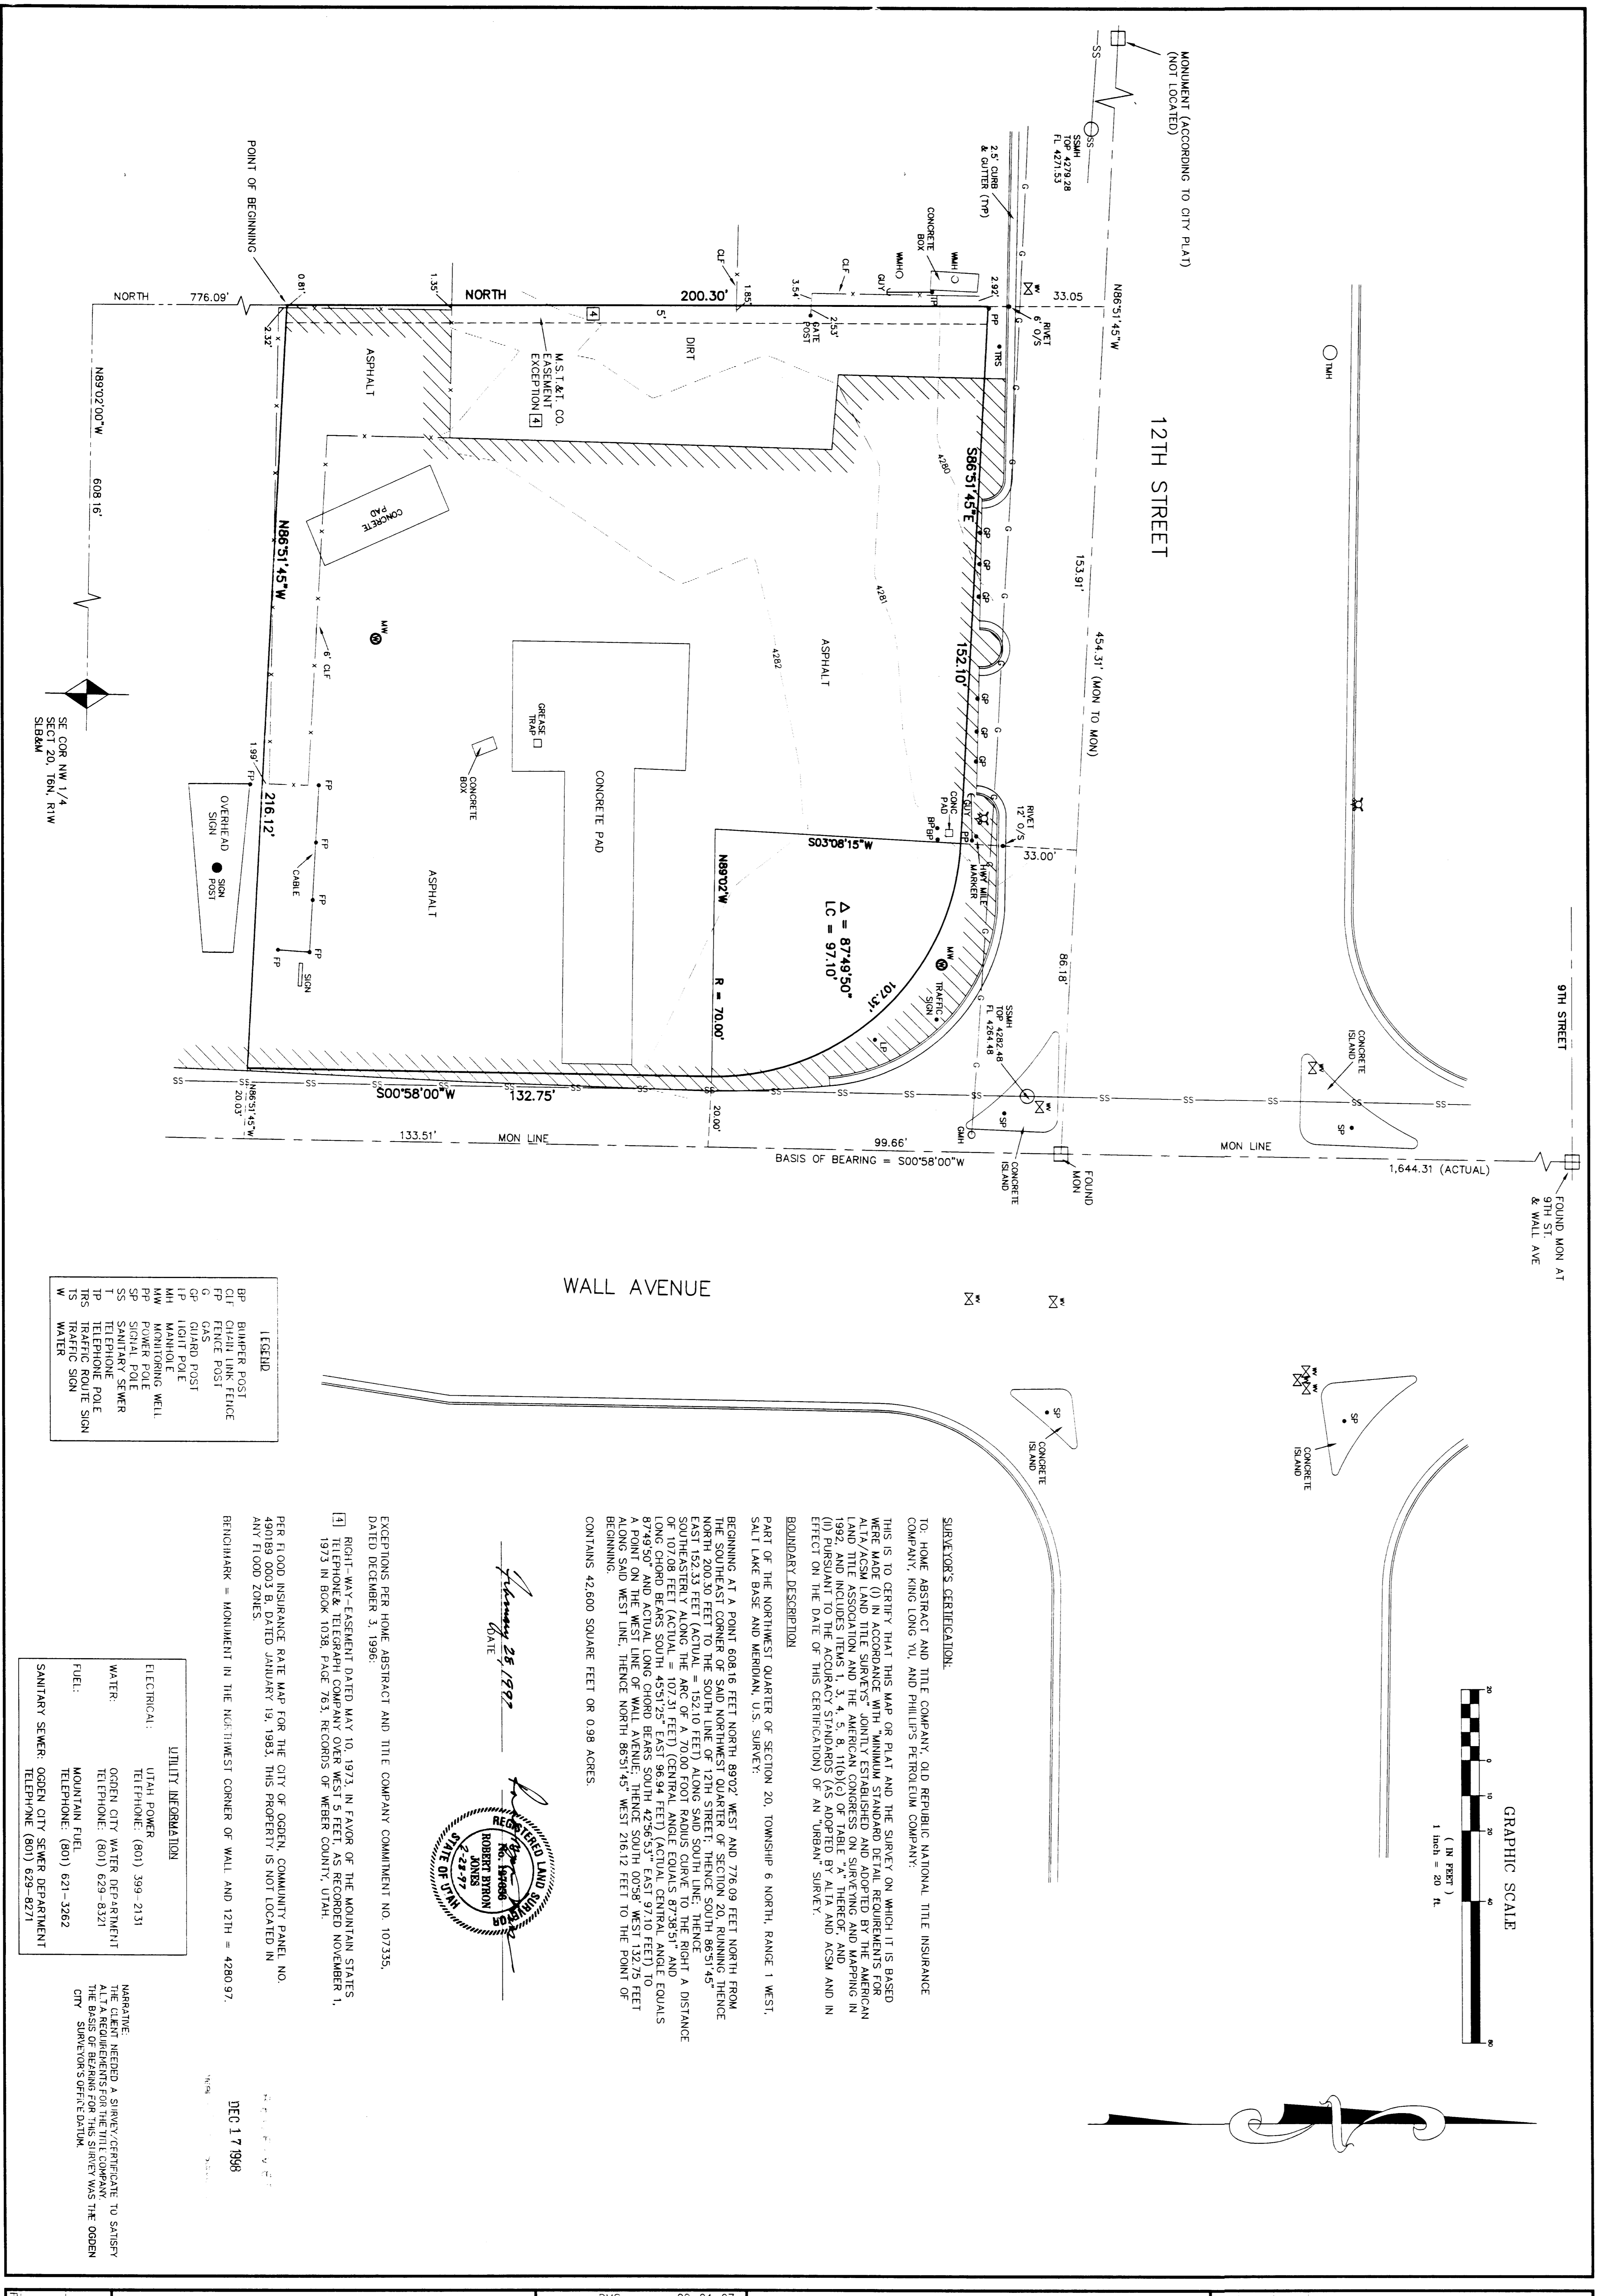


LEGEND

W	WATER

WALL AVENUE

SURVEYOR'S CERTIFICATION:
TO HOME ABSTRACT AND TITLE COMPANY, OLD REPUBLIC NATIONAL TITLE INSURANCE COMPANY, KING LONG TOL AND PHILLIPS PETROLEUM COMPANY:



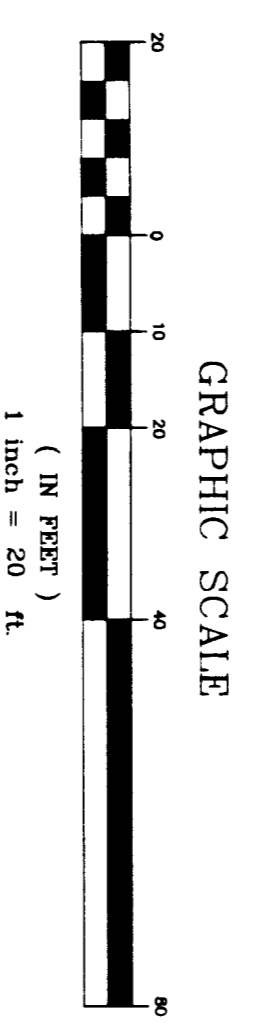


EXCEPTIONS PER HOME ABSTRACT AND TITLE COMPANY COMMITMENT NO. 107335, DATED DECEMBER 3, 1996:
[1] RIGHT-WAY-EASEMENT DATED MAY 10, 1973, IN FAVOR OF THE MOUNTAIN STATES TELEPHONE & TELEGRAPH COMPANY OVER WEST 5 FEET, AS RECORDED NOVEMBER 1, 1973 IN BOOK 1038, PAGE 763, RECORDS OF WEBER COUNTY, UTAH.
PER FLOOD INSURANCE RATE MAP FOR THE CITY OF OGDEN, COMMUNITY PANEL NO. 490189 0003 B, DATED JANUARY 19, 1983, THIS PROPERTY IS NOT LOCATED IN ANY FLOOD ZONES.
BENCHMARK = MONUMENT IN THE NORTHWEST CORNER OF WALL AND 12TH = 4280.97.

UTILITY INFORMATION

ELECTRICAL:	UTAH POWER
TELEPHONE:	(801) 389-2131
WATER:	OGDEN CITY WATER DEPARTMENT
TELEPHONE:	(801) 629-8321
FUEL:	MOUNTAIN FUEL
TELEPHONE:	(801) 621-3262
SANITARY SEWER:	OGDEN CITY SEWER DEPARTMENT
TELEPHONE:	(801) 629-8271

NARRATIVE:
THE CLIENT REQUESTED A SURVEY/CERTIFICATE TO SATISFY THE BASIS OF BEARING FOR THIS SURVEY WAS THE OGDEN CITY SURVEYOR'S OFFICE/EDUCATION.

DEC 17 1996

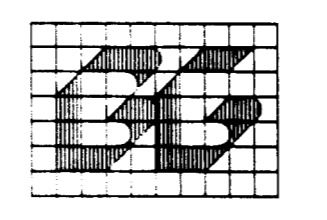

No.	Date	By	Revision