

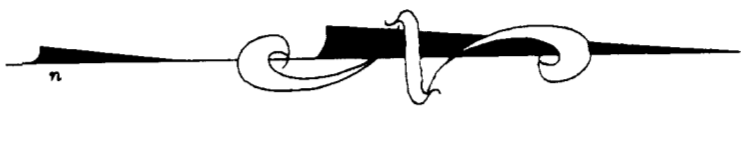


C:\SDSK\PROJ\45087a2.dwg Mon Sep 28 14:46:15 1998

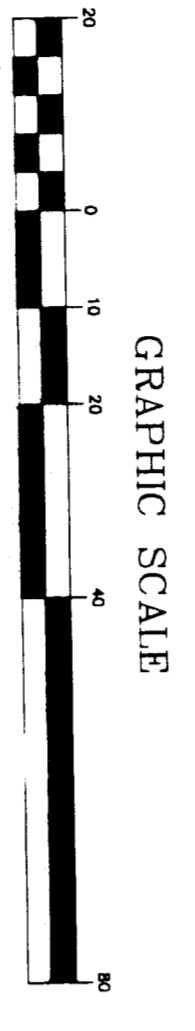

SYMBOL LEGEND	
☉	LIGHT POLE
⊖	WATER VALVE
⊕	SEWER MANHOLE
⊗	STORM DRAIN MANHOLE
⊙	WATER MANHOLE
⊚	TELEPHONE DIGITAL
⊛	CATCH BASIN
⊜	UTILITY POLE
⊝	ORILL & SIGN
⊞	ORDER BOX
⊟	SON
⊠	HANDICAP PARKING
⊡	TELEPHONE MANHOLE
⊢	TRANSFORMER

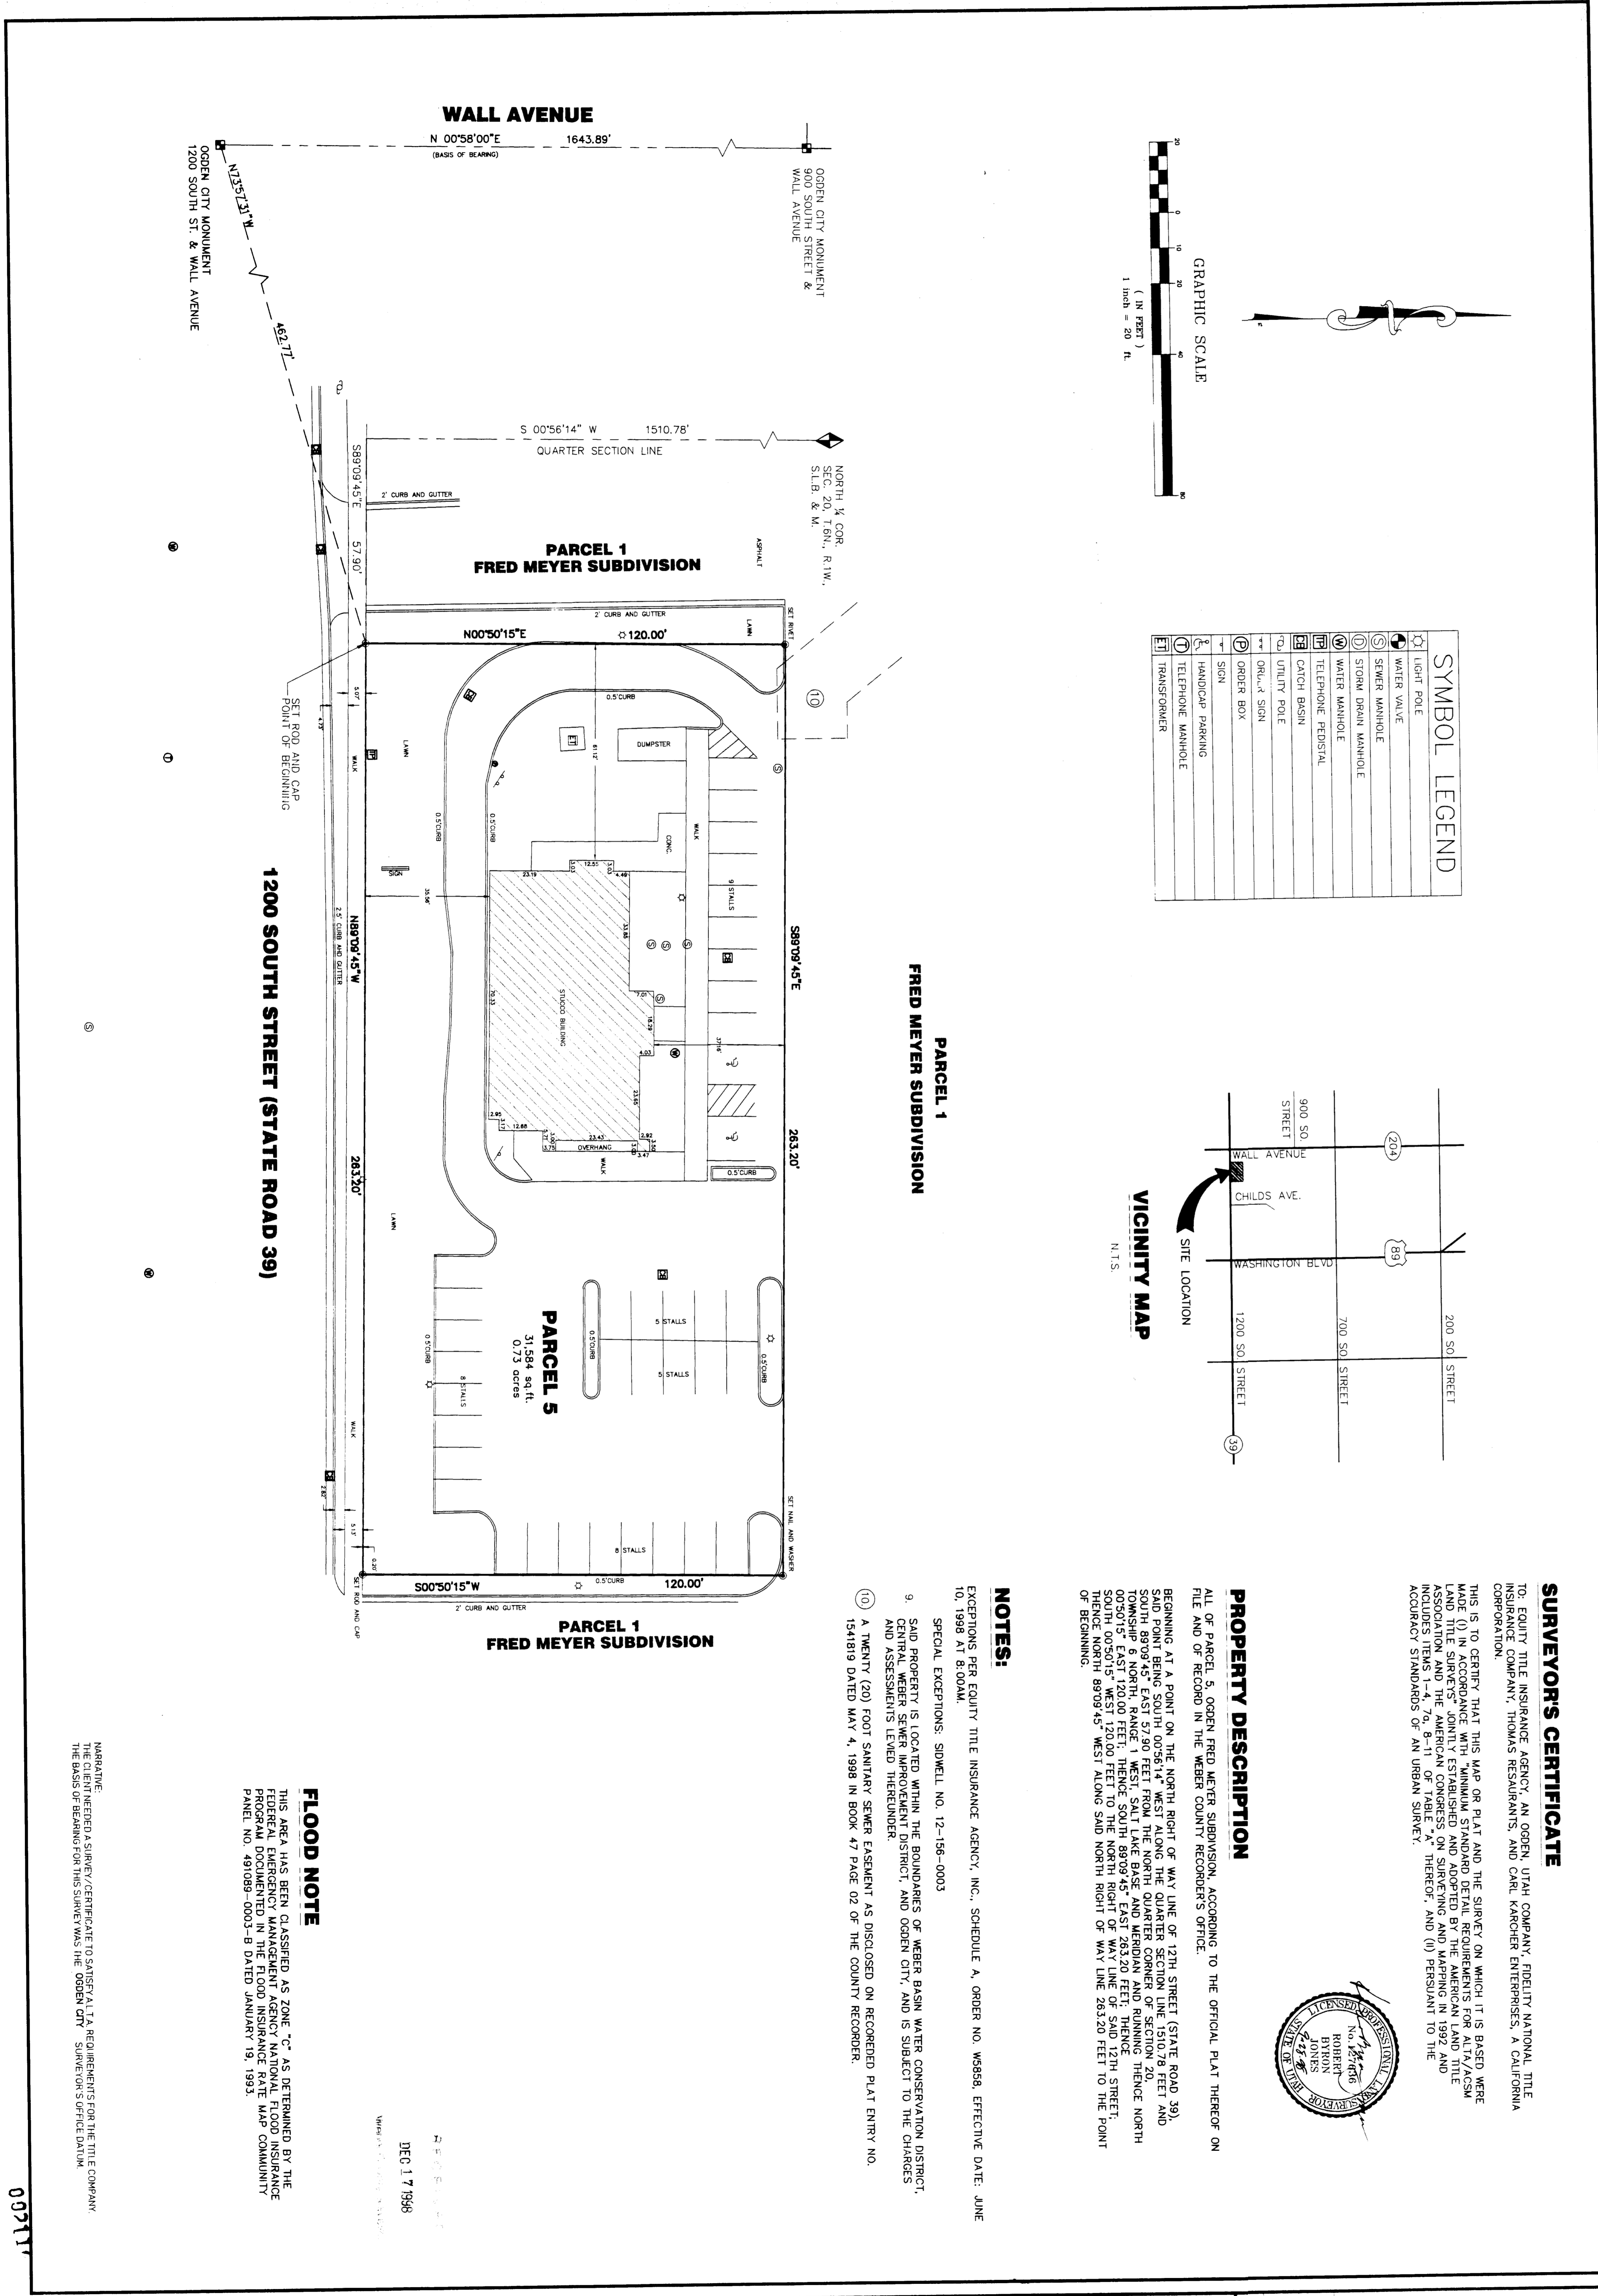

**PARCEL 1
FRED MEYER SUBDIVISION**

NOTES:
EXCEPTIONS PER EQUITY TITLE INSURANCE AGENCY, INC., SCHEDULE A, ORDER NO. W6558, EFFECTIVE DATE: JUNE 10, 1998 AT 8:00AM.
SPECIAL EXCEPTIONS: SIDWELL NO. 12-156-0003
9. SAID PROPERTY IS LOCATED WITHIN THE BOUNDARIES OF WEBER BASIN WATER CONSERVATION DISTRICT, SUDPARAWEYER SEWER IMPROVEMENT DISTRICT, AND OGDEN CITY, AND IS SUBJECT TO THE CHARGES AND ASSESSMENTS LEVIED THEREUNDER.
10. A TWENTY (20) FOOT SANITARY SEWER EASEMENT AS DISCLOSED ON RECORDED PLAT ENTRY NO. 1541819 DATED MAY 4, 1998 IN BOOK 47 PAGE 02 OF THE COUNTY RECORDER.


PROPERTY DESCRIPTION

ALL OF PARCEL 5, OGDEN FRED MEYER SUBDIVISION, ACCORDING TO THE OFFICIAL PLAT THEREOF ON FILE AND OF RECORD IN THE WEBER COUNTY RECORDER'S OFFICE.



SURVEYOR'S CERTIFICATE

TO: EQUITY TITLE INSURANCE AGENCY, AN OGDEN, UTAH COMPANY, FIDELITY NATIONAL TITLE INSURANCE COMPANY, THOMAS RESTAURANTS, AND CARL KASCHER ENTERPRISES, A CALIFORNIA CORPORATION.
7-9, B-11 OF TABLE X HEREOF, AND (D) PRESENT TO THE ACCURACY STANDARDS OF AN URBAN SURVEY.

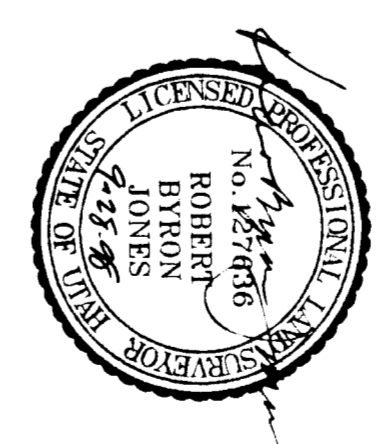

FLOOD NOTE

THIS AREA HAS BEEN CLASSIFIED AS ZONE "C" AS DETERMINED BY THE FEDERAL EMERGENCY MANAGEMENT AGENCY NATIONAL FLOOD INSURANCE PROGRAM DOCUMENTED IN THE FLOOD INSURANCE RATE MAP COMMUNITY PANEL NO. 491089-0003-B DATED JANUARY 19, 1993.

DEC 17 1998

ALTA/ACSM SURVEY
PREPARED FOR THOMAS RESTAURANTS
LOCATION: PART OF THE NORTH 1/4 OF SEC. 20, T6N, R1W, S.L.B. & M.
180 12TH STREET, OGDEN, UTAH

Drawn: [] Date: 08/28/98
Designed: []
Checked: []
Approved: []
Scale: AS NOTED
Job No.: 45087

BUSH & GUDGELL, INC.
Engineers - Planners - Surveyors
555 South 300 East, Salt Lake City, Utah 84111
(801) 364-1212 Fax (801) 364-1225
Offices: St. George, Utah

No.	Date	By	Revised

002116

002116