CONTAINING 3.2 ACRES, MORE OR LESS. PARCEL "B" A PART OF LOT 25, IN SECTION 16, TOWNSHIP 6 NORTH, RANGE 2 WEST, SALT LAKE BASE AND MERIDIAN. BASIS OF BEARINGS BEING S. 0° 48' 58" W. 2652.51 FEET ALONG THE EAST MONUMENTED LINE OF THE SOUTHEAST QUARTER OF SAID SECTION 16, RE-ESTABLISHED SOUTHEAST CORNER OF SAID SECTION 16 DEGINNING AT THE SOUTHWEST CORNER OF SAID SECTION 16: N. 4° 40'24" W. (N. 5° 24' W.) 254.04 FEET ALONG THE WEST LINE OF SAID LOT 25, THENCE N. 85° 19' 36" E. 534.62 FEET TO A FENCE, THENCE THREE COURSES ALONG SAID FENCE AS FOLLOWS, S. 17° 15' 47" W. 91.95 FEET, S. 13° 02' 30" E. 142.71 FEET AND S. 22° 20' 53" E. 58.69 FEET TO A POWER POLE FENCE CORNER POST, THENCE S. 14° 12' 49" E. 7.63 FEET TO THE SOUTH LINE OF SAID LOT 25, THENCE S. 89° 07' 36" W. (S. 88° 24' W.) 541.31 FEET TO THE POINT OF BEGINNING. CONTAINING 3.2 ACRES, MORE OR LESS. PARCEL "C" A PART OF LOT 15, IN SECTION 16, AND A PART OF THE SOUTHWEST QUARTER OF SECTION 15, TOWNSHIP 6 NORTH, RANGE 2 WEST, SALT LAKE BASE AND MERIDIAN. BASIS OF BEARINGS BEING S. 0° 48' 58" W. 2652.51 FEET ALONG THE EAST MONUMENTED LINE OF THE SOUTHEAST QUARTER OF SAID SECTION 16, RE-ESTABLISHED SOUTHEAST CORNER OF SAID SECTION 16 DEING S. 0° 43' 36" W. (SOUTH) 2641.3 FEET FROM THE EAST QUARTER CORNER (STONE REPLACED BY A COUNTY MONUMENT) OF SAID SECTION 16: BEGINNING AT A POINT ON THE RE-ESTABLISHED SECTION LINE S. 0° 43' 36" W. (SOUTH) 1447.68 FEET FROM SAID EAST QUARTER CORNER, SAID POINT OF BEGINNING ALSO BEING N. 0° 43' 36" E. (NORTH) 51.72 FEET FROM THE SOUTHEAST CORNER OF SAID LOT 15, AND RUNNING THENCE N. 80° 44' 53" W. 1084.30 FEET TO THE WEST LINE OF SAID LOT 15, THENCE N. 9° 23' 36" E. (N. 8° 40' E.) 361.48 FEET ALONG SAID LOT LINE, THENCE S. 81° 54' 24" E. (S. 82° 38' E.) 129.30 FEET, THENCE N. 48° 03' 36" E. (N. 47° 20' E.) 266.00 FEET, THENCE N. 17° 13' 36" E. (N. 16° 30' E.) 189.84 FEET TO A FENCE, THENCE FIVE COURSES ALONG SAID FENCE AS FOLLOWS: S. 86° 14' 20" E. 63.44 FEET, S. 81° 47' 25" E. 571.63 FEET, S. 83° 38' 53" E 452.20 FEET, S. 4° 41' 15" W. 559.40 FEET AND S. 80° 41' 14" E. 228.18 FEET, THENCE S. 0° 43' 36" W. (SOUTH) 243.54 FEET TO A POINT THAT BEARS S. 80° 44' 53" E. OF THE POINT OF BEGINNING, THENCE N. 80° 44' 53" W. 634.01 FEET TO THE POINT OF BEGINNING. CONTAINING 24.54 ACRES, MORE OR LESS. PARCEL "D" A PART OF LOTS 25 AND 15 IN SECTION 16 AND A PART OF THE SOUTHWEST QUARTER OF SECTION 15, TOWNSHIP 6 NORTH, RANGE 2 WEST, SALT LAKE BASE AND MERIDIAN. BASIS OF BEARINGS BEING S. 0° 48' 58" W. 2652.51 FEET ALONG THE EAST MONUMENTED LINE OF THE SOUTHEAST QUARTER OF SAID SECTION 16. RE-ESTABLISHED SOUTHEAST CORNER OF SAID SECTION 16 BEING S. 0° 43' 36" W. (SOUTH) 2641.3 FEET FROM THE EAST QUARTER CORNER (STONE REPLACED BY COUNTY MONUMENT) OF SAID SECTION 16: BEGINNING AT A POINT ON SAID RE-ESTABLISHED SECTION LINE THAT BEARS S. 0° 43' 36" W. (SOUTH) 2267.40 FEET FROM SAID EAST QUARTER CORNER OF SECTION 16, SAID POINT OF BEGINNING BEING THE SOUTHEAST CORNER OF SAID LOT 25, AND RUNNING THENCE S. 89° 07' 36" W. (S. 88° 24' W.) 445.80 FEET ALONG THE SOUTH LINE OF SAID LOT 25, THENCE N. 0° 43' 36" E. (NORTH) 41.5 FEET, THENCE N. 14º 12' 49" W. 7.63 FEET TO A POWER POLE FENCE CORNER POST, THENCE NINE COURSES ALONG SAID FENCE AS FOLLOWS: N. 22° 20' 53" W. 58.69 FEET, N. 13° 02' 30" W. 142.71 FEET, N. 17° 15' 47" E. 117.82 FEET, N. 10° 37' 07" E. 67.20 FEET, N. 32° 30' 53" W. 148.62 FEET, N. 41° 28' 46" W. 30.96 FEET, N. 55° 32' 33" W. 36.45 FEET AND S. 85° 29' 15" W. 155.37 FEET, THENCE N. 4° 40' 24' W. (N. 5° 24' W.) 148.49 FEET, THENCE S. 85° 19' 36" W. (S.84° 36' W.) 290.40 FEET TO THE WEST LINE OF SAID LOT 25, THENCE N. 4° 40' 24" W. (N. 5° 24' W.) 276.38 FEET TO THE NORTHWEST CORNER OF LOT 25, THENCE N. 9° 23' 36" E. (N. 8° 40' E.) 23.62 FEET ALONG THE WEST LINE OF LOT 15, THENCE S. 80° 44' 53" E. 1718.31 FEET, THENCE S. 0° 43' 36" W. (SOUTH) 713.58 FEET, THENCE N. 89° 16' 24" W. (WEST) 627.00 FEET TO SAID REESTABLISHED QUARTER SECTION LINE, THENCE S. 0° 43' 36" W. (SOUTH) 12.15 FEET TO THE POINT OF BEGINNING. CONTAINING 24.54 ACRES, MORE OR LESS. SURVEYOR'S CERTIFICATE I, CYNTHIA L ROBINETT DO HEREBY CERTIFY THAT I AM A REGISTERED LAND SURVEYOR, AND THAT I HOLD CERTIFICATE No. 7511 AS PRESCRIBED BY THE LAWS OF THE STATE OF UTAH. AND THAT I HAVE MADE A SURVEY ON THE GROUND, AND FROM RECORDS OF THE WEBER COUNTY RECORDERS OFFICE AS DESCRIBED ABOVE AND SHOWN PER THIS PLAT. 6-4-89 DATE R.L.S. No. 7511

<u>N A R R A T I V E</u>

BOUNDARIES OF THE JOHN E. DANCE PROPERTY, STUATED IN WEBER

HANSEN. BASIS OF BEARING IS STATE PLANE GRID BEARING S. 00 48' 50" W. ALONG THE EAST LINE (AS MONUMENTED) OF THE SOUTHEAST QUARTER OF SECTION 16, TOWNSHIP 6 NORTH, RANGE 2

WEST, SALT LAKE BASE AND MERIDIAN. THE REASON FOR THE RE-

EXISTING MONUMENTED SOUTHEAST CORNER DID NOT FIT THE LOT

LINES SHOWN PER THE 1899 PLAT (BOOK & PAGE 72) OF SAID SECTION 16, BUT FOUND BY USING THE EAST QUARTER CORNER

MONUMENT (A STONE REPLACED BY A COUNTY MONUMENT STAMPED

1988) AND THE SOUTHWEST CORNER OF SAID SECTION 16 AS MONUMENTED SHOWED A CLOSER HARMONY BETWEEN FENCES AND THE LOT LINES SHOWN PER THE 1899 PLATTED SUBDIVISION OF SAID

ESTABLISHED EAST LINE OF SAID SOUTHEAST QUARTER IS THAT THE

COUNTY, FOR THE TRUSTEES ALMYRA D. HANSEN AND ONEITA D.

THE PURPOSE OF THIS SURVEY WAS TO ESTABLISH PARCEL

LEGAL DESCRIPTION

A PART OF LOT 25, IN SECTION 16, TOWNSHIP 6 NORTH, RANGE 2 WEST, SALT LAKE BASE AND MERIDIAN. BASIS OF BEARINGS BEING S. 0° 48' 58" W. 2652.51 FEET ALONG THE EAST MONUMENTED LINE OF THE SOUTHEAST QUARTER OF SAID SECTION 16. RE-ESTABLISHED SOUTHEAST CORNER OF SAID SECTION 16. DELINE S. 0° 47' 7' " " COUNTY 2'4" TEET FROM FAST DUARTER CORNER


BEING S. 0° 43' 36" W. (SOUTH) 2641.3 FEET FROM EAST QUARTER CORNER (STONE REPLACED BY A COUNTY MONUMENT) OF SAID SECTION 16: BEGINNING

AT A POINT N. 4° 40' 24" W. (N. 5° 24' W.) 254.04 FEET FROM THE SOUTHWEST CORNER OF SAID LOT 25, AND RUNNING THENCE N. 4° 40' 24" W. (N. 5° 24' W.) 264.17 FEET ALONG THE WEST LOT LINE OF SAID LOT 25 TO A

(N. 5° 24' W.) 264.17 FEET ALONG THE WEST LOT LINE OF SAID LOT 25 TO A WESTERLY PROJECTION OF A FENCE, THENCE SEVEN COURSES ALONG SAID FENCE AS FOLLOWS, N. 84° 25' 15" E. 274.64 FEET, N. 85° 29' 15" E. 171.16 FEET, S. 55° 32' 33" E. 36.45 FEET, S. 41° 28' 46" E. 30.96 FEET, S. 32° 30' 53" E. 148.62 FEET, S. 10° 37' 07" W. 67.20 FEET AND S. 17° 15' 47" W. 25.87 FEET TO A POINT THAT BEARS N. 85° 19' 36" E. FROM THE POINT OF BEGINNING, THENCE S. 85° 19' 36" W. 534.62 FEET TO THE POINT OF BEGINNING

PARCEL "A"

POINT OF BEGINNING.

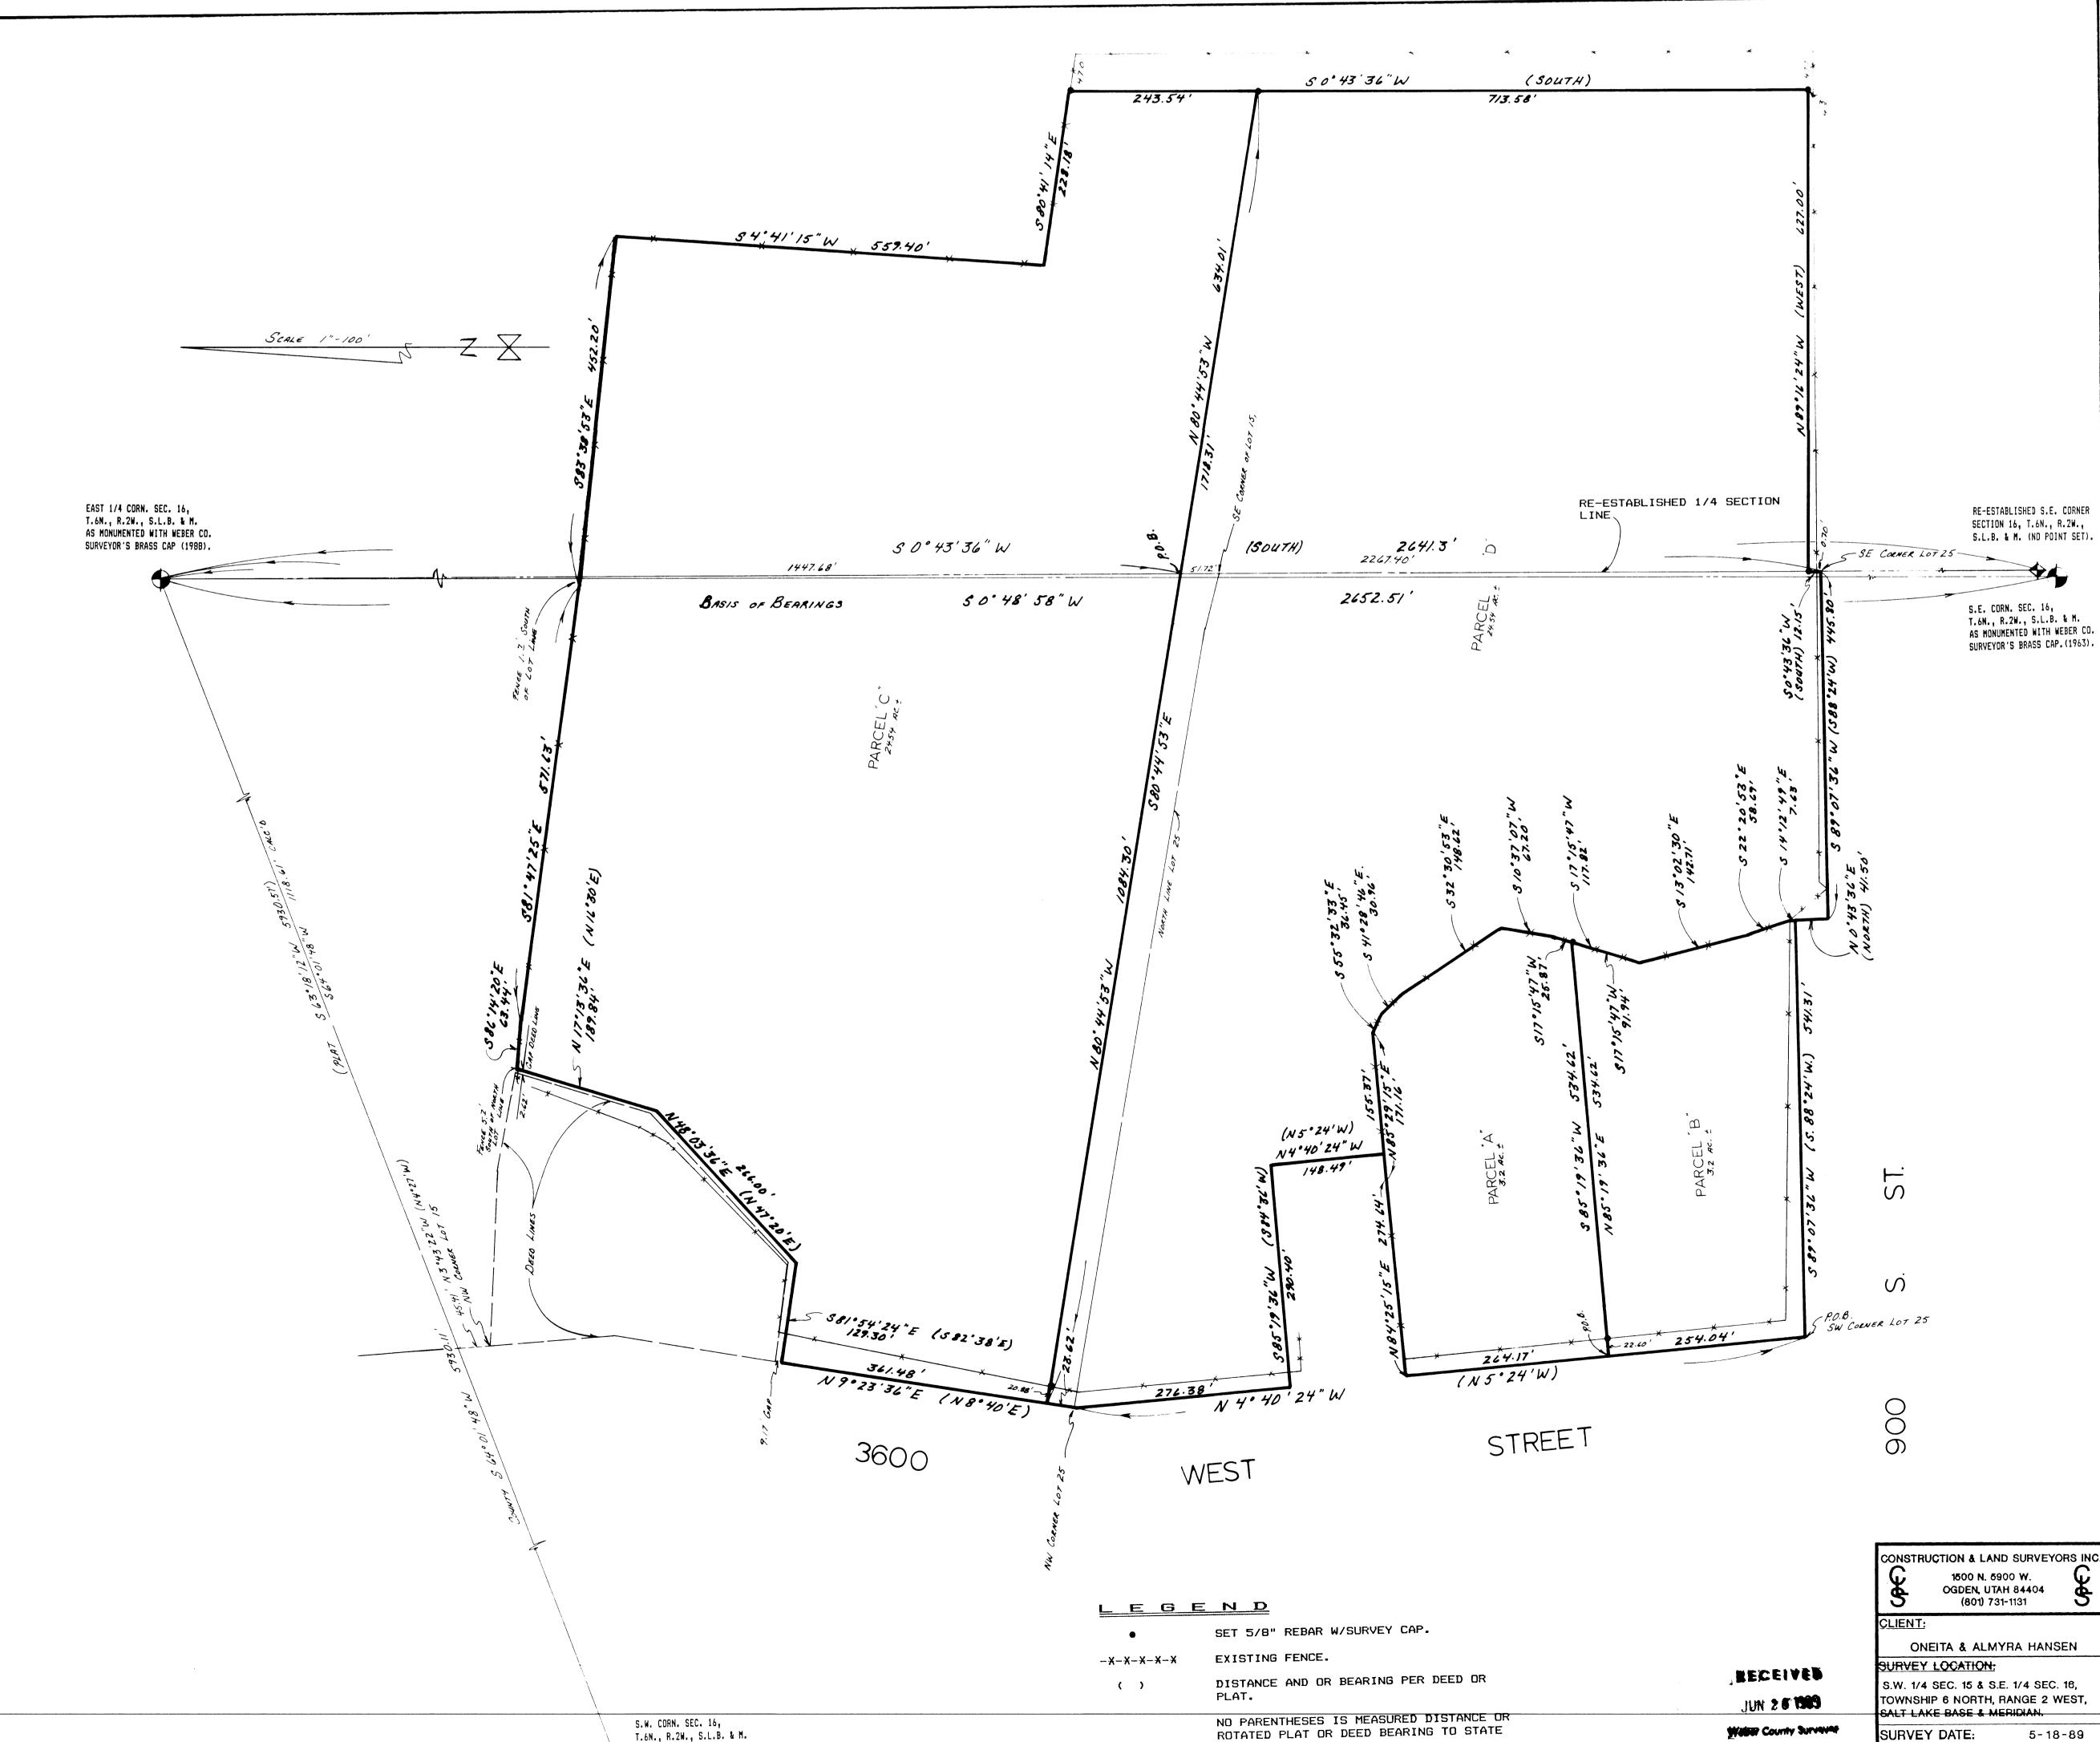

PLANE GRID BEARING.

T.6N., R.2W., S.L.B. & M.

AS MONUMENTED WITH WEBER CO.

SURVEYOR'S BRASS CAP. (1963)

Water County Surveyer

SURVEY DATE:

JOB No.

5-18-89

P.S.89-08