

1.	REVISIONS
2.	
3.	
4.	
5.	
6.	


PROJECT NO. _____ TITLE _____ SURVEYOR _____ ASSESSOR _____
 DATE: 1-1-99 DRAWN: H. GUNN
 SCALE: 1"=50' CHECKED: _____

REEVE & ASSOCIATES, INC.
 ENGINEERS PLANNERS & SURVEYORS
 3870 QUINCY AVE. SUITE NO. 1

RECORD OF SURVEY

KASKOS PROPERTY
 PART OF THE NORTHWEST QUARTER OF SECTION 23 T4N, R1W, S18&M, U.S. SURVEY
 WEBER COUNTY, UTAH
 DECEMBER 1, 1988

SHEET	1
SHEETS	1

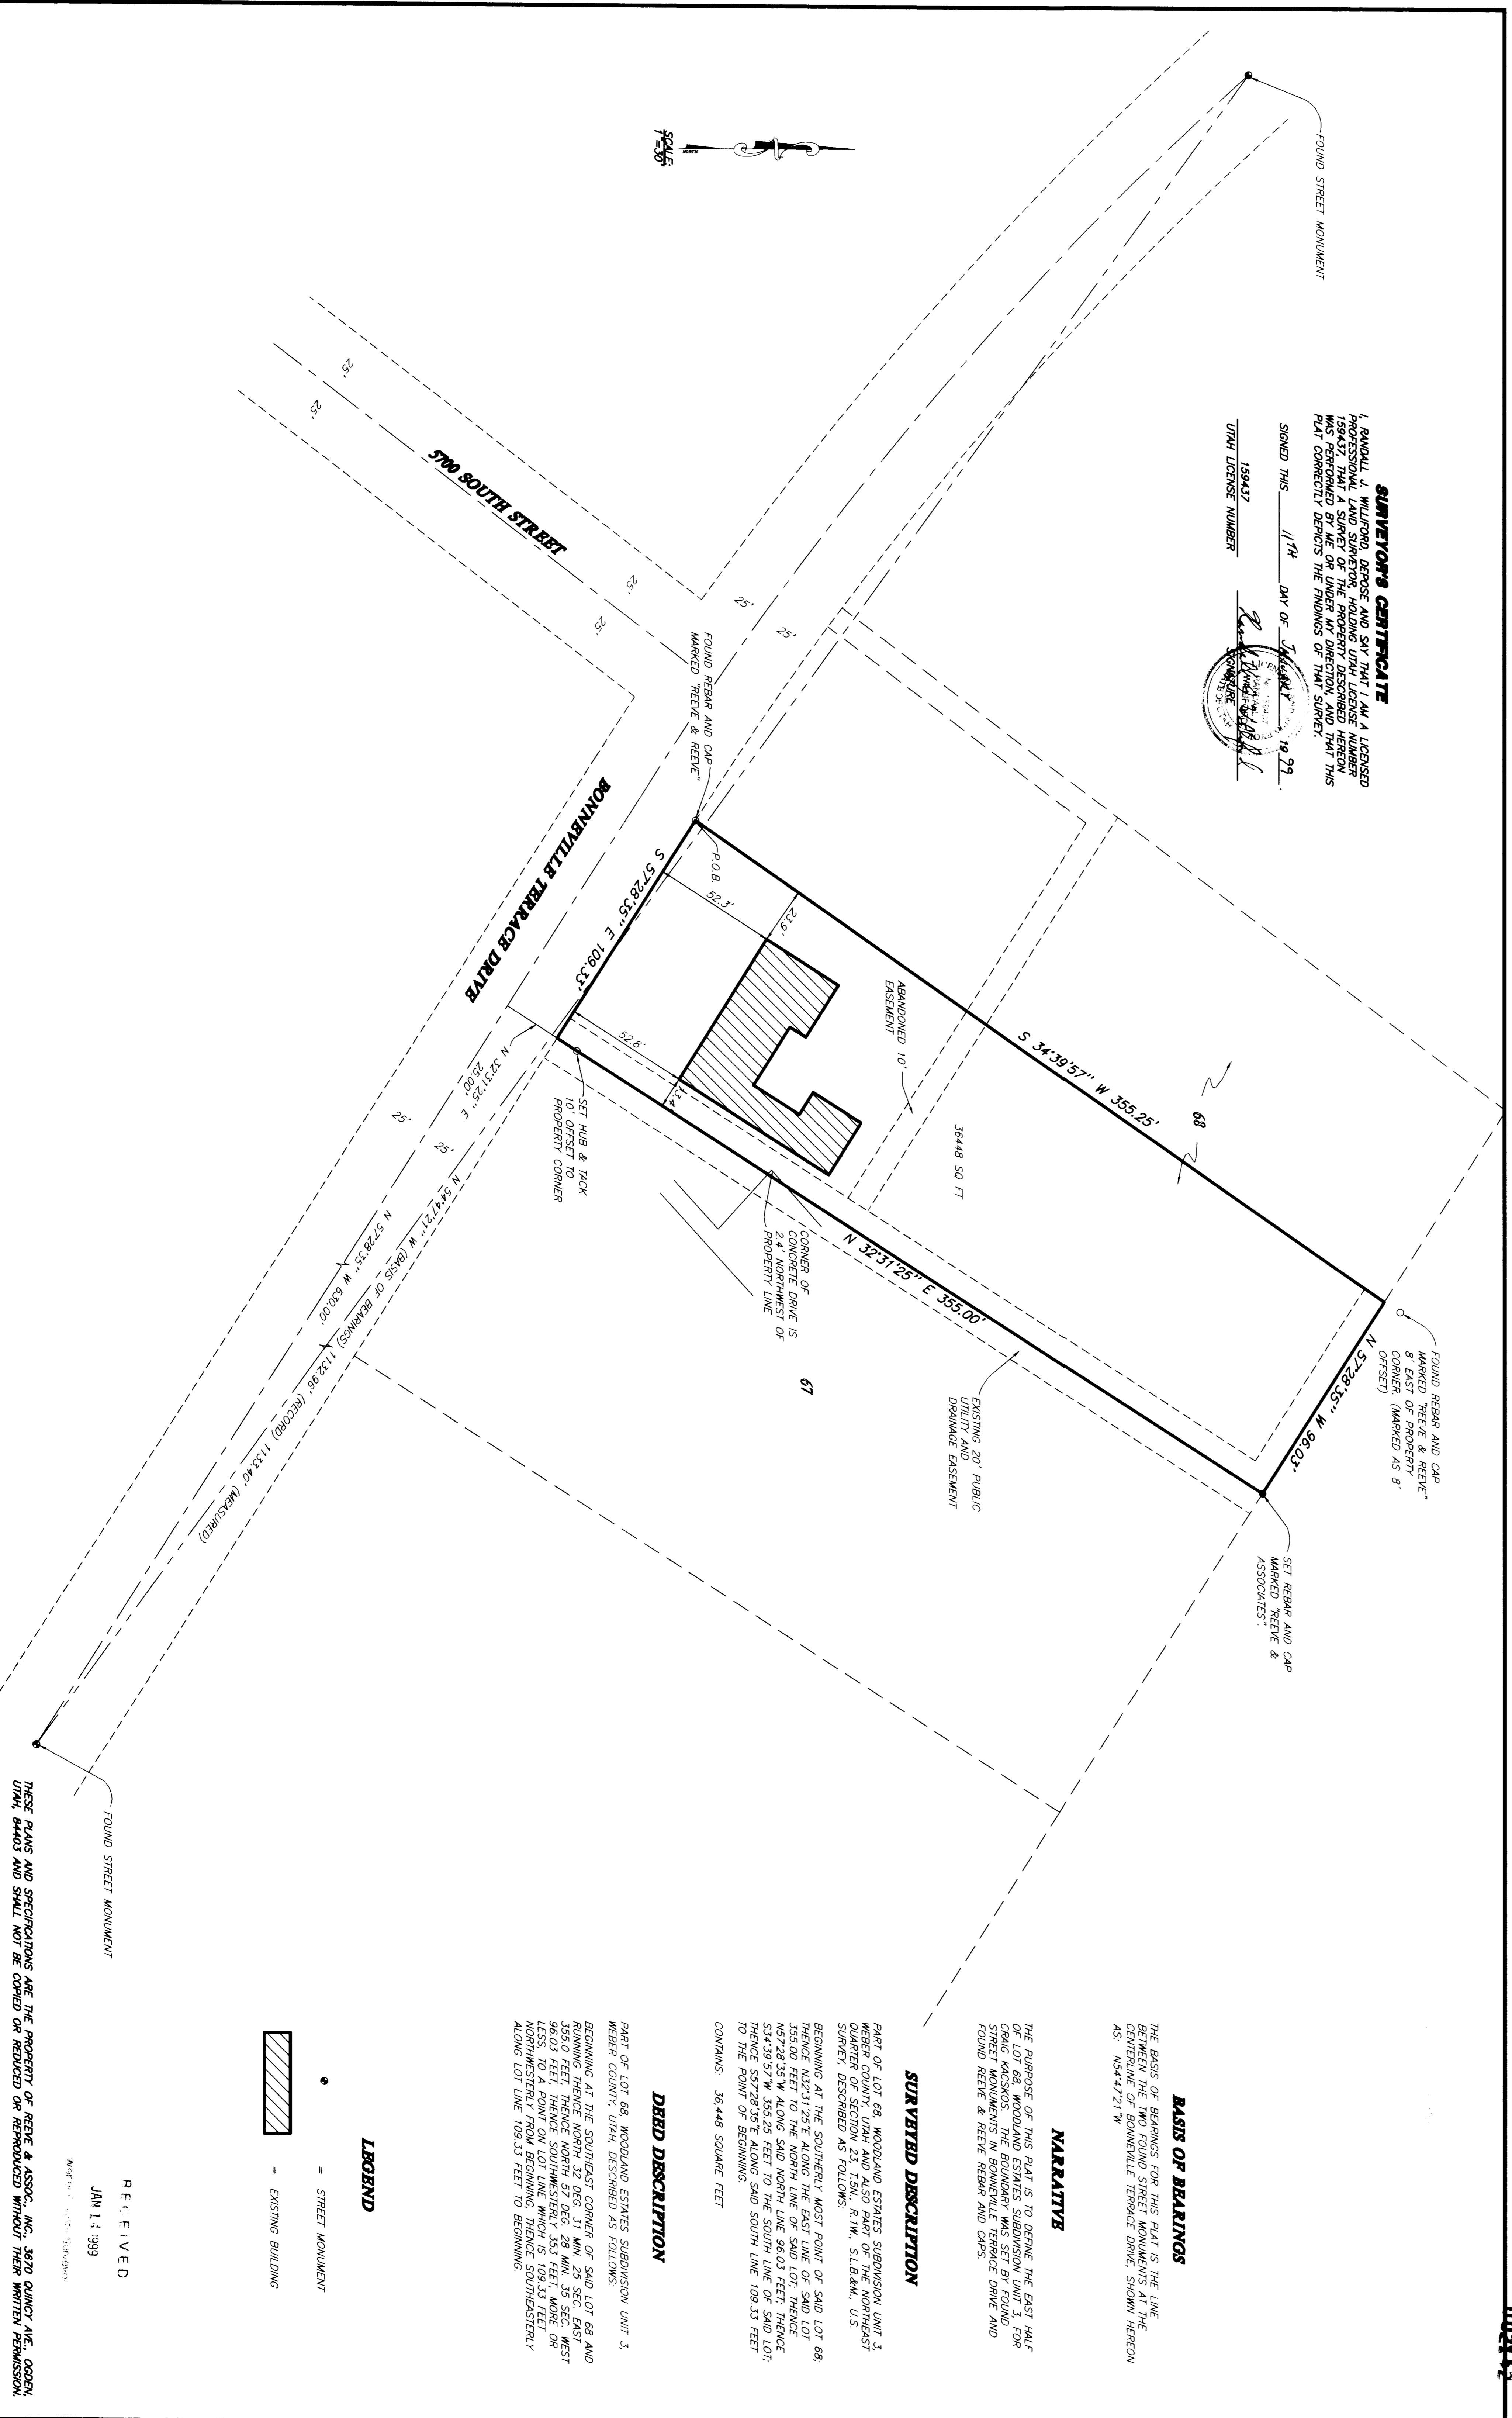

SURVEYOR'S CERTIFICATE
 RANDALL J. WILFORD
 SURVEYOR

BASIS OF BEARINGS


NARRATIVE


SURVEYED DESCRIPTION

PART OF LOT 68, WOODLAND ESTATES SUBDIVISION UNIT 3, WEBER COUNTY, UTAH, DESCRIBED AS FOLLOWS:
 CONTAINS: 36,448 SQUARE FEET

DEED DESCRIPTION

PART OF LOT 68, WOODLAND ESTATES SUBDIVISION UNIT 3, WEBER COUNTY, UTAH, DESCRIBED AS FOLLOWS:

LEGEND

- = STREET MONUMENT
- ▨ = EXISTING BUILDING

R. F. E. V. E. D.
 JAN 11 1999

