DRAWING NUMBER 002144
PLAN HOLD CORPORATION • IRVINE, CALIFORNIA
REORDER BY NUMBER 07548

DRAWING NUMBER 002144
PLAN HOLD CORPORATION • IRVINE, CALIFORNIA
REORDER BY NUMBER 07548

DRAWING NUMBER 002144
PLAN HOLD CORPORATION • IRVINE, CALIFORNIA
REORDER BY NUMBER 07548

DRAWING NUMBER 002144
PLAN HOLD CORPORATION • IRVINE, CALIFORNIA
REORDER BY NUMBER 07548

C:\ACAD14\Dwgs\98n393b.dwg Fri Jan 15 10:17:35 1999 AH

Scale : 1" = 20'

NARRATIVE:
This survey wasrequested by Ms. Karren Long of Latham & Watkins for the purpose of financing. Brass Cap Monuments were found at the Southeast & the East 1/4 corners of Section 17, T5N, R1W, SLB&M. A line bearing North 0°26'00" East (Not State Plane) between these two monuments was used as the basis of bearings. Property corners were monumented as indicated on this drawing.

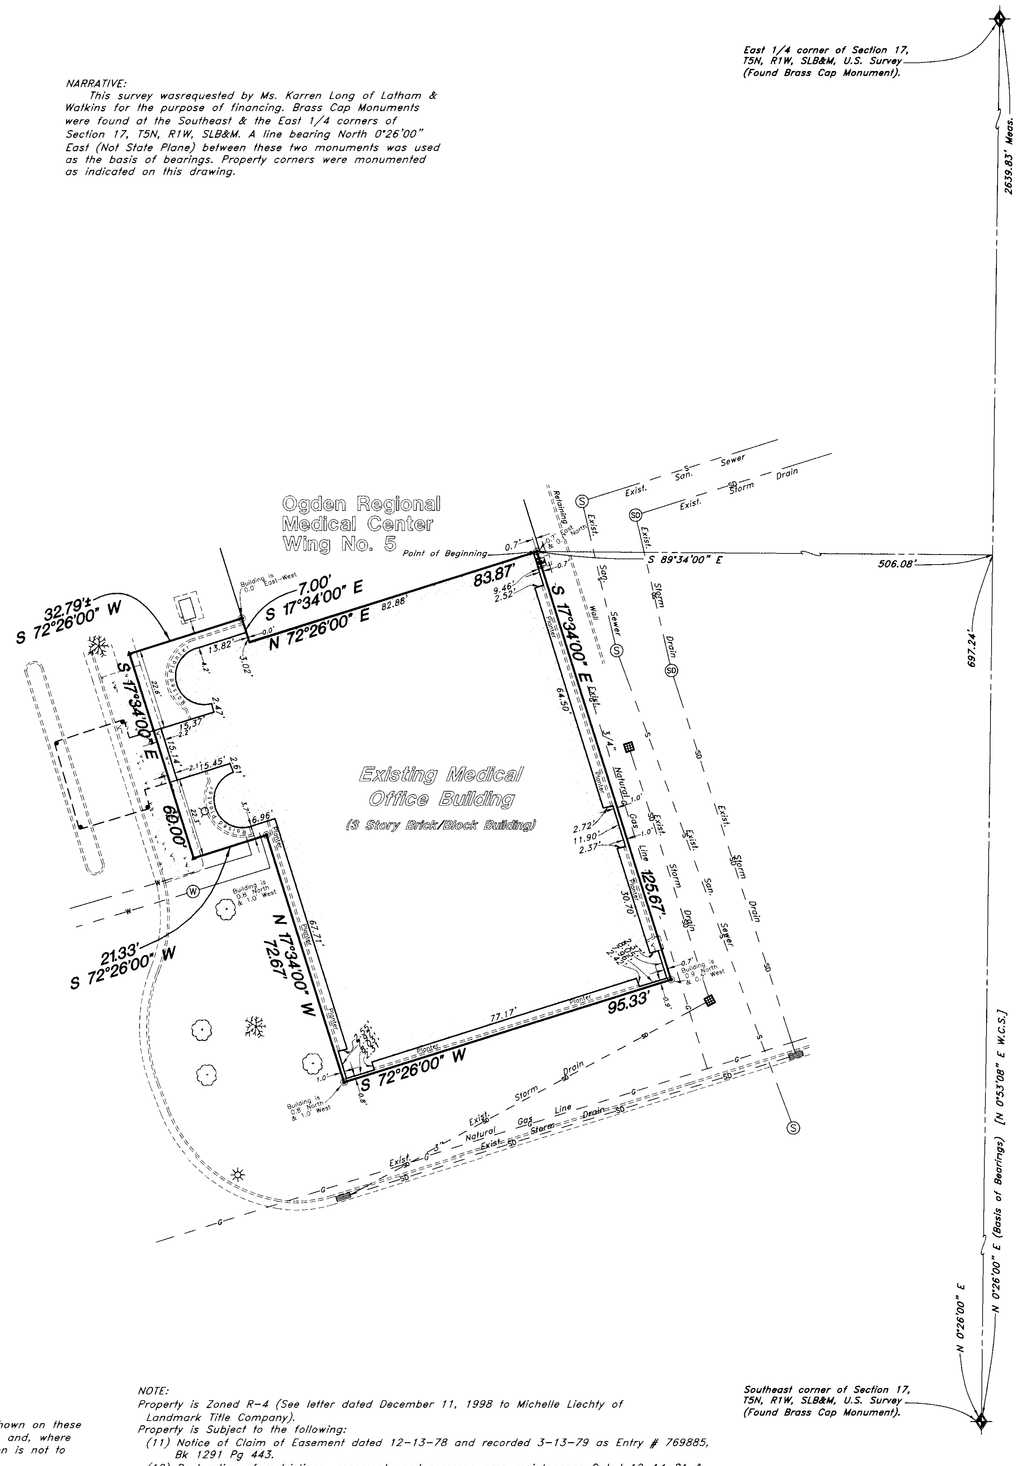
East 1/4 corner of Section 17, T5N, R1W, SLB&M, U.S. Survey (Found Brass Cap Monument).
2639.83' Meas.
S 89°34'00" E
506.08'
697.24'
Ogden Regional Medical Center Wing No. 5
Point of Beginning
0.7'
0.8'
S 72°26'00" W
32.79'±
7.00'
S 17°34'00" E
N 72°26'00" E
82.88'
83.87'
S 17°34'00" E
64.50'
Existing Medical Office Building
(3 Story Brick/Block Building)
S 17°34'00" E
66.00'
S 72°26'00" W
21.33'
N 17°34'00" W
72.67'
125.67'
95.33'
S 72°26'00" W
77.17'
Exist. Natural Gas Line
Exist. Storm Drain
Exist. Sewer
Exist. Storm Drain
Exist. Sewer
Exist. Storm Drain
Exist. Gas Line
Exist. Storm Drain
Exist. Sewer
Exist. Storm Drain
Exist. Storm Drain
Exist. Sewer
Retaining Wall
Top
Bottom
