


1. ION B HILL, A PROFESSIONAL LAND SURVEYOR ACCORDING TO THE LAWS OF THE STATE OF UTAH, DO HEREBY CERTIFY THAT I HAVE SURVEYED THE LOTS AND PARCELS SHOWN ON THIS DRAWING AND THAT I AM A LICENSED LAND SURVEYOR IN THE STATE OF UTAH.



NARRATIVE


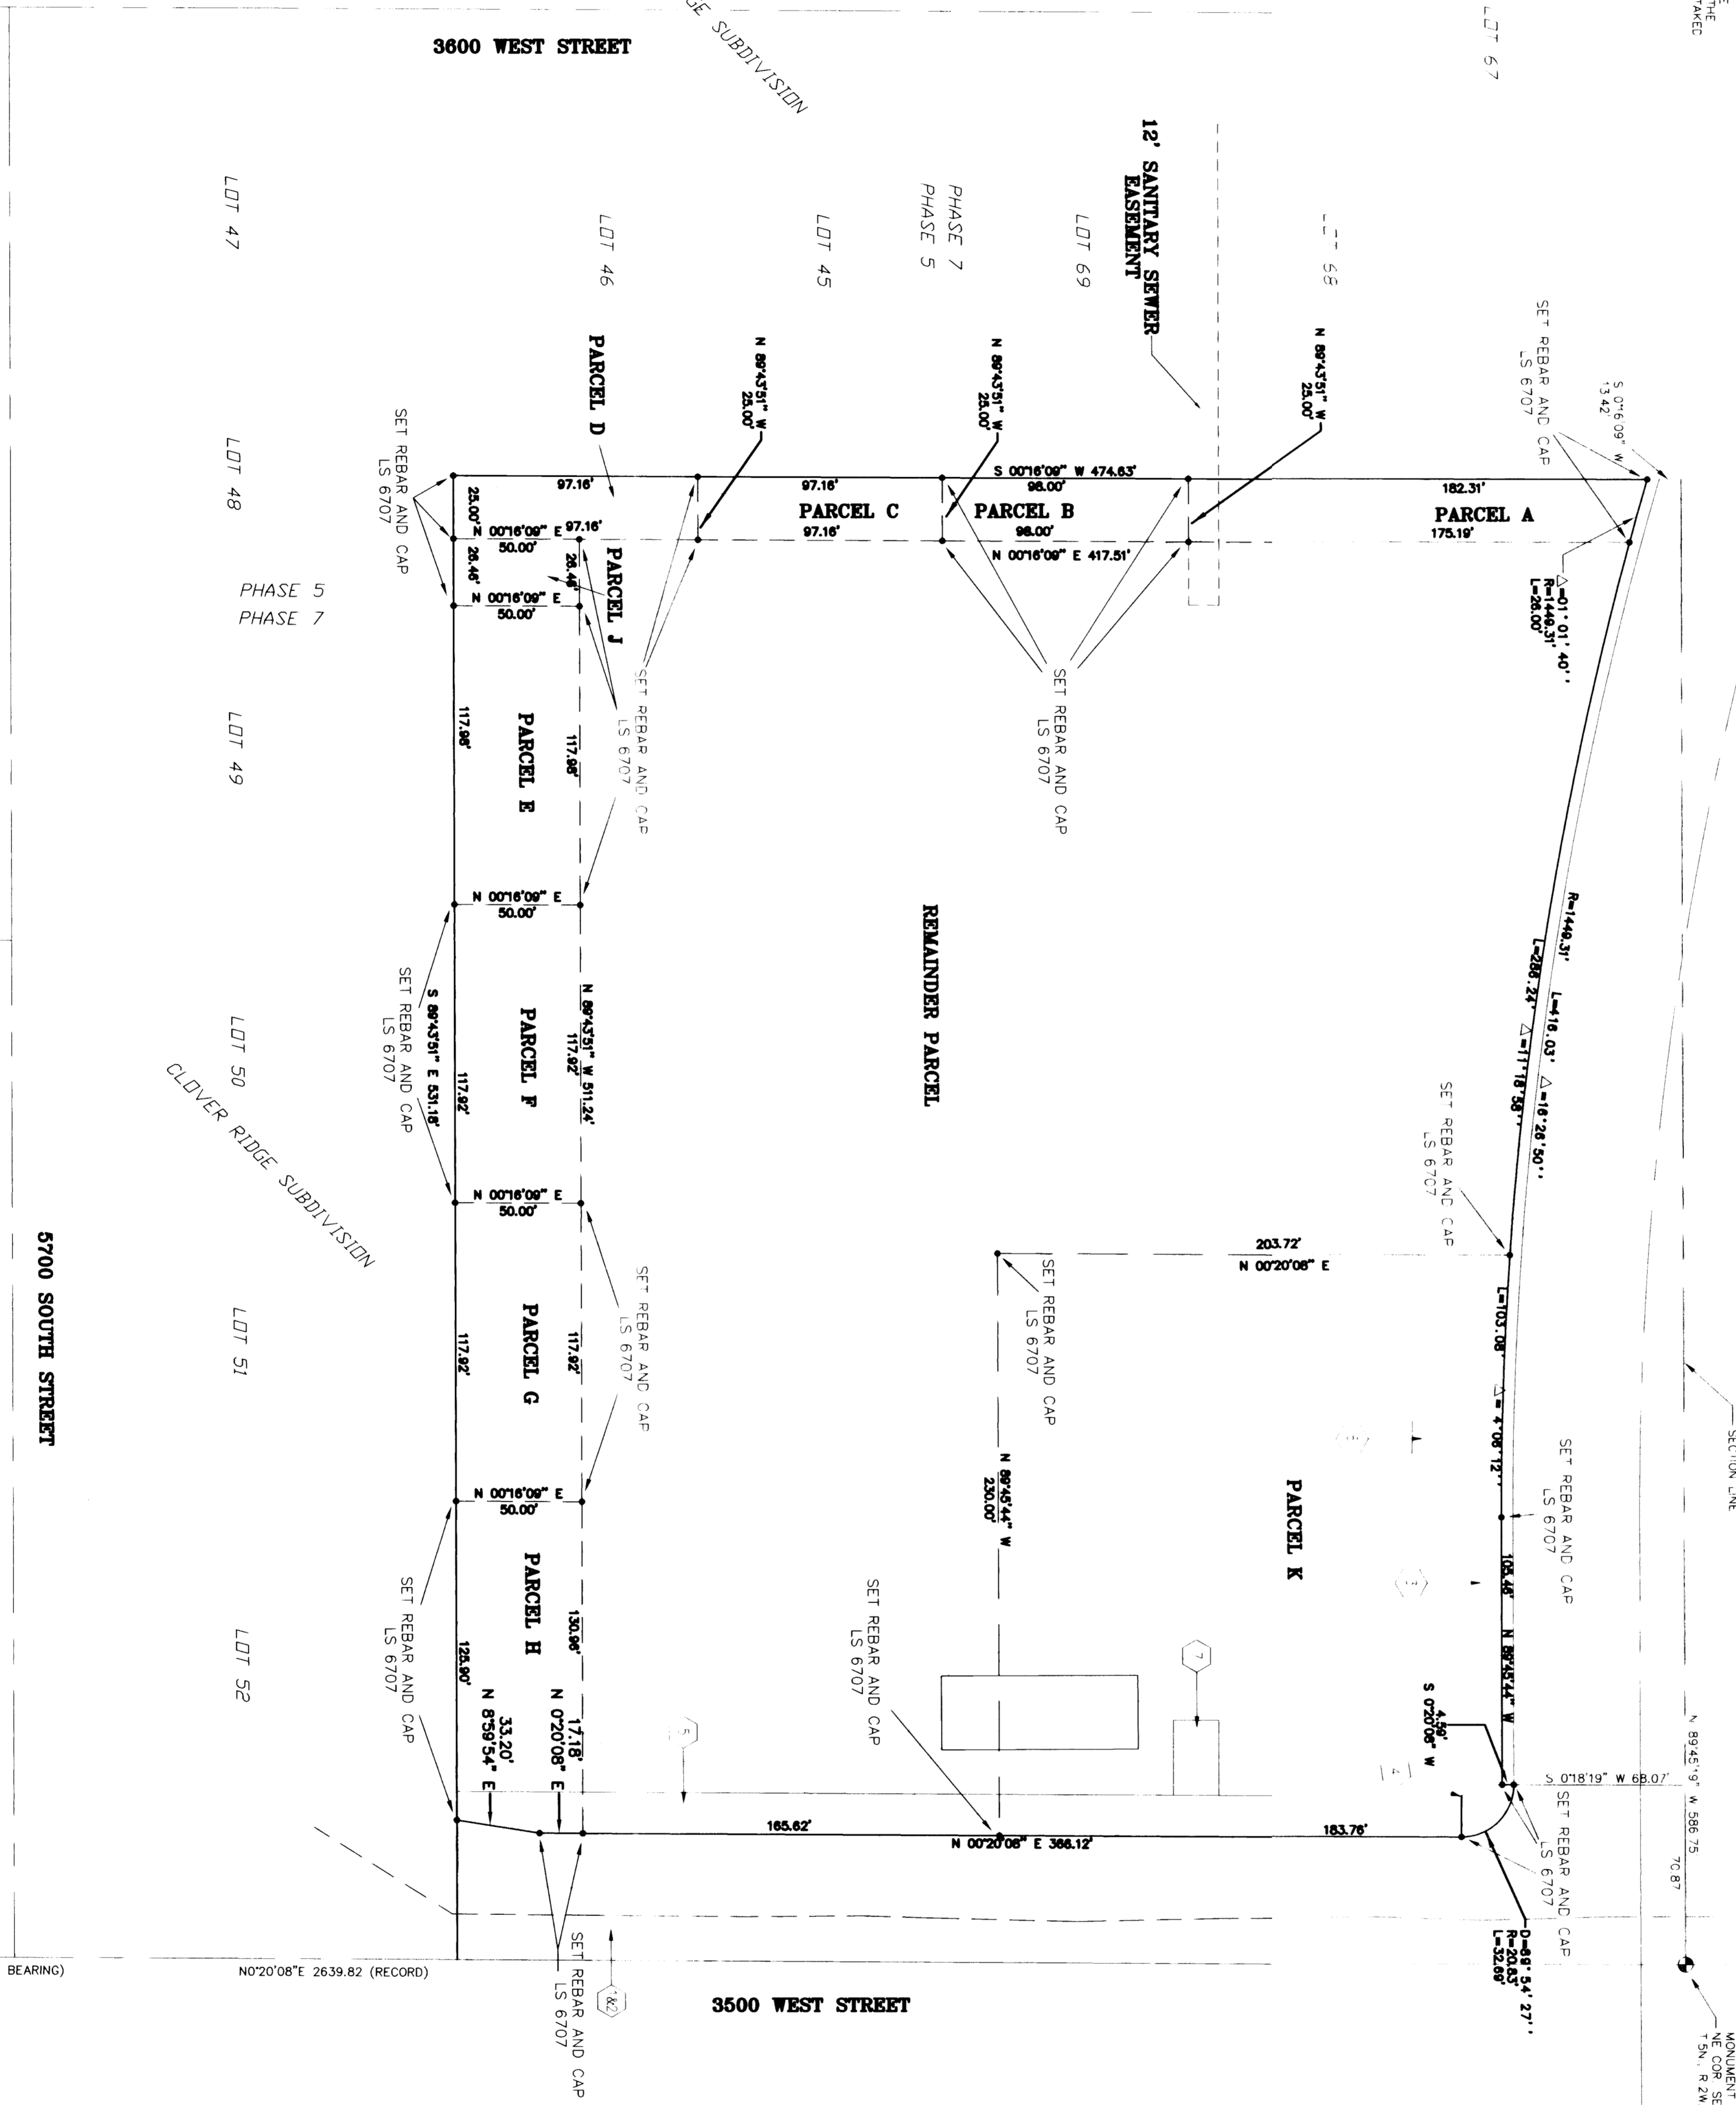

6000 SOUTH STREET

ALICUT SET 20, 1998-REVISED NOVEMBER 11, 1998
DESCRIPTIONS FOR SKY PROPERTIES, 6000 SOUTH PROPERTY



PARCEL A BEGINNING AT THE POINT ON THE EASTERN LINE OF LOT 46, CLOVER RIDGE, PHASE 5 SUBDIVISION, WHICH POINT IS N 89° 45' 19" W 296.75 FEET FROM THE SECTION CORNER AND S 0° 16' 09" W 488.05 FEET AND S 87° 47' 51" E 514.46 FEET FROM THE NORTHEAST CORNER OF SECTION 21, TOWNSHIP 5 NORTH, RANGE 2 WEST, SALT LAKE BASE AND MERIDIAN, THENCE S 87° 47' 51" E 514.46 FEET TO THE POINT OF BEGINNING CONTAINING 2480 SQUARE FEET.

























PREPARED FOR: SKY PROPERTIES RECORD OF SURVEY PART OF THE N.E. 1/4 SEC. 21, T. 5N., R. 2W., S.L.B. & M. ROY CITY, WEBER COUNTY, UTAH

HJA Hill, Jamison and Associates, Inc. Engineering and Surveying 181 North 200 West, Bountiful, Utah 84010 (801)298-2236