

Scale : 1" = 50'

BOUNDARY DESCRIPTION


All of Lot 106, Causey Estates Subdivision No. 2, Weber County, Utah according to the official plat thereof.

CERTIFICATION

I, Mark E. Babbitt, do hereby certify that I am a Registered Professional Land Surveyor, and that I hold Certificate No. 166484, as prescribed by the Laws of the State of Utah, and I have made a survey of the above described property. I further certify that the above plat correctly shows the true dimensions of the property surveyed.

Date: 2-6-99

Mark E. Babbitt
Mark E. Babbitt

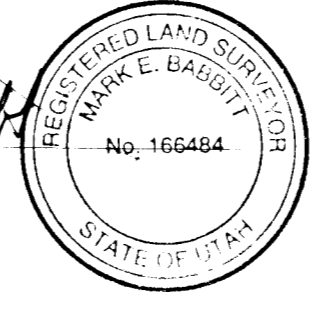

Narrative

This property Survey was requested by Jane Errion in order to establish her property corners. Several corners were found and used for control. Lot corners were monumented as depicted on this drawing.

Property Survey

Jane Errion

Lot 106, Causey Estates Subdivision No. 2, Weber County, Utah

A part of the Northeast 1/4 of Section 10, T6N, R3E, SLB&M, U.S. Survey

GREAT BASIN ENGINEERING NORTH
CONSULTING ENGINEERS and SURVEYORS
3544 Lincoln Avenue, Ogden, Utah, 84401
P.O. Box 9307, Ogden, Utah, 84409
Ogden (801)384-4515 Salt Lake City (801)521-0222 Fax (801)392-7544

DATE : 4 Aug, 1998
DRAWN : MM
SCALE : 1" = 50'

REVISIONS : 98N401A

DRWG. NO.

1