

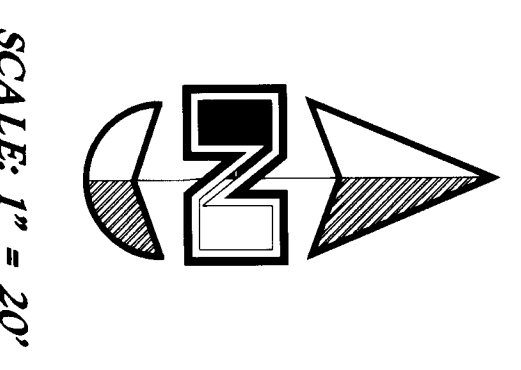


NOTICE

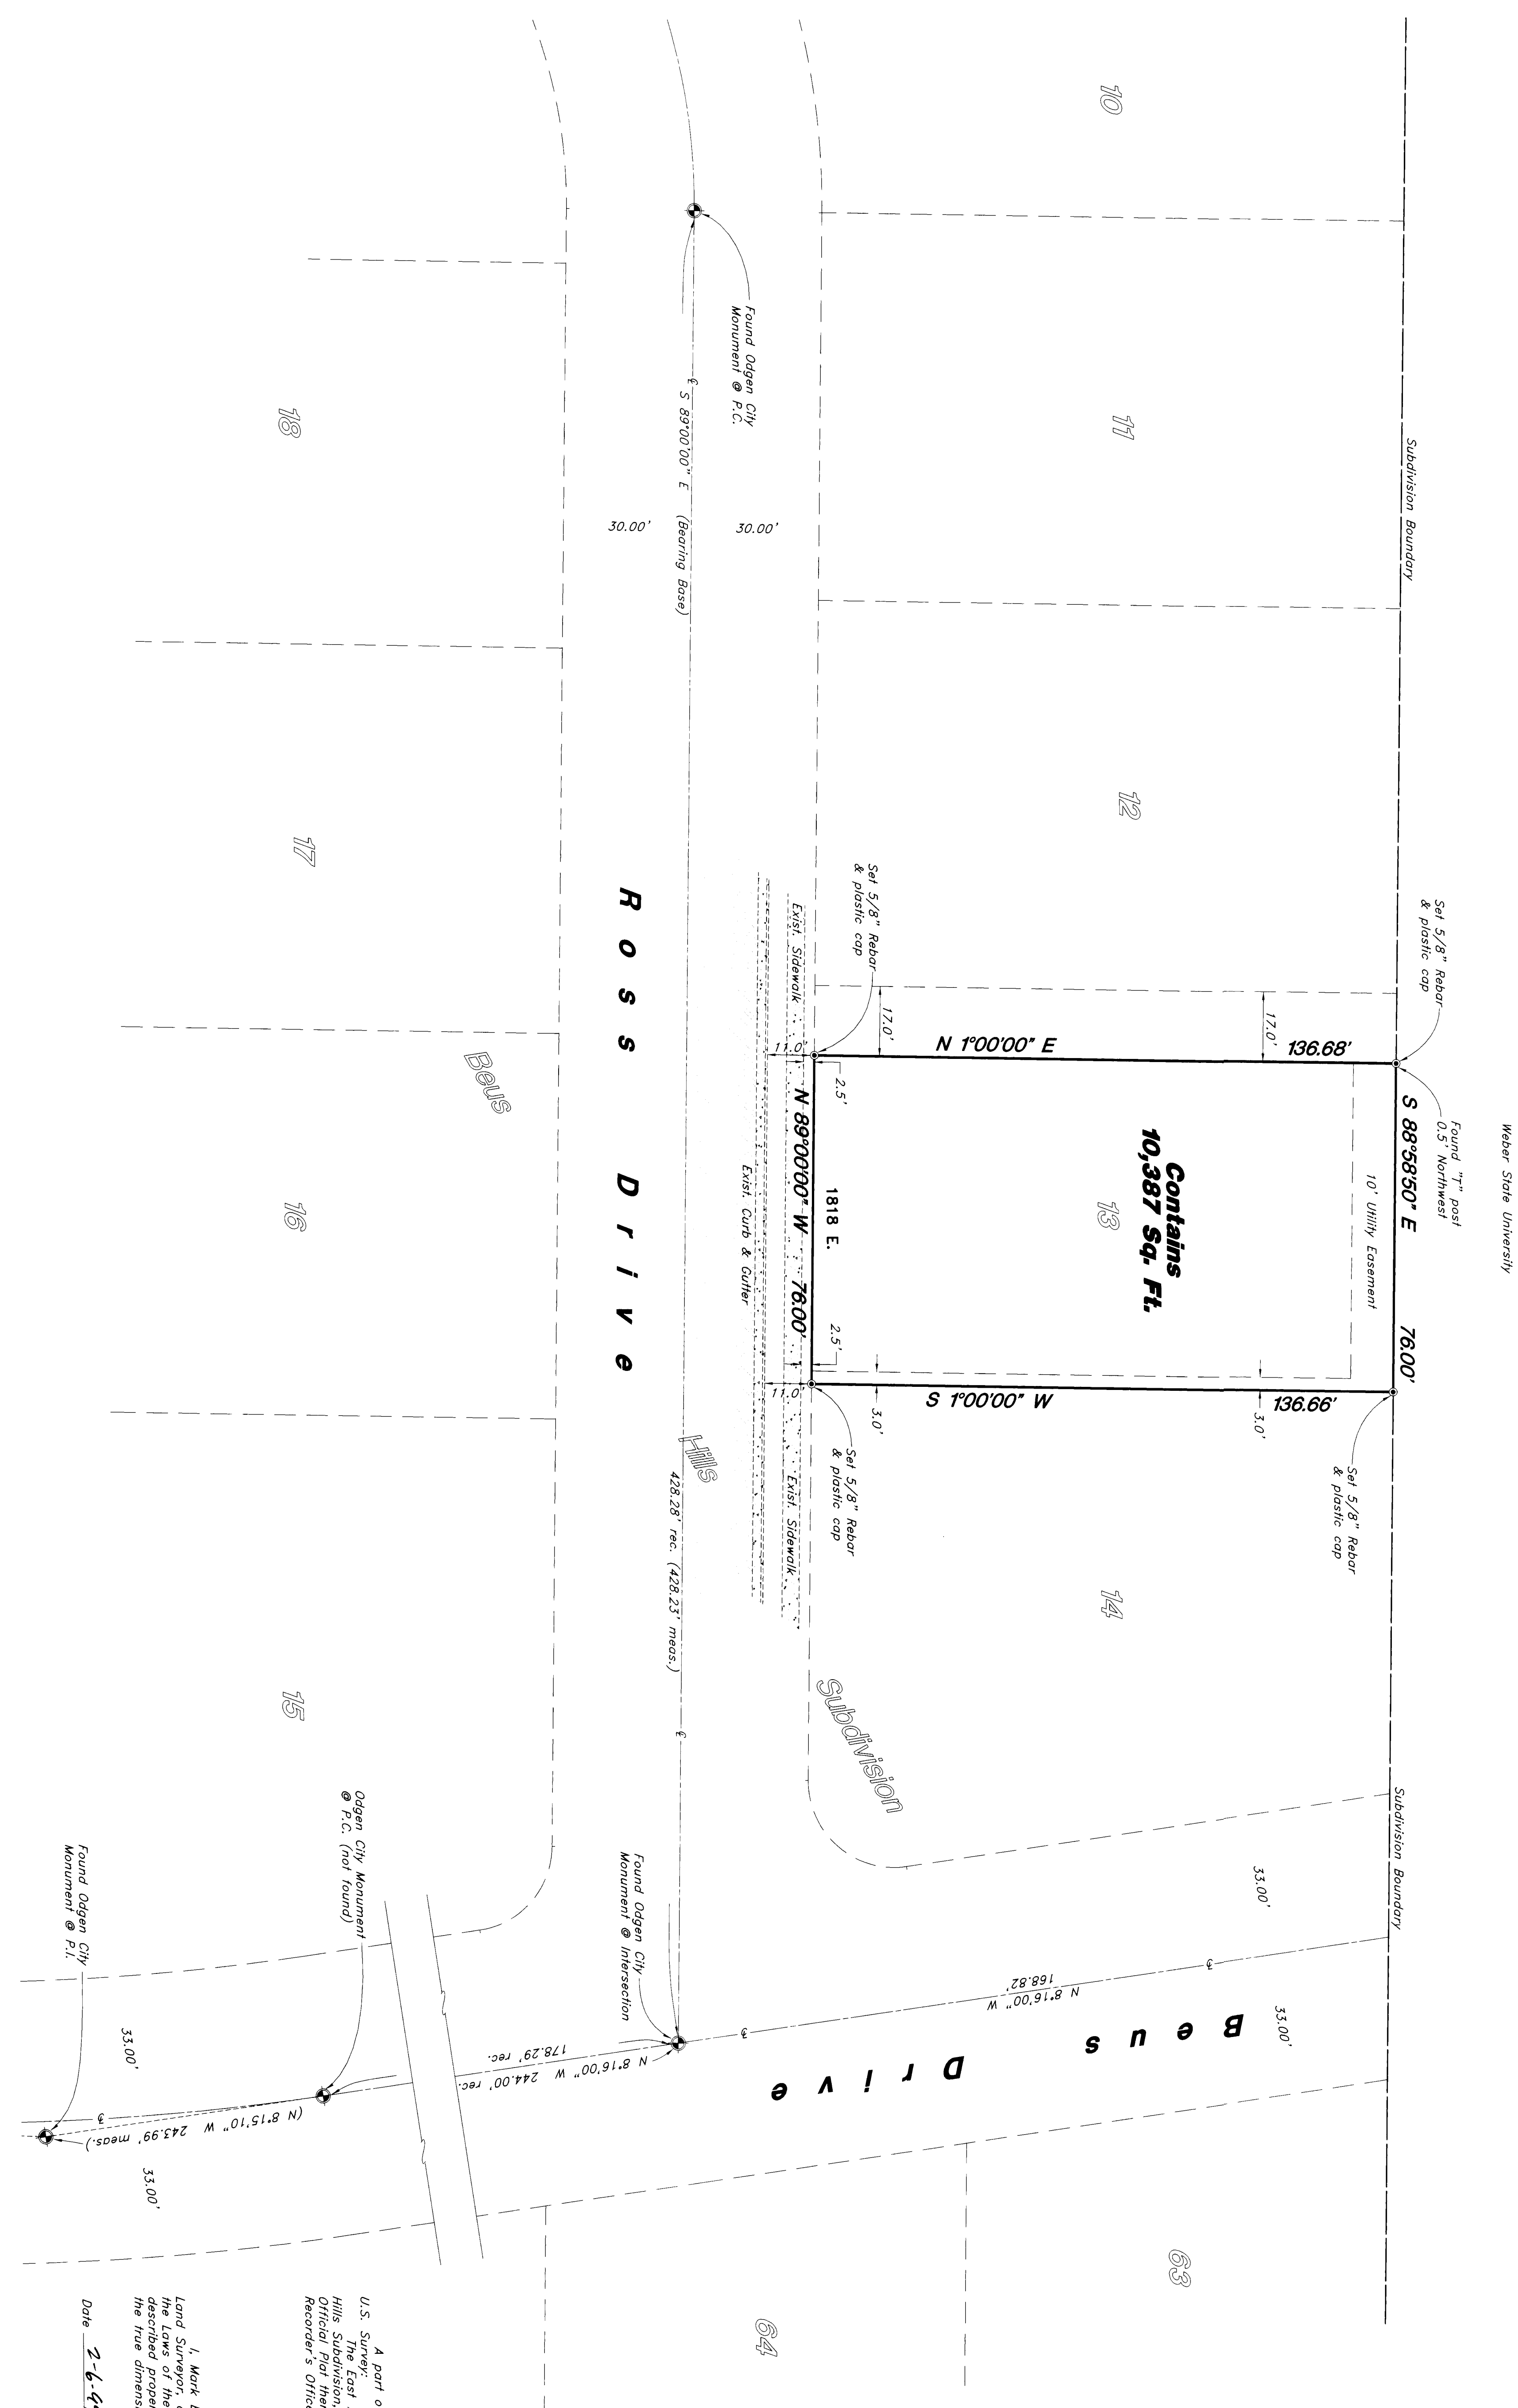


SCALE: 1" = 20'

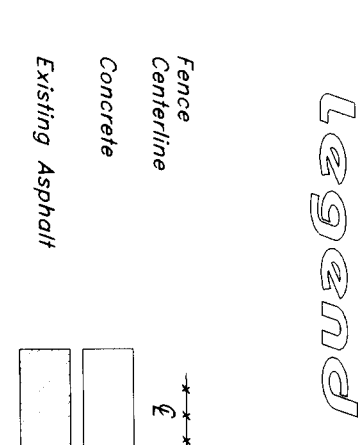

Boundary Description
Contains 10,387 Sq. Ft.

Certification
I, Mark E. Babbitt, do hereby certify that I am a Registered Land Surveyor and that I hold certificate No. 16644, as prescribed by the Laws of the State of Utah, and I have made a survey of the above described property, I further certify that the above plat correctly shows the true dimensions of the property surveyed.
Date: 2-6-99

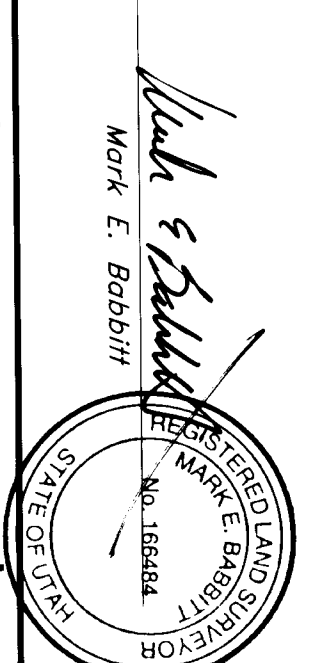

Property Survey
Judy Webber (Equity Title Agency)

SCALE: 1" = 20'	DATE: 30 Dec 1998	DRAWN BY: BA	REVISIONS: Date

RECEIVED
MAR 03 1999
WEBBER COUNTY SURVEYOR