


SURVEY OF NATIONAL FOREST BOUNDARY
 TOWNSHIP 5 & 6 NORTH RANGE 1 EAST SLM
 WEBER COUNTY, UTAH

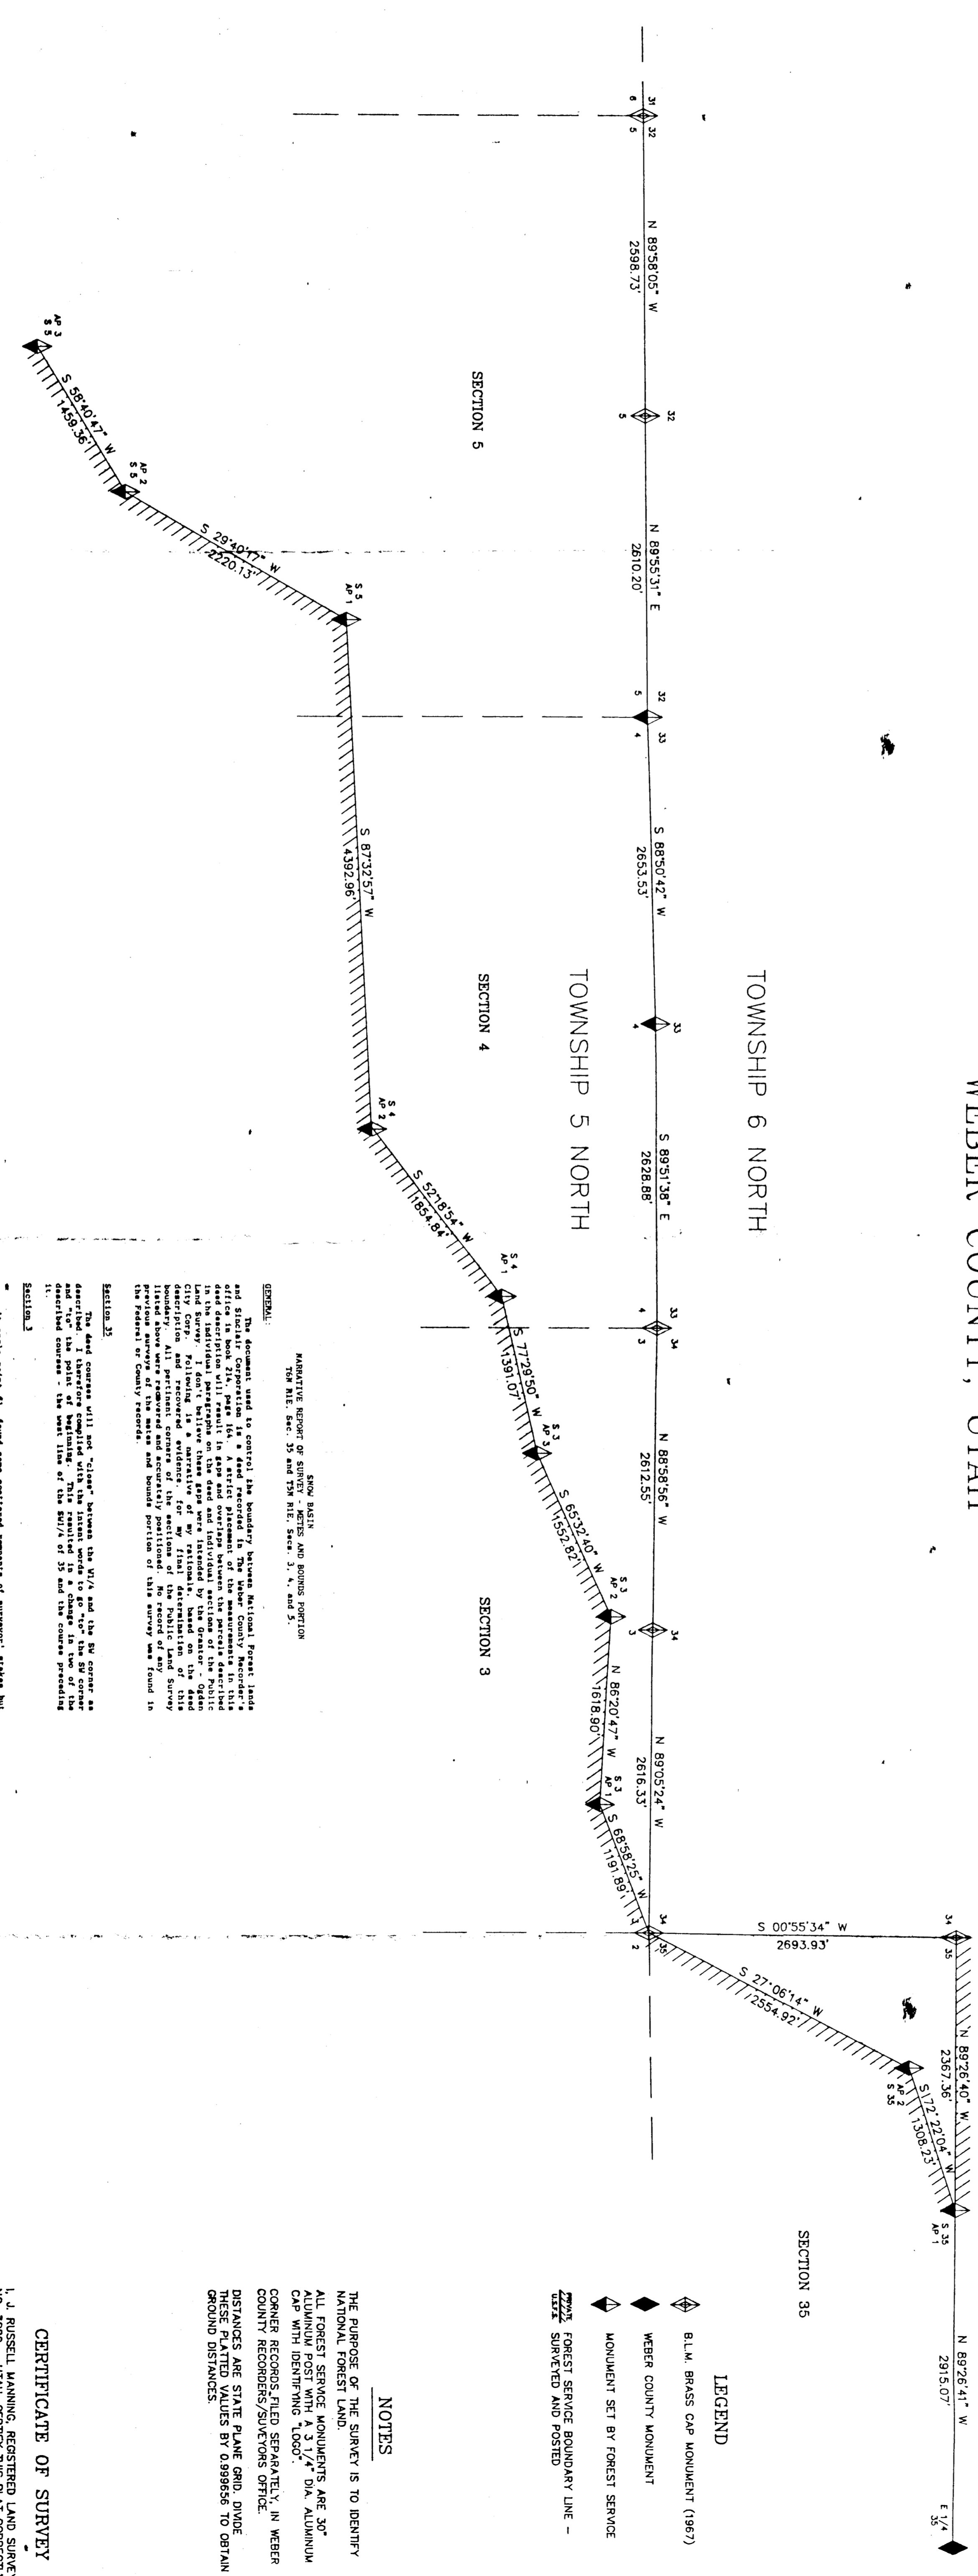




BASIS OF BEARING
 BEARINGS SHOWN ARE STATE PLANE GRID
 BEARINGS, UTM NORTH ZONE, NAD 83,
 ESTABLISHED BY GLOBAL POSITIONING SYSTEM

GRAPHIC SCALE
 1" = 700.0'

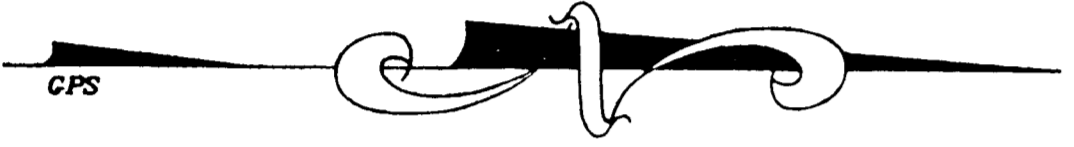

SECTION 35


- LEGEND
 - WEBER COUNTY MONUMENT
 - MONUMENT SET BY FOREST SERVICE
 - FOREST SERVICE BOUNDARY LINE - 2000 SURVEYED AND POSTED

NOTES


CERTIFICATE OF SURVEY


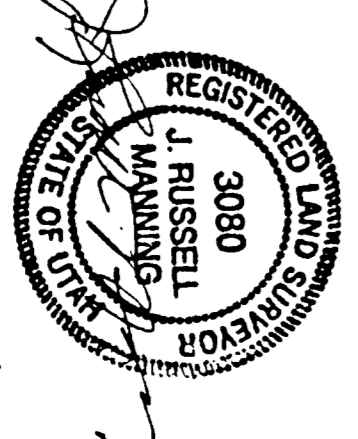

RECEIVED
 MAR 2 1999
 WEBER COUNTY Surveyor

FOREST SERVICE
 RECORD OF SURVEY
 NATIONAL FOREST BOUNDARY
 SNOW BASIN
 TOWNSHIP 5 & 6 NORTH RANGE 1 EAST
 SECTION 3, 4, 5 & 35
 DATE: MAR 2, 1999