


**RECORD OF SURVEY**

002180

**SURVEYOR'S CERTIFICATE**  

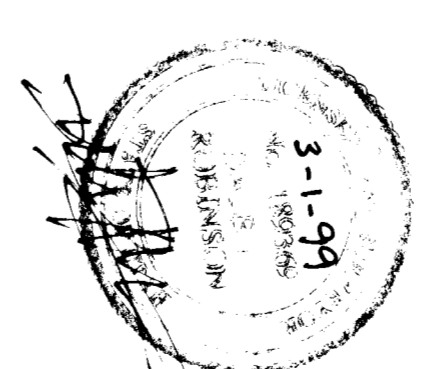

**SURVEYED DESCRIPTION**

A part of the Northeast Quarter of Section 18, Township 6 North, Range 1 West, Salt Lake Meridian.

Commencing at the monument located on the monument line of 12th Street being N 88°41'21" W, 3665.01', along the monument line to monument located at the intersection of 12th Street and 1200 West Street, thence S 88°41'21" W, 1172.29' more or less East and 306.26' more or less South of the Northwest corner of said section 18), thence N 80°26'17" W, 219.693', to a point, thence N 29°37'45" E, 57.701' to a point, thence through a central angle of 191°12'47" on a distance of 203.783', a chord bearing of S 60°19'40" E, 202.810' to a point, thence S 29°25'35" W, 154.769' to the Point of Beginning. Containing 3209.146 square feet or 0.74 acres more or less.

**NOTES**

BASIS OF BEARING: S 88°41'21" E 3665.01' ON CENTERLINE OF 12TH STREET AS MONUMENTED.  
1 - THE PURPOSE OF THIS SURVEY IS ESTABLISH A BOUNDARY AND LEGAL DESCRIPTION FOR THE SUBJECT PARCEL.

RECEIVED  
MAR 2 3 1999  
Weber County Surveyor

**REVISIONS**

NO.	DATE	BY	DESCRIPTION
1			
2			
3			
4			
5			
6			
7			

**SUNRISE ENGINEERING, INC.**  
CONSULTING ENGINEERS & LAND SURVEYORS  
12227 SOUTH BUSINESS PARK DRIVE, SUITE 220  
DRAAPER, UTAH 84020  
TEL (801) 583-0100  
FAX (801) 583-0990



**PROPERTY SURVEY AT DEFENCE DEPOT OGDEN, UTAH**  
SE QUARTER OF SECTION 18, TOWNSHIP 6 NORTH, RANGE 1 WEST, SALT LAKE MERIDIAN

**DATE**

9/23/04	DATE
2/6/99	DATE
3/1/99	DATE
1-90	DATE