

G:\DRAWINGS\SHARED\3505\01-MOND1\SURV.DWG Mon May 03 01:54:36 1999 H. GUNN

SURVEYOR'S CERTIFICATE
I, RONALD L. WILLIAMS, DEPOSE AND SAY THAT I AM A LICENSED PROFESSIONAL LAND SURVEYOR, HOLDING UTAH LICENSE NUMBER 159437 AND THAT I AM THE SURVEYOR OF THE PROPERTY DESCRIBED HEREON AND THAT THE PLAT AND SURVEY OF THE PROPERTY DESCRIBED HEREON PLAT CORRECTLY DEMONSTRATES THE BOUNDARIES OF THAT SURVEY.

SIGNED THIS 7th DAY OF MAY 1999.
159437
UTAH LICENSE NUMBER
RONALD L. WILLIAMS
LAND SURVEYOR
UTAH

BASE OF BEARINGS



NARRATIVE


SURVEYED DESCRIPTION


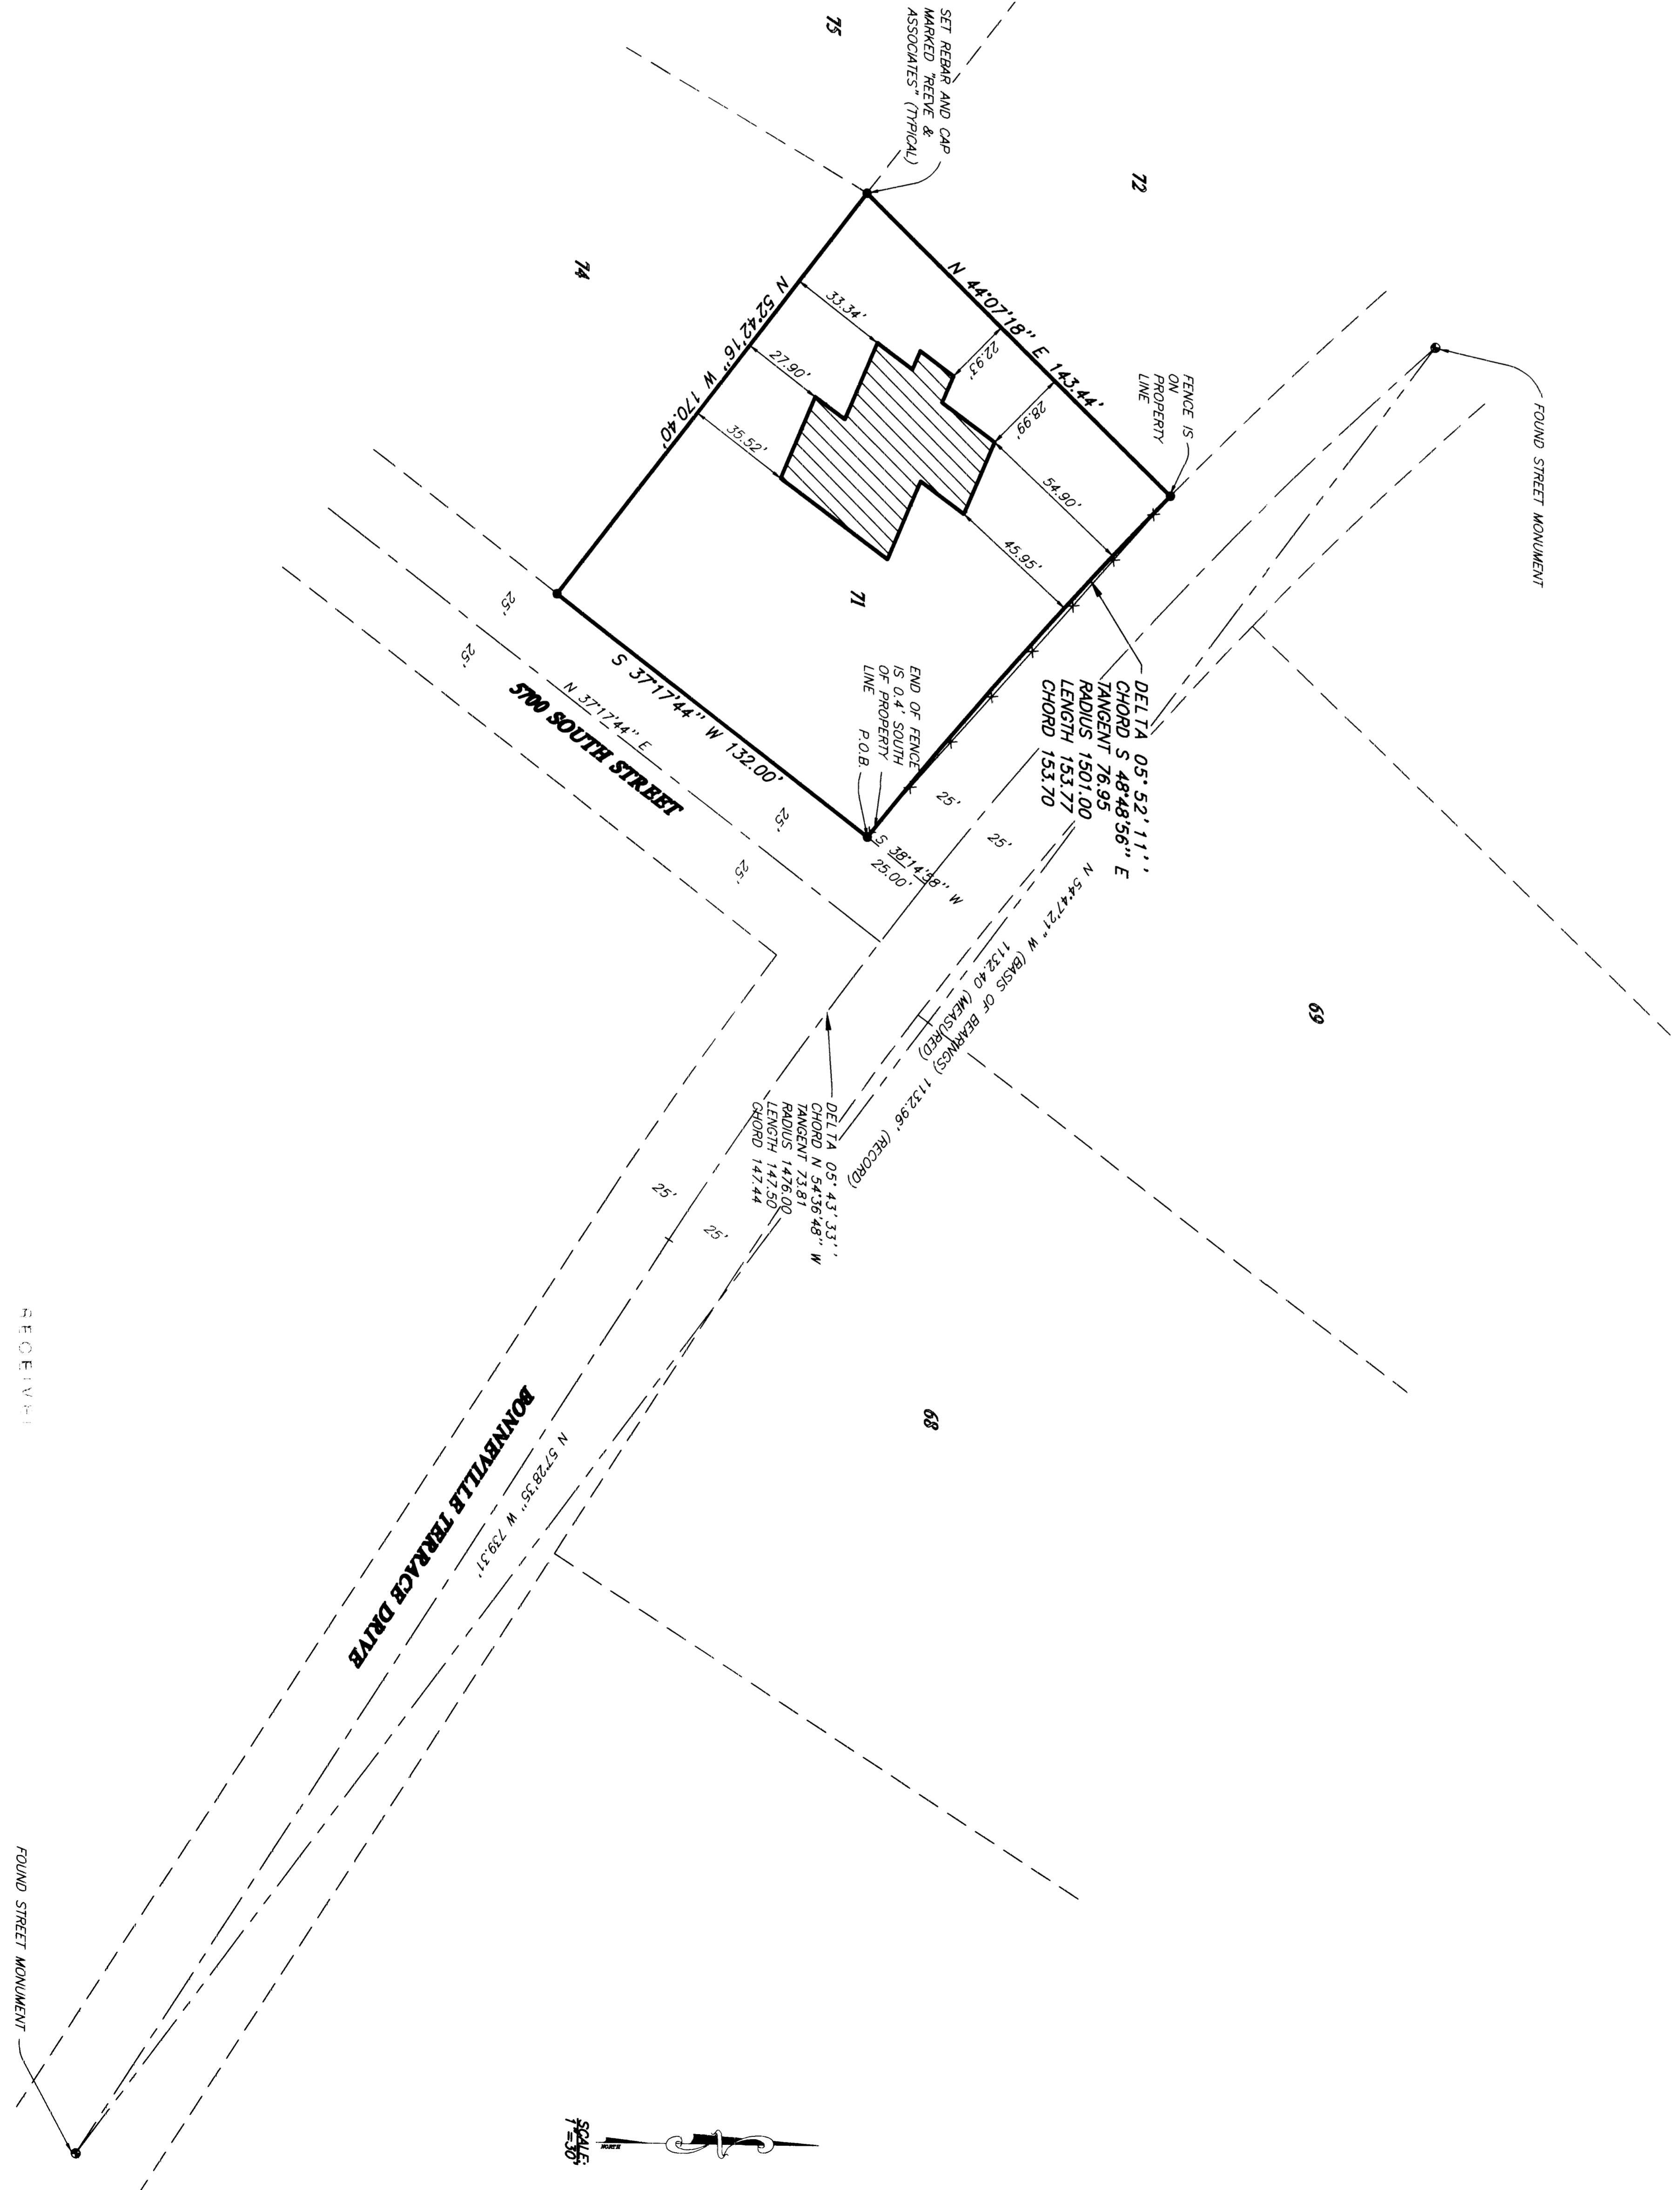

REVISIONS

1.	
2.	
3.	
4.	
5.	
6.	

PROJECT NO.: 388-21 SURVEYOR: R. WILLIAMS
DATE: 4/14/99 DRAWN: H. GUNN
SCALE: 1" = 30' CHECKED:

REEVE & ASSOCIATES, INC.
3070 QUINCY AVE. OGDEN, UTAH 84403-2888
(801) 463-0000 FAX (801) 463-2888
TOLL-FREE 1-888-463-5100

RECORD OF SURVEY

MONDI PROPERTY
APRIL 5, 1999

SHEET 1 OF 1 SHEETS