
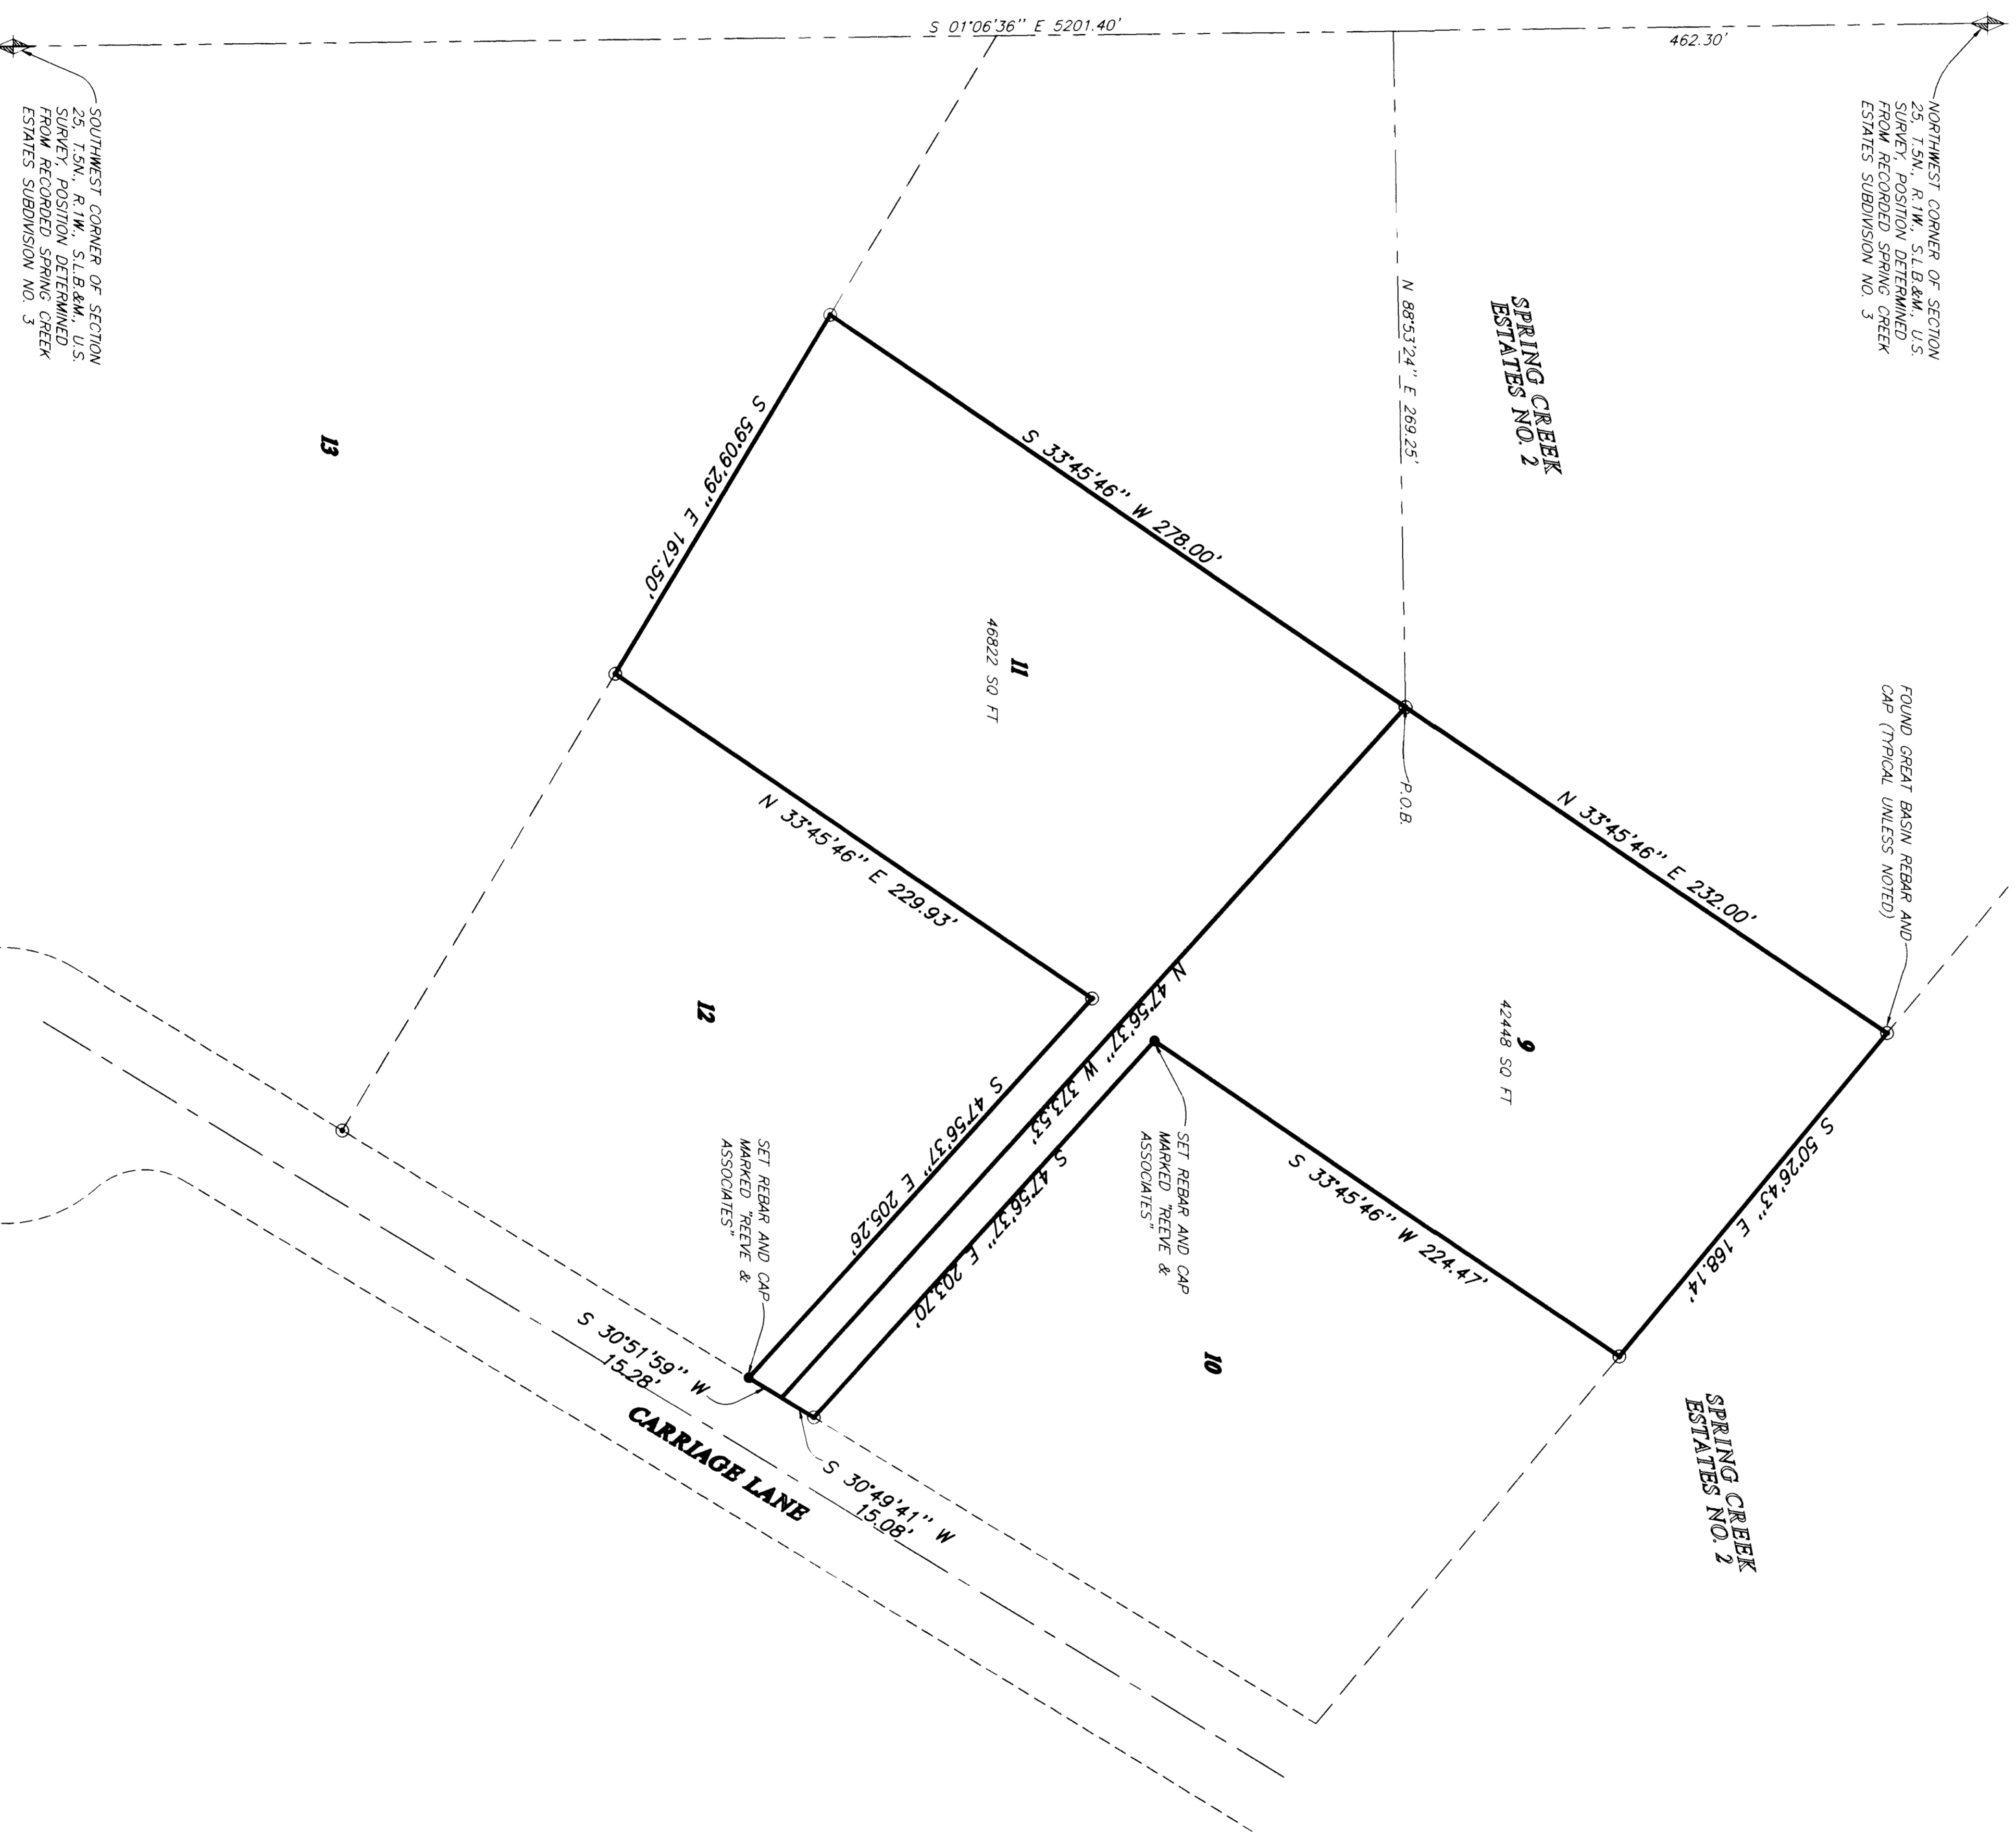


SURVEYOR'S CERTIFICATE
SIGNED THIS 3rd DAY OF MAY 1999
159437
UTAH LICENSE NUMBER
Randall J. Wilford
SURVEYOR

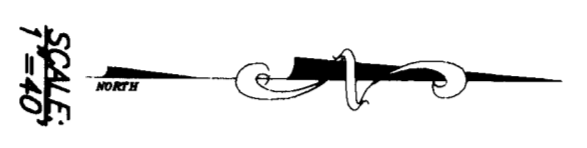




BASIS OF BEARINGS

NARRATIVE

SURVEYED DESCRIPTION
ALL OF LOTS 9 AND 11 SPRING CREEK ESTATES SUBDIVISION NO. 3, WEBER COUNTY, UTAH.

REVISIONS

1	
2	
3	
4	
5	
6	

PROJECT NO.: J118-211 SURVEYOR: A.M. WOOD

DATE: 4-2-99 DRAWN: H. GUNN

SCALE: 1"=40' CHECKED:

REEVE & ASSOCIATES, INC.
ENGINEERS PLANNERS & SURVEYORS

RECORD OF SURVEY

LOTS 9 AND 11 SPRING CREEK ESTATES NO. 3
ADDSN: 1599

SHEET	1
SHEETS	1

DATE: MAY 11, 1999
DRAWN BY: H. GUNN