


C:\a14\DN65\97-23.dwg Tue Mar 30 15:36:54 1999 MH

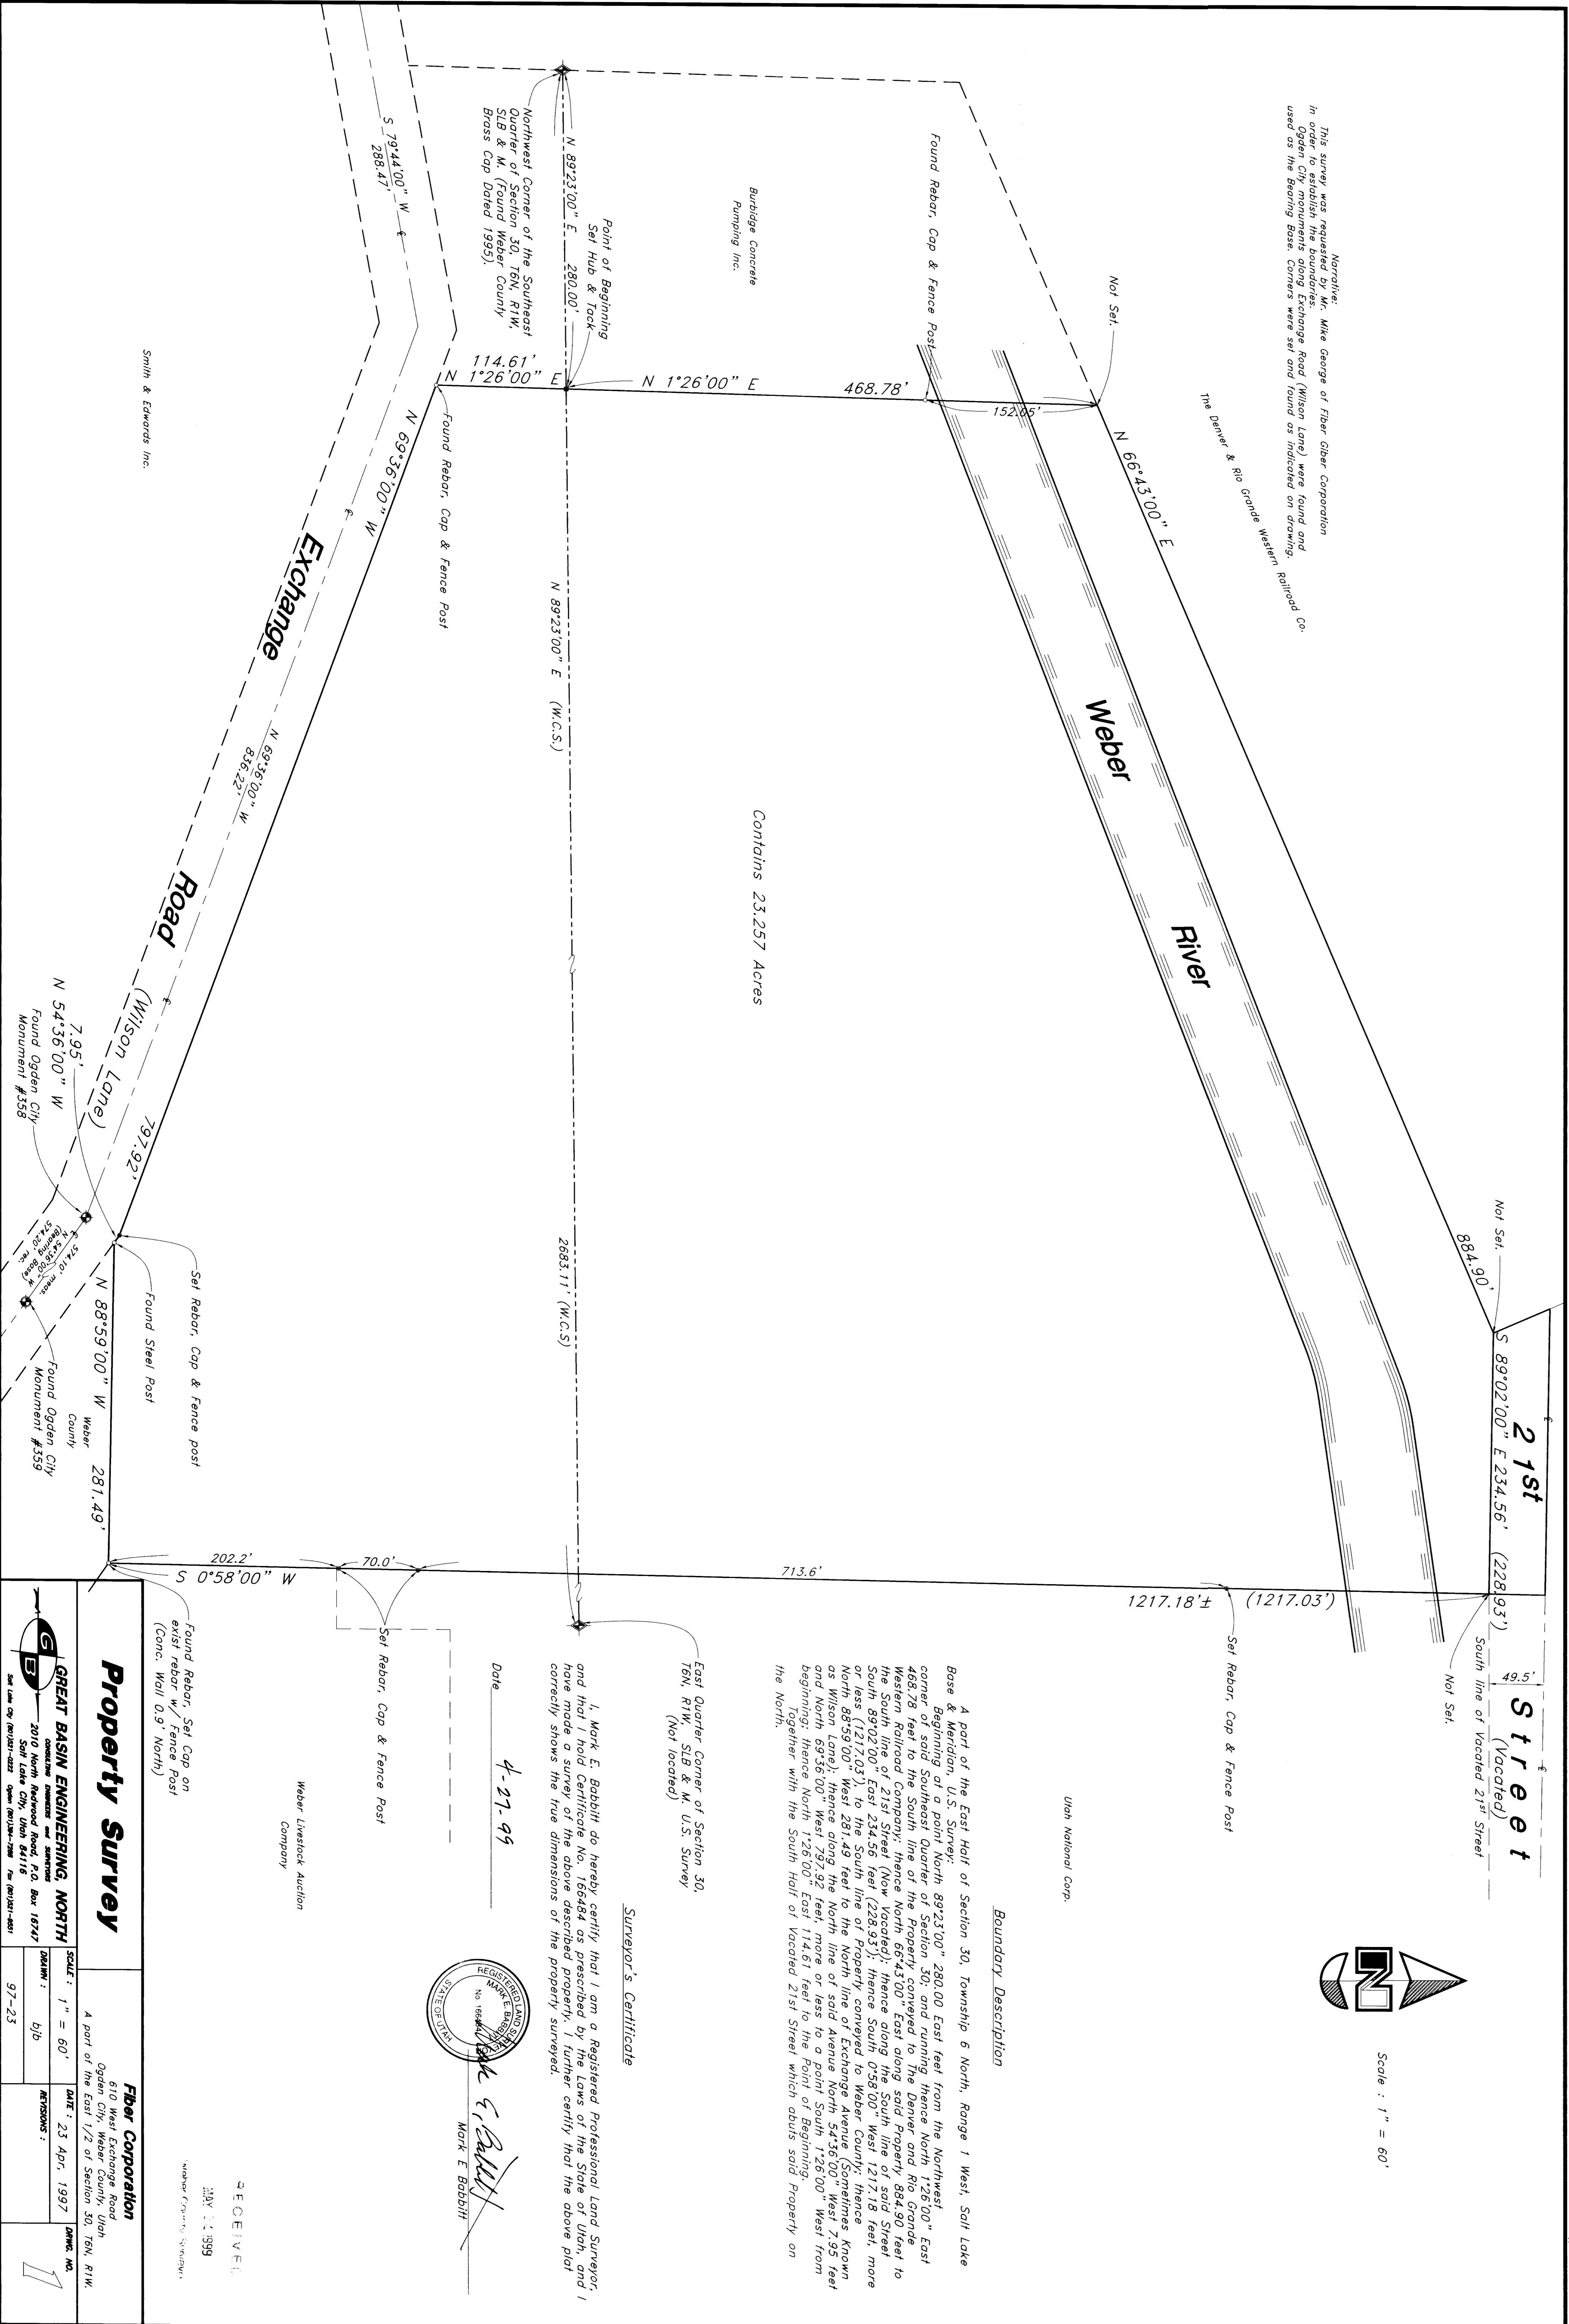


Contains 23,257 Acres


Boundary Description

A part of the East Half of Section 30, Township 6 North, Range 1 West, Salt Lake Base & Meridian, U.S. Survey; Beginning at a point North 89°23'00" East 280.00 feet from the Northwest corner of said Southeast Quarter of Section 30; 

Surveyor's Certificate

I, Mark E. Bobbitt do hereby certify that I am a Registered Professional Land Surveyor, and that I hold Certificate No. 166484 as prescribed by the Laws of the State of Utah, and I have made a survey of the above described property, I further certify that the above plat correctly shows the true dimensions of the property surveyed.

Date 4-27-99

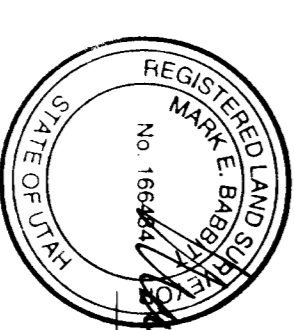

Mark E. Bobbitt


RECEIVED

Property Survey

GREAT BASIN ENGINEERING NORTH

Fiber Corporation
610 West Exchange Road
Ogden City, Weber County, Utah
A part of the East 1/2 of Section 30, 16N, 1W

SCALE: 1" = 60'
DATE: 23 Apr, 1997
DRAWN BY: bjb
REVISIONS:

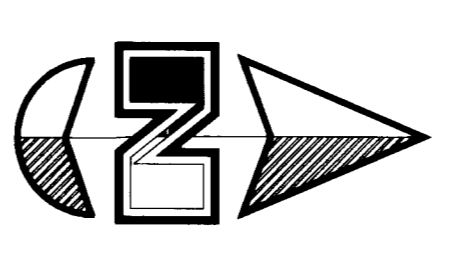

Scale: 1" = 60'

002218

002218