

© DRAWINGS SHARED 13493101-MEEKS\BNRYR.DWG Mon May 03 01:51:02 1999 H. GUNN

REVISIONS

1		4
2		5
3		6

PROJECT NO. 100-101 SURVEYOR AMALZADEH  
DATE 3-13-99 DRAWN K. DEAN  
SCALE 1"=40' CHECKED

**REEVE & ASSOCIATES, INC.**  
ENGINEERS PLANNERS & SURVEYORS  
3670 QUINCY AVE. SUITE 101  
(801) 827-3100 FAX (801) 821-2868  
TOLL-FREE 1-888-494-3100

**RECORD OF SURVEY**

**WEEKS PROPERTY**  
3670 QUINCY AVE. SUITE 101  

SHEET 1 OF 1 SHEETS

**CURVE TABLE**

NUMBER	DETA	CHORD	TANGENT	RADIUS	LENGTH	CHORD
CT	5420.547"	11733.558"	39.21	128.00	78.10	74.99

**CURVE TABLE**



**DEED DESCRIPTION**

PART OF THE NORTHWEST QUARTER OF SECTION 8, T6N., R.1W., S.L.B.M., U.S. SURVEY, DESCRIBED AS FOLLOWS:  


**SURVEYED DESCRIPTION**




**NARRATIVE**

THE PURPOSE OF THIS SURVEY IS TO DEFINE THE BOUNDARY OF THE STAN WEEKS PROPERTY. THE NORTHERLY LINES WERE TIED BY THE SOUTHERLY RIGHT-OF-WAY LINE OF 1100 NORTH STREET, 1100 NORTH STREET, 100 NORTH STREET, AND 250 WEST STREET. THE WESTERN MOST LINE WAS TIED BY THE EAST RIGHT-OF-WAY LINE OF U.S. HIGHWAY 30, 89, & 91. ALL OTHER LINES WERE SET BY DEED AND HI WELL WITH EXISTING FENCES.

**BASIS OF BEARINGS**

THE BASIS OF BEARINGS FOR THIS PLAT IS THE TWO FOUND CITY STREET MONUMENTS IN 1100 NORTH STREET, SHOWN HEREON AS: 58919.51'E

SIGNED THIS 3<sup>rd</sup> DAY OF MAY 1999  
199437  
UPLI LICENSE NUMBER  
[Signature]  
[Stamp]

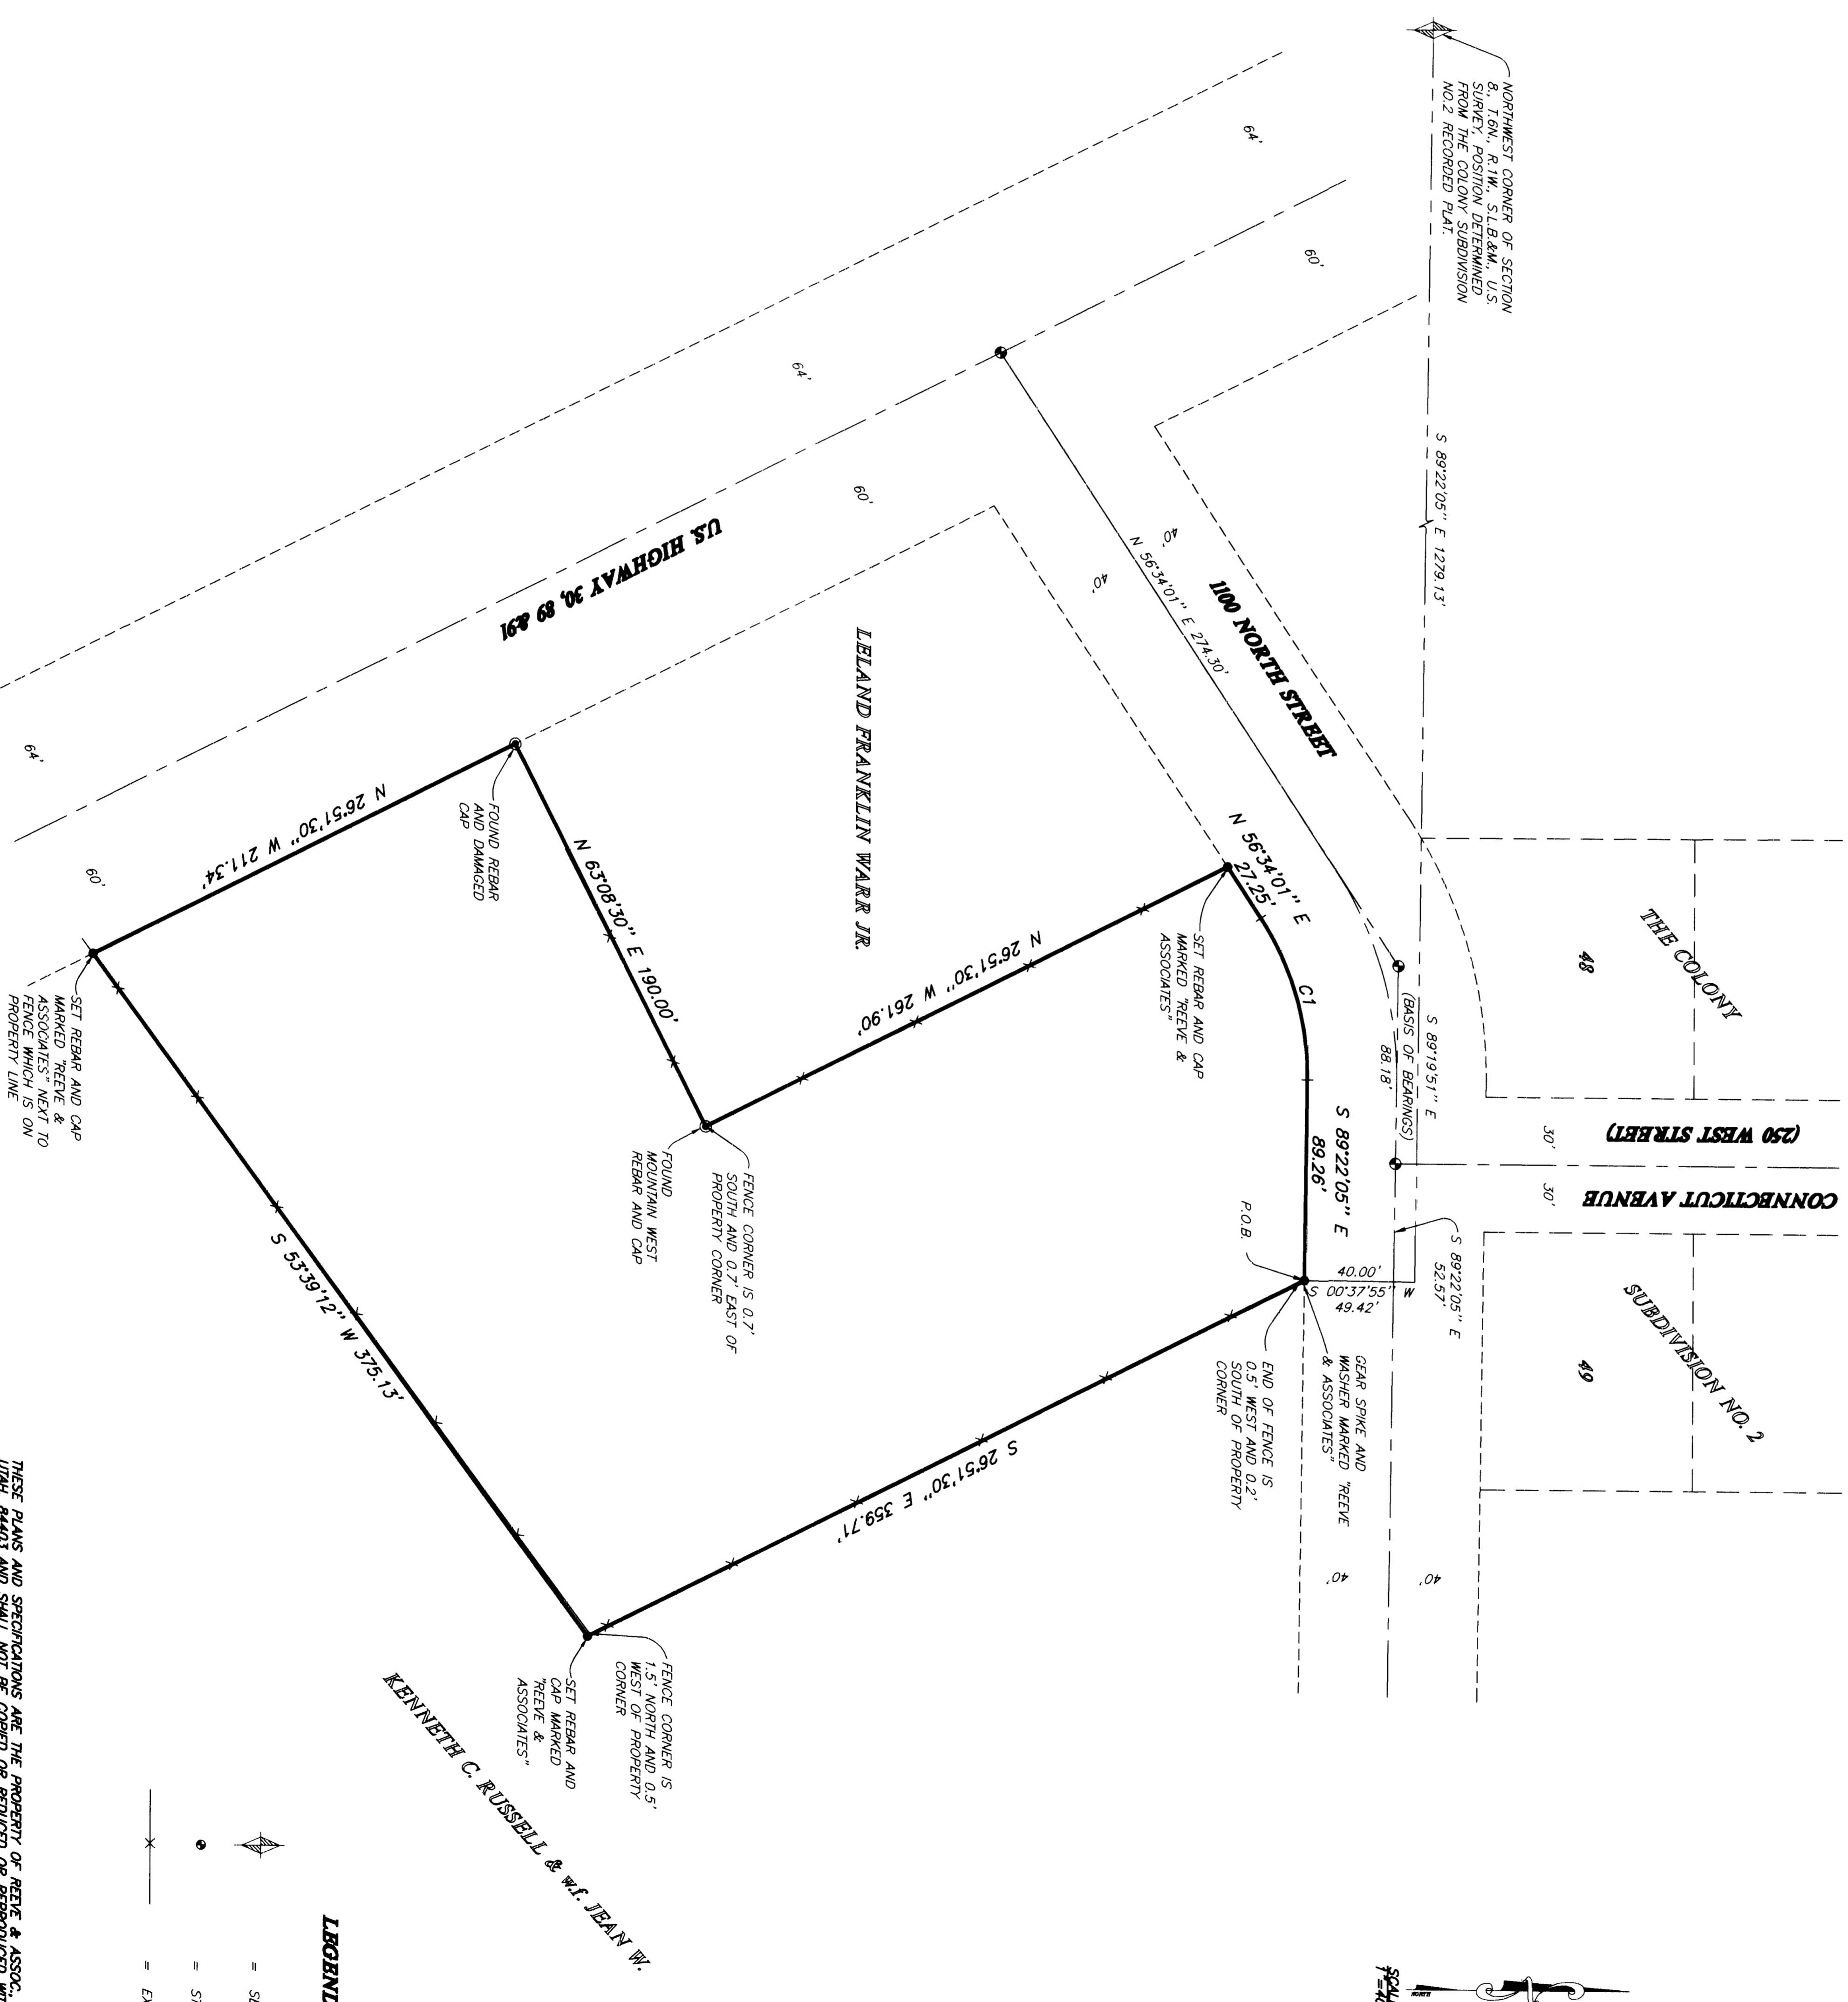

THESE PLANS AND SPECIFICATIONS ARE THE PROPERTY OF REEVE & ASSO., INC., 3670 QUINCY AVE., OGDEN, UTAH, 84403 AND SHALL NOT BE COPIED OR REDUCED OR REPRODUCED WITHOUT THEIR WRITTEN PERMISSION.



RECEIVED  
MAY 14 1999  
[Stamp]