


DRAWING NUMBER
000222

DRAWING NUMBER
000222

DRAWING NUMBER
000222

DRAWING NUMBER
000222

WEBER ENGINEERING CO. 11181

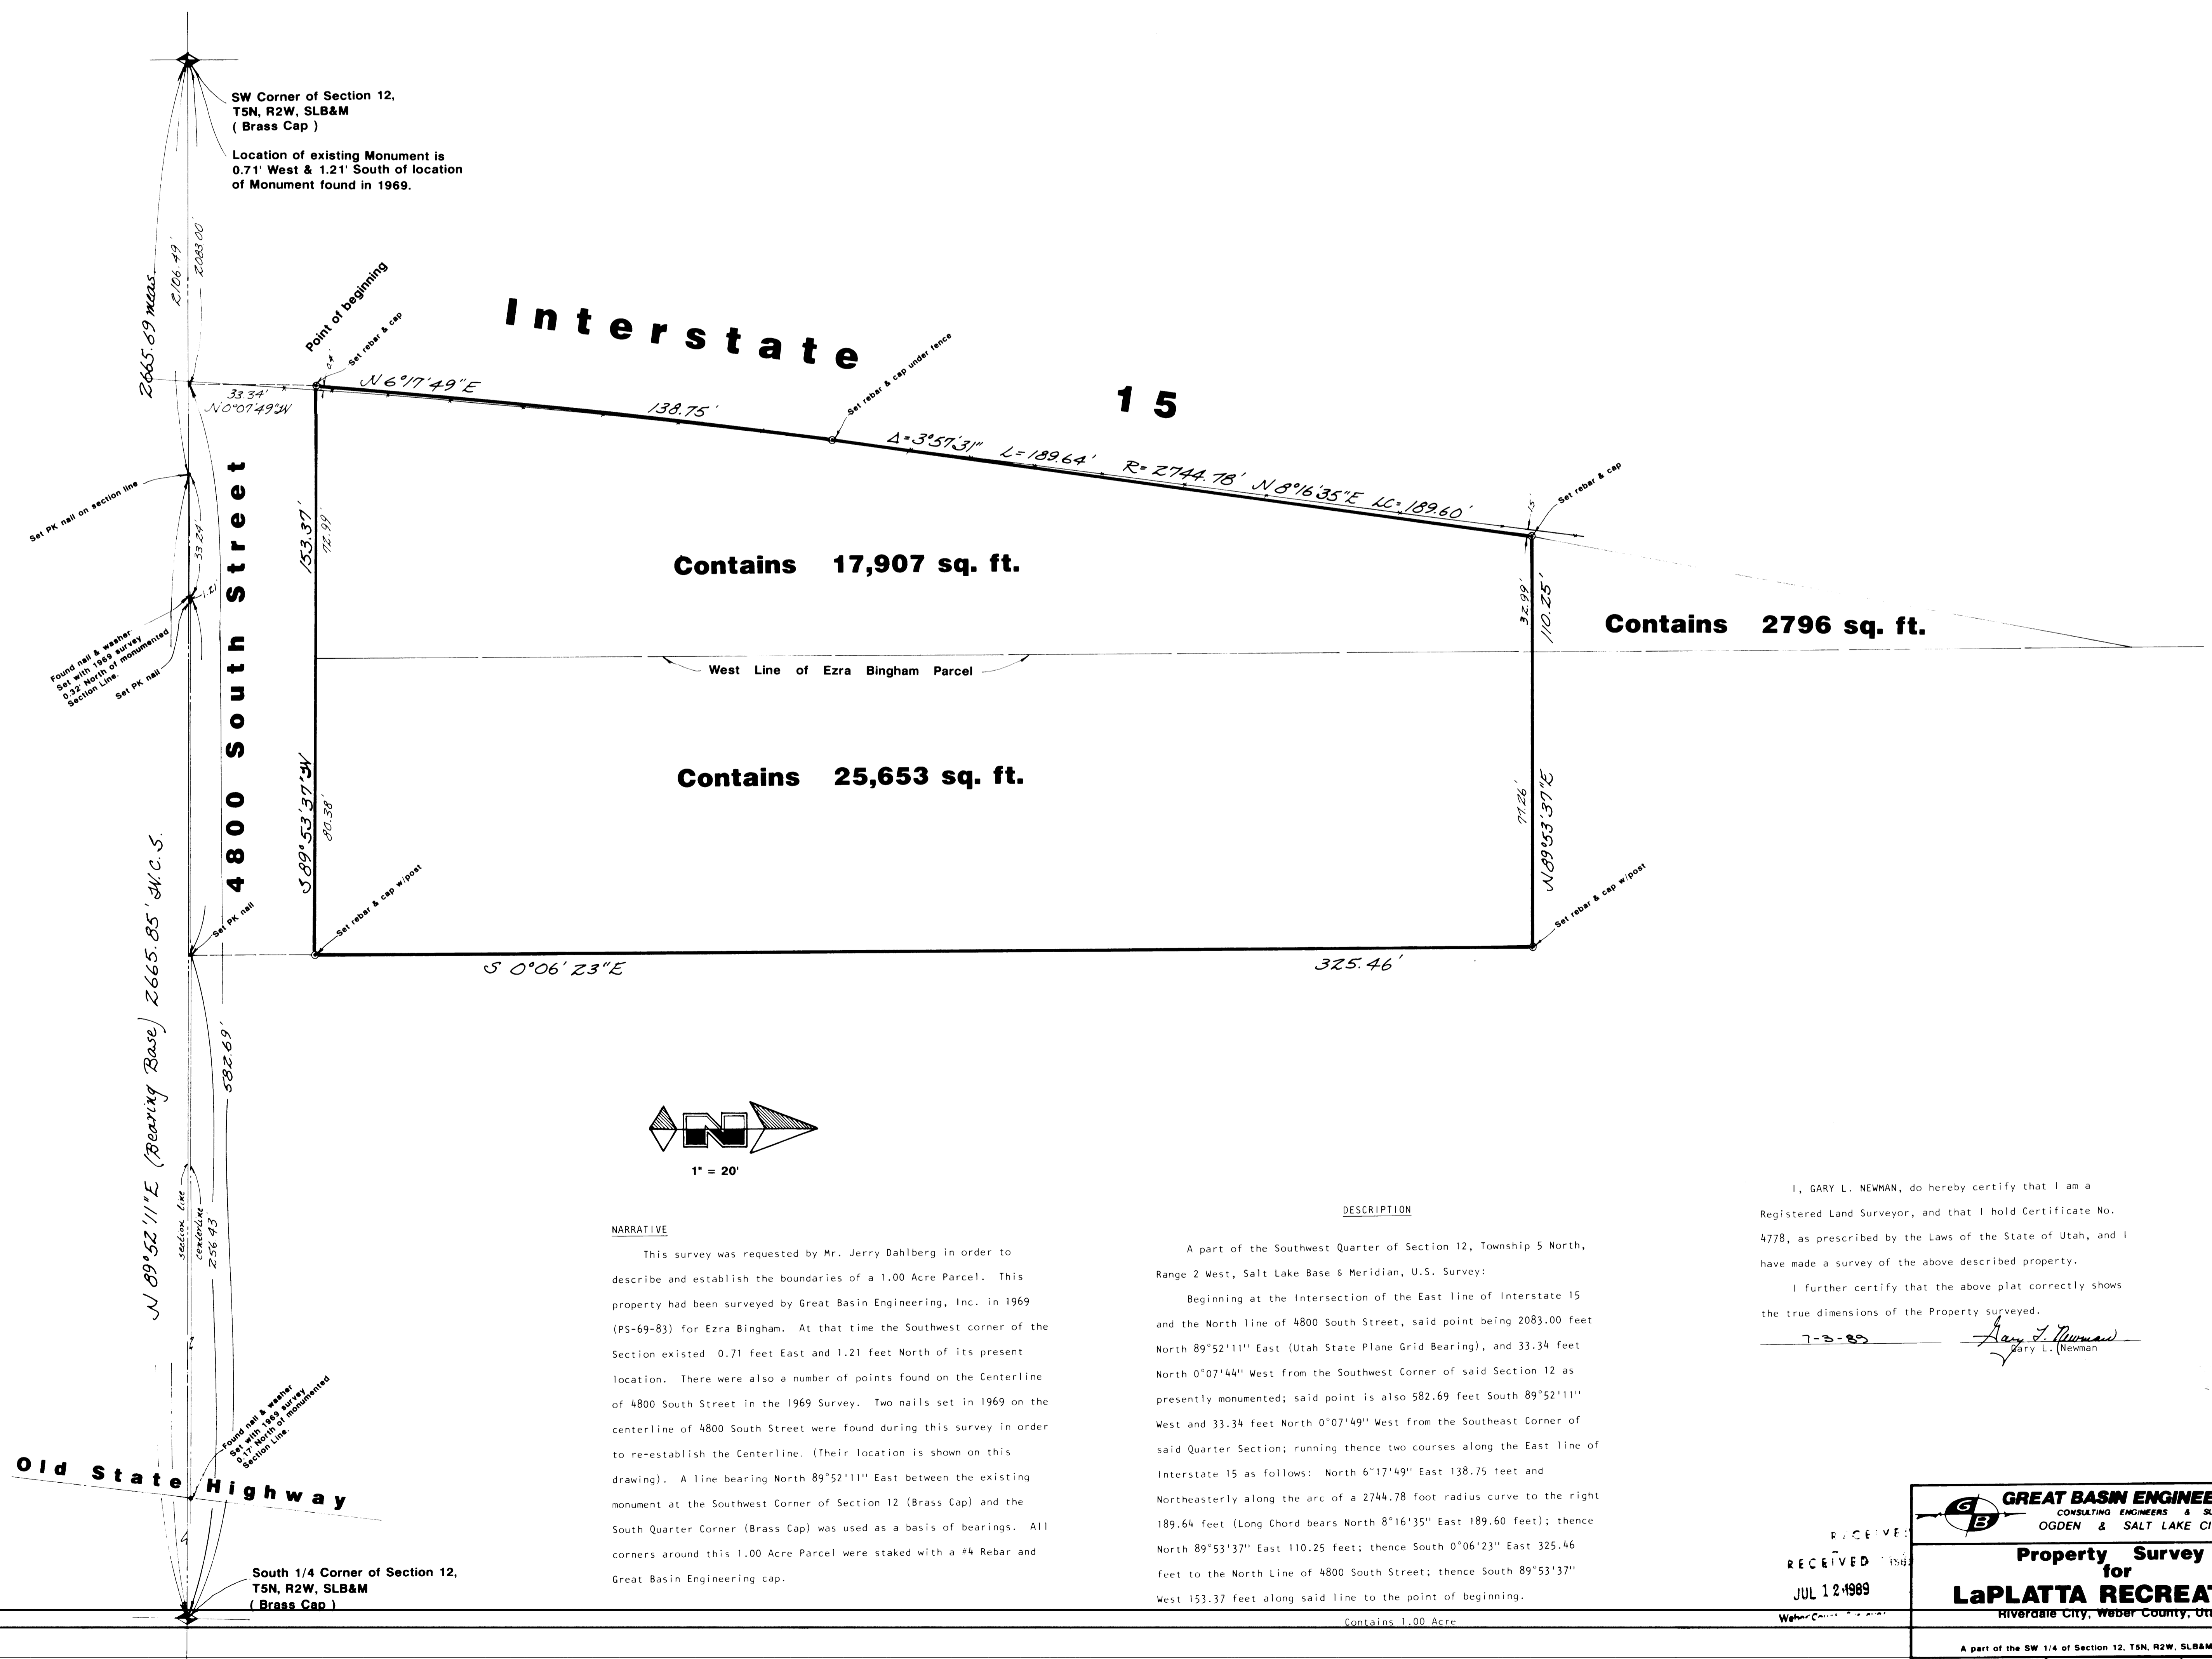

I, GARY L. NEWMAN, do hereby certify that I am a Registered Land Surveyor, and that I hold Certificate No. 4778, as prescribed by the Laws of the State of Utah, and I have made a survey of the above described property.

I further certify that the above plat correctly shows the true dimensions of the Property surveyed.

7-3-89 *Gary L. Newman*
Gary L. Newman

GREAT BASIN ENGINEERING, INC.
CONSULTING ENGINEERS & SURVEYORS
OGDEN & SALT LAKE CITY, UTAH

RECEIVED
JUL 12 1989

Property Survey for LaPLATTA RECREATION
Riverdale City, Weber County, Utah

A part of the SW 1/4 of Section 12, T5N, R2W, SLB&M U.S. Survey

NAME	DATE	SCALE	APPROVED	DATE
CAO				