


6:\DRAWING\SHARE\13355\01-CORR1\BNDRY.DWG Sun May 02 23:38:30 1999 H. GUNN

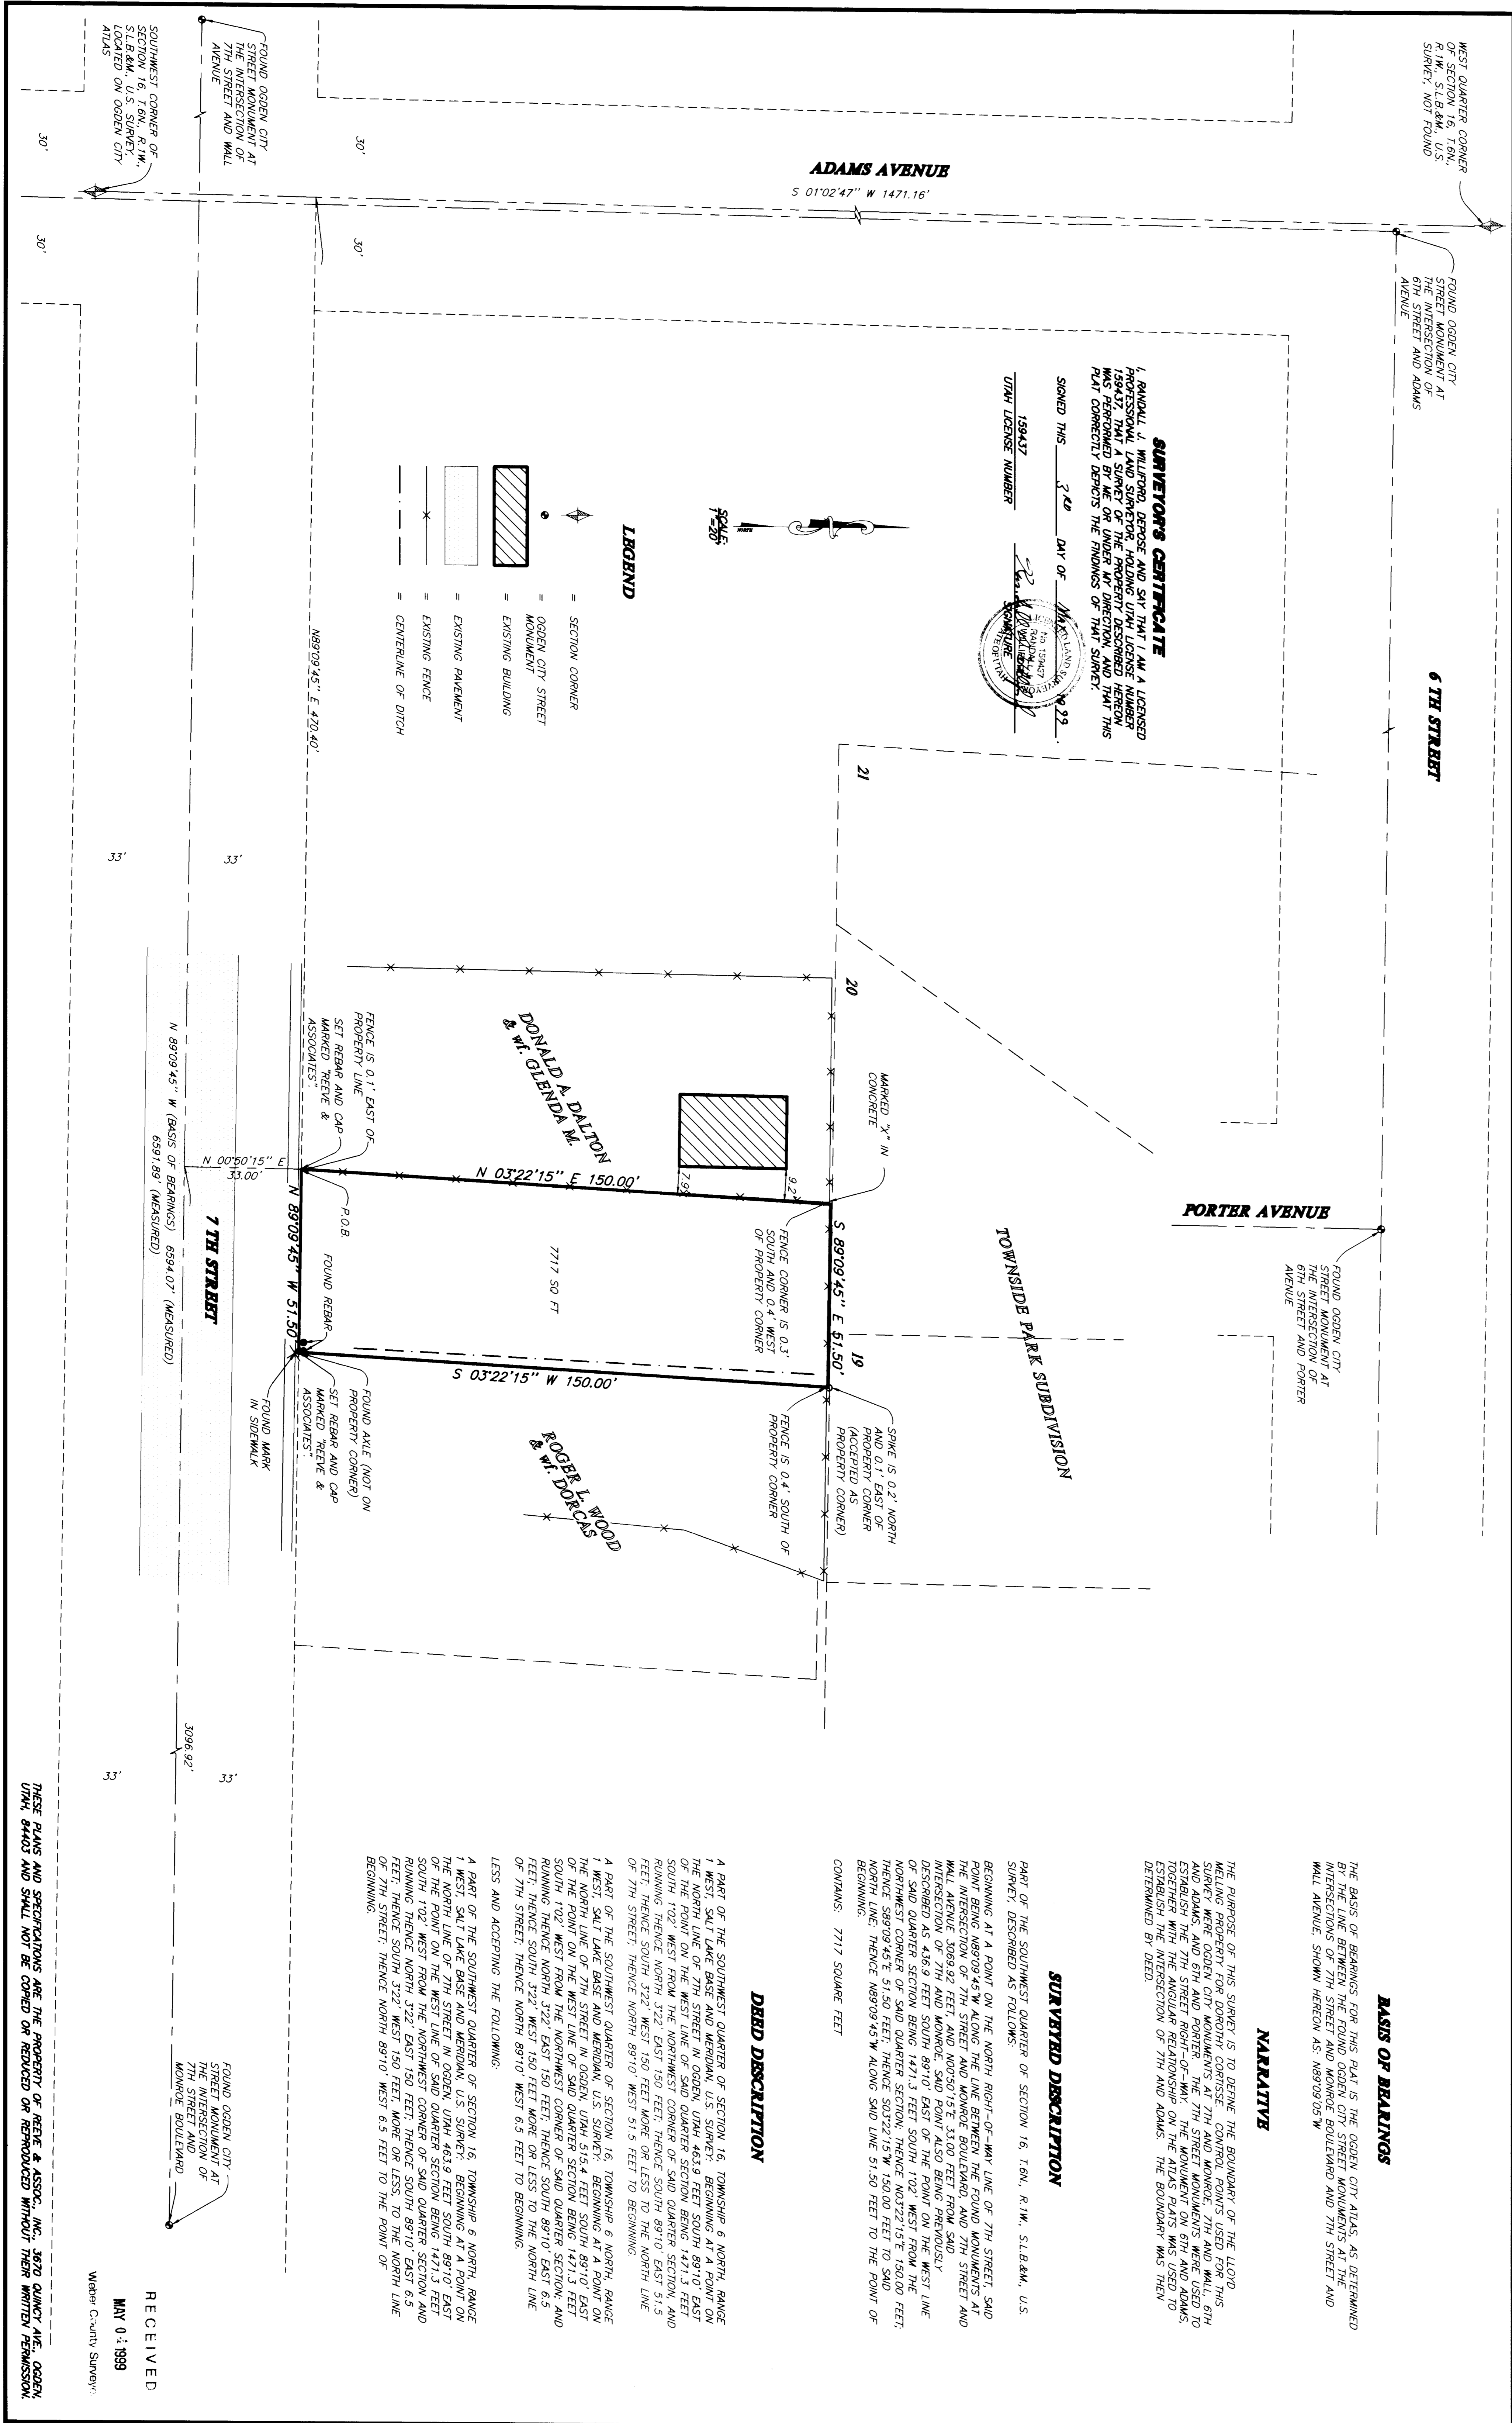


FOUND OGDEN CITY STREET MONUMENT AT THE INTERSECTION OF 6TH STREET AND ADAMS AVENUE.

FOUND OGDEN CITY STREET MONUMENT AT THE INTERSECTION OF 6TH STREET AND PORTER AVENUE.

FOUND OGDEN CITY STREET MONUMENT AT THE INTERSECTION OF 7TH STREET AND WALL AVENUE.

FOUND OGDEN CITY STREET MONUMENT AT THE INTERSECTION OF 7TH STREET AND MONROE BOULEVARD.

FOUND OGDEN CITY STREET MONUMENT AT THE INTERSECTION OF 7TH STREET AND MONROE BOULEVARD.

SURVEYOR'S CERTIFICATE
SIGNED THIS 3RD DAY OF MAY 1999.
1584437
UTAH LICENSE NUMBER

LEGEND

- SECTION CORNER
- OGDEN CITY STREET MONUMENT
- EXISTING BUILDING
- EXISTING FENCE
- CENTRALINE OF DITCH

BAIS OF BEARINGS

THE BASIS OF BEARINGS FOR THIS PLAT IS THE OGDEN CITY ATLAS, AS DETERMINED BY THE BEARINGS OF THE INTERSECTIONS OF 7TH STREET AND MONROE BOULEVARD AND 7TH STREET AND WALL AVENUE, SHOWN HEREON AS 189709.05° W.

NARRATIVE

THE MONUMENT ON 6TH AND ADAMS, TOGETHER WITH THE ANGULAR RELATIONSHIP ON THE ATLAS PLATS WAS USED TO ESTABLISH THE INTERSECTION OF 7TH AND ADAMS. THE BOUNDARY WAS THEN DETERMINED BY BEER.

SURVEYED DESCRIPTION

BEGINNING AT A POINT ON THE NORTH RIGHT-OF-WAY LINE OF 7TH STREET, SAID POINT BEING 189709.45° W ALONG THE LINE BETWEEN THE FOUND MONUMENTS AT THE INTERSECTION OF 7TH STREET AND MONROE BOULEVARD, AND 7TH STREET AND WALL AVENUE, 306.

DEED DESCRIPTION



RECEIVED
MAY 04 1999
Welder County Surveyor

REVISIONS

1					
2					
3					
4					
5					
6					

DATE: 1-2-99 DRAWING: N. GUNN
SCALE: 1"=50' CHECKED: N. GUNN

REEVE & ASSOCIATES, INC.
DESIGNERS, PLANNERS & SURVEYORS

RECORD OF SURVEY

MELING PROPERTY

SHEET 1 OF 1 SHEETS

002224

002224