

G:\DRAWINGS\SHARED\3114101-PEBBLE\LOT39ROS.DWG Sun May 02 23:40:47 1999 H. GUNN

REVISIONS

1.	
2.	
3.	
4.	
5.	


PROJECT NO. 3114-01 SURVEYOR R. MILLER
DATE: 4-2-99 DRAWN: A. DODD
SCALE: 1"=40' CHECKED:

REEVE & ASSOCIATES, INC.
ENGINEERING AND SURVEYING

RECORD OF SURVEY

LOT 39, PEBBLE BEACH PHASE 2
PART OF THE SOUTHWEST QUARTER OF SECTION 20, T7N, R11W, SLB& M,

SHEET 1 OF 1 SHEETS

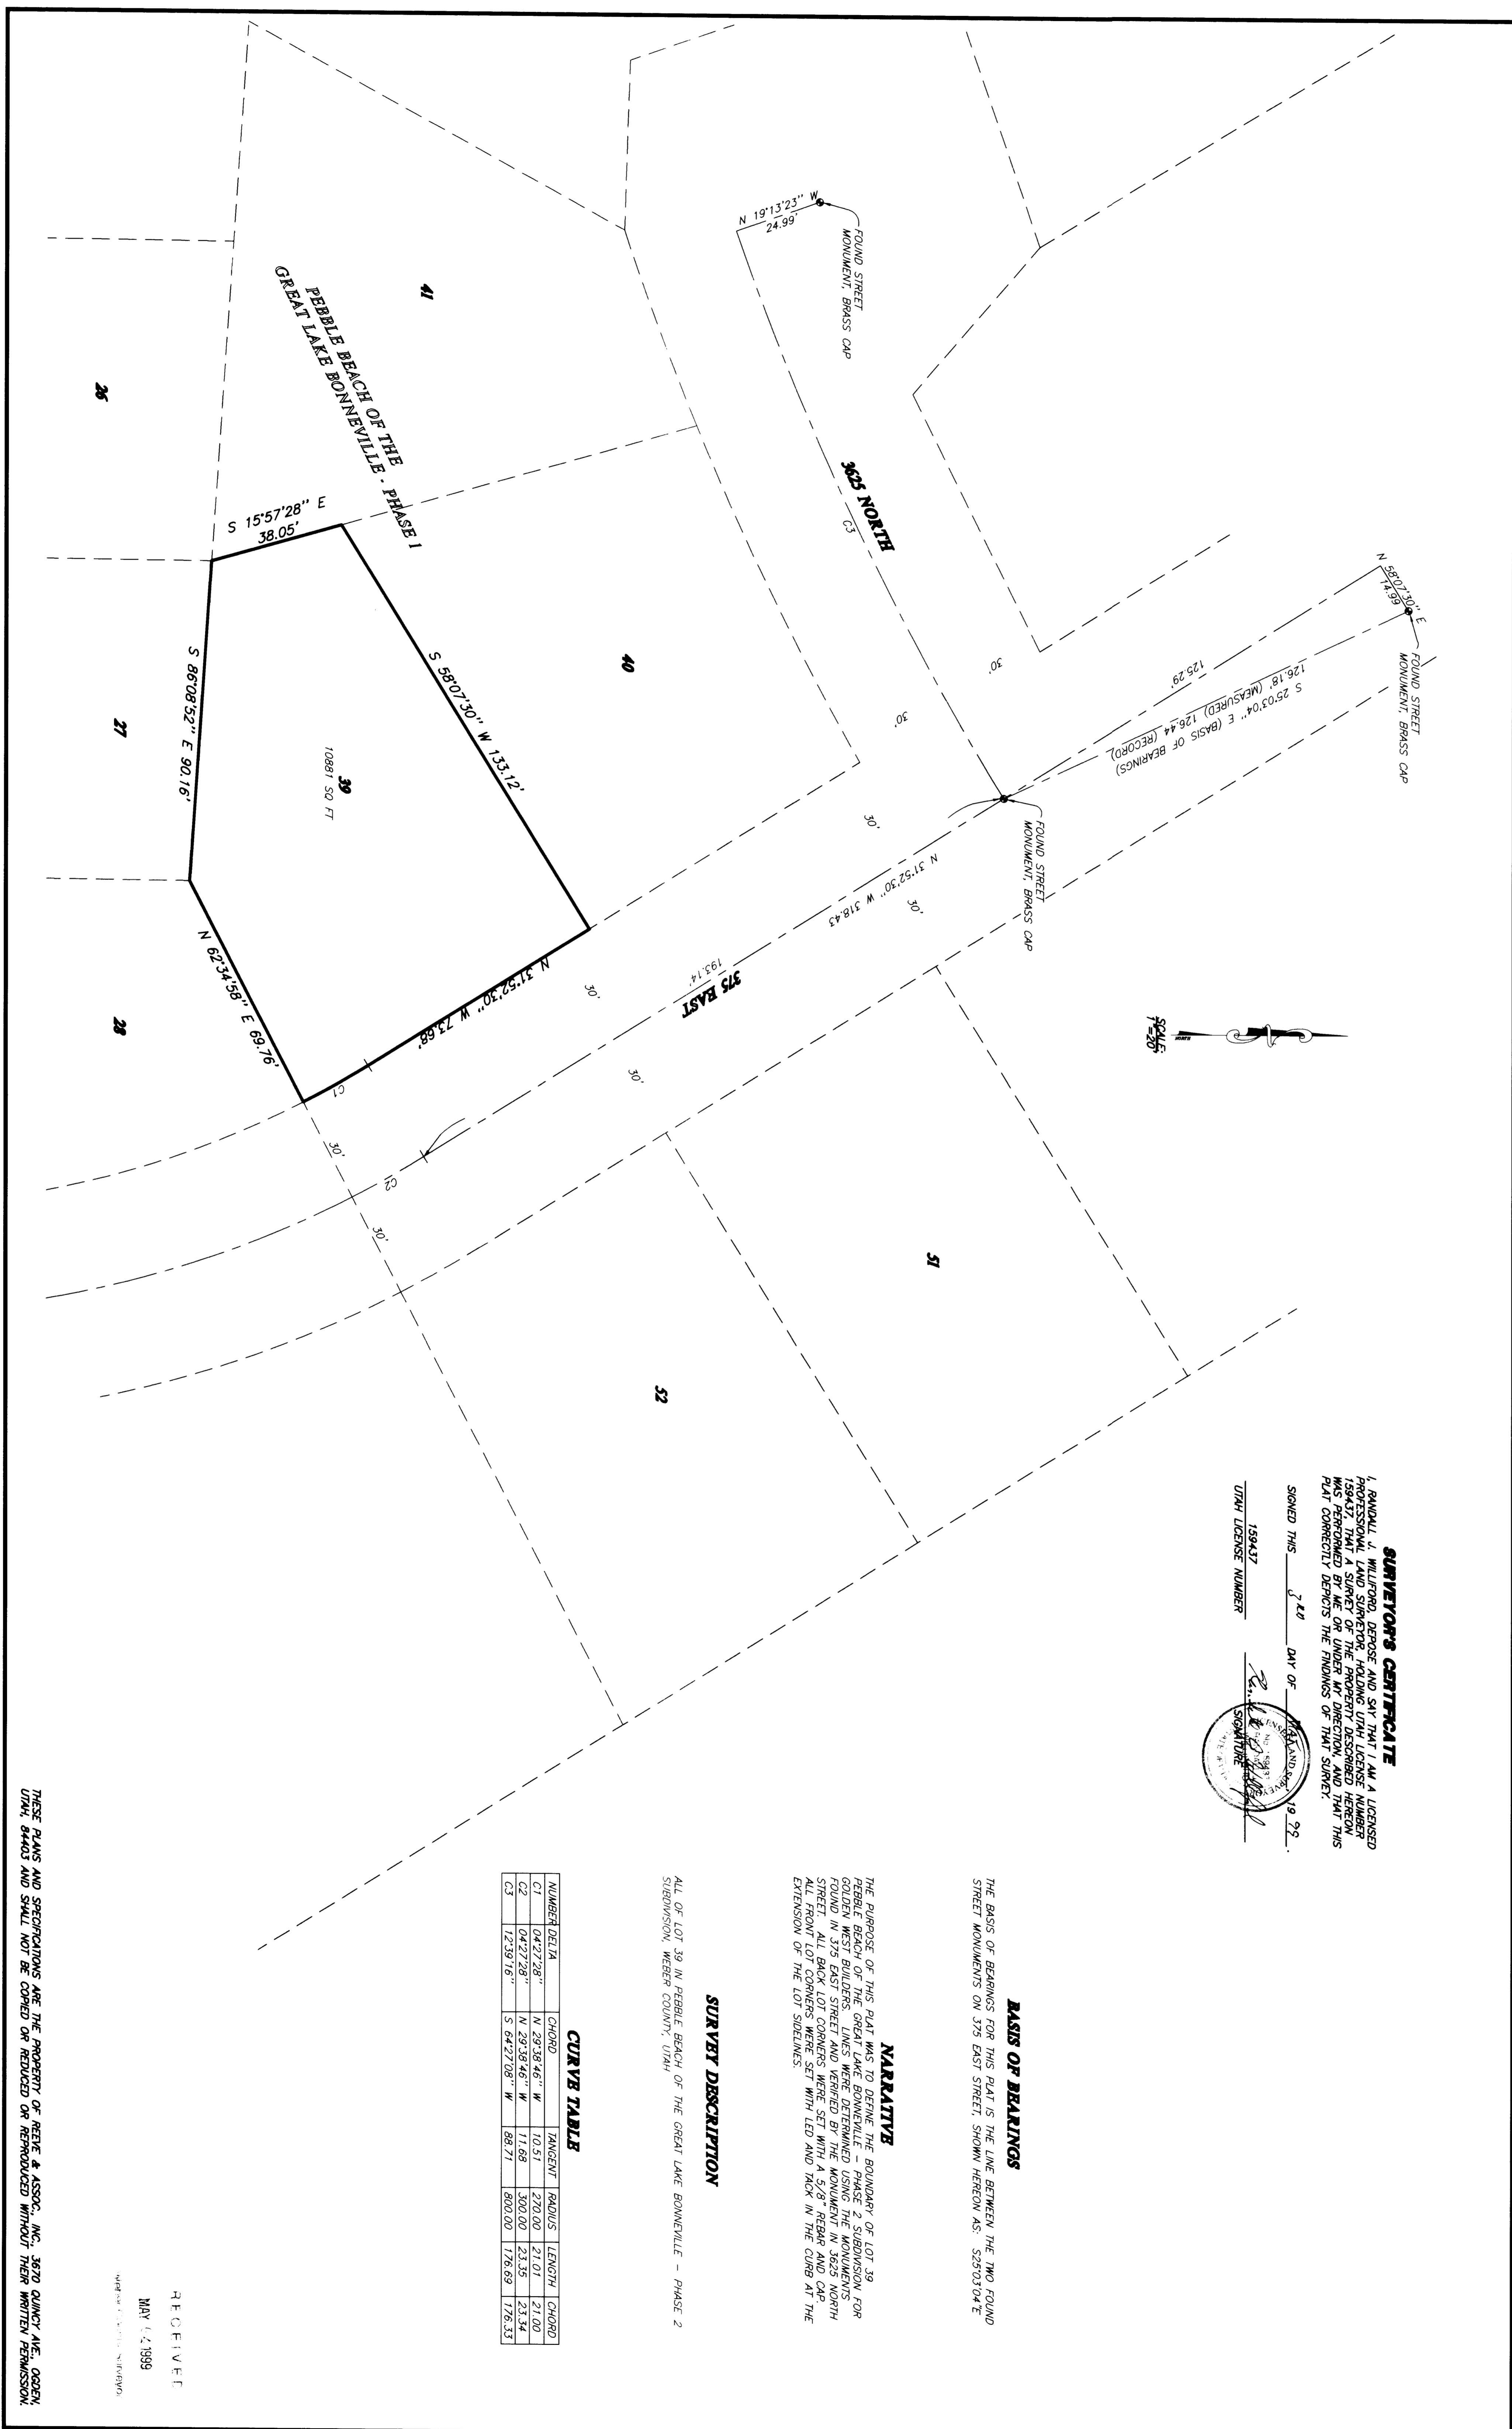

SURVEYOR'S CERTIFICATE
SIGNED THIS 3RD DAY OF FEBRUARY, 1999.
UTAH LICENSE NUMBER 159437



BASES OF BEARINGS
THE BASIS OF BEARINGS FOR THIS PLAT IS THE LINE BETWEEN THE TWO ROUND STREET MONUMENTS ON 375 EAST STREET, SHOWN HEREON AS: S25°03'04"E

NARRATIVE

SURVEY DESCRIPTION
ALL OF LOT 39, IN PEBBLE BEACH OF THE GREAT LAKE BONNEVILLE - PHASE 2 SUBDIVISION, WEBER COUNTY, UTAH

CURVE TABLE

NUMBER/BEARING	CHORD	TANGENT	RADIUS	LENGTH	CHORD
C2	0427'28"	N 29°38'46" W	11.68	300.00	23.34
C3	1239'16"	S 64°27'08" W	88.71	800.00	176.33

RECEIVED
MAY 12 1999