


PLAN HOLD CORPORATION • IRVINE, CALIFORNIA
REORDER BY NUMBER 0734R
POSITION LINE IS PART OF THE LINE

PLAN HOLD CORPORATION • IRVINE, CALIFORNIA
REORDER BY NUMBER 0734R
POSITION LINE IS PART OF THE LINE

PLAN HOLD CORPORATION • IRVINE, CALIFORNIA
REORDER BY NUMBER 0734R
POSITION LINE IS PART OF THE LINE

PLAN HOLD CORPORATION • IRVINE, CALIFORNIA
REORDER BY NUMBER 0734R
POSITION LINE IS PART OF THE LINE

C:\s1\p\002231-45.dwg Mon Jan 04 16:36:50 1999 1M

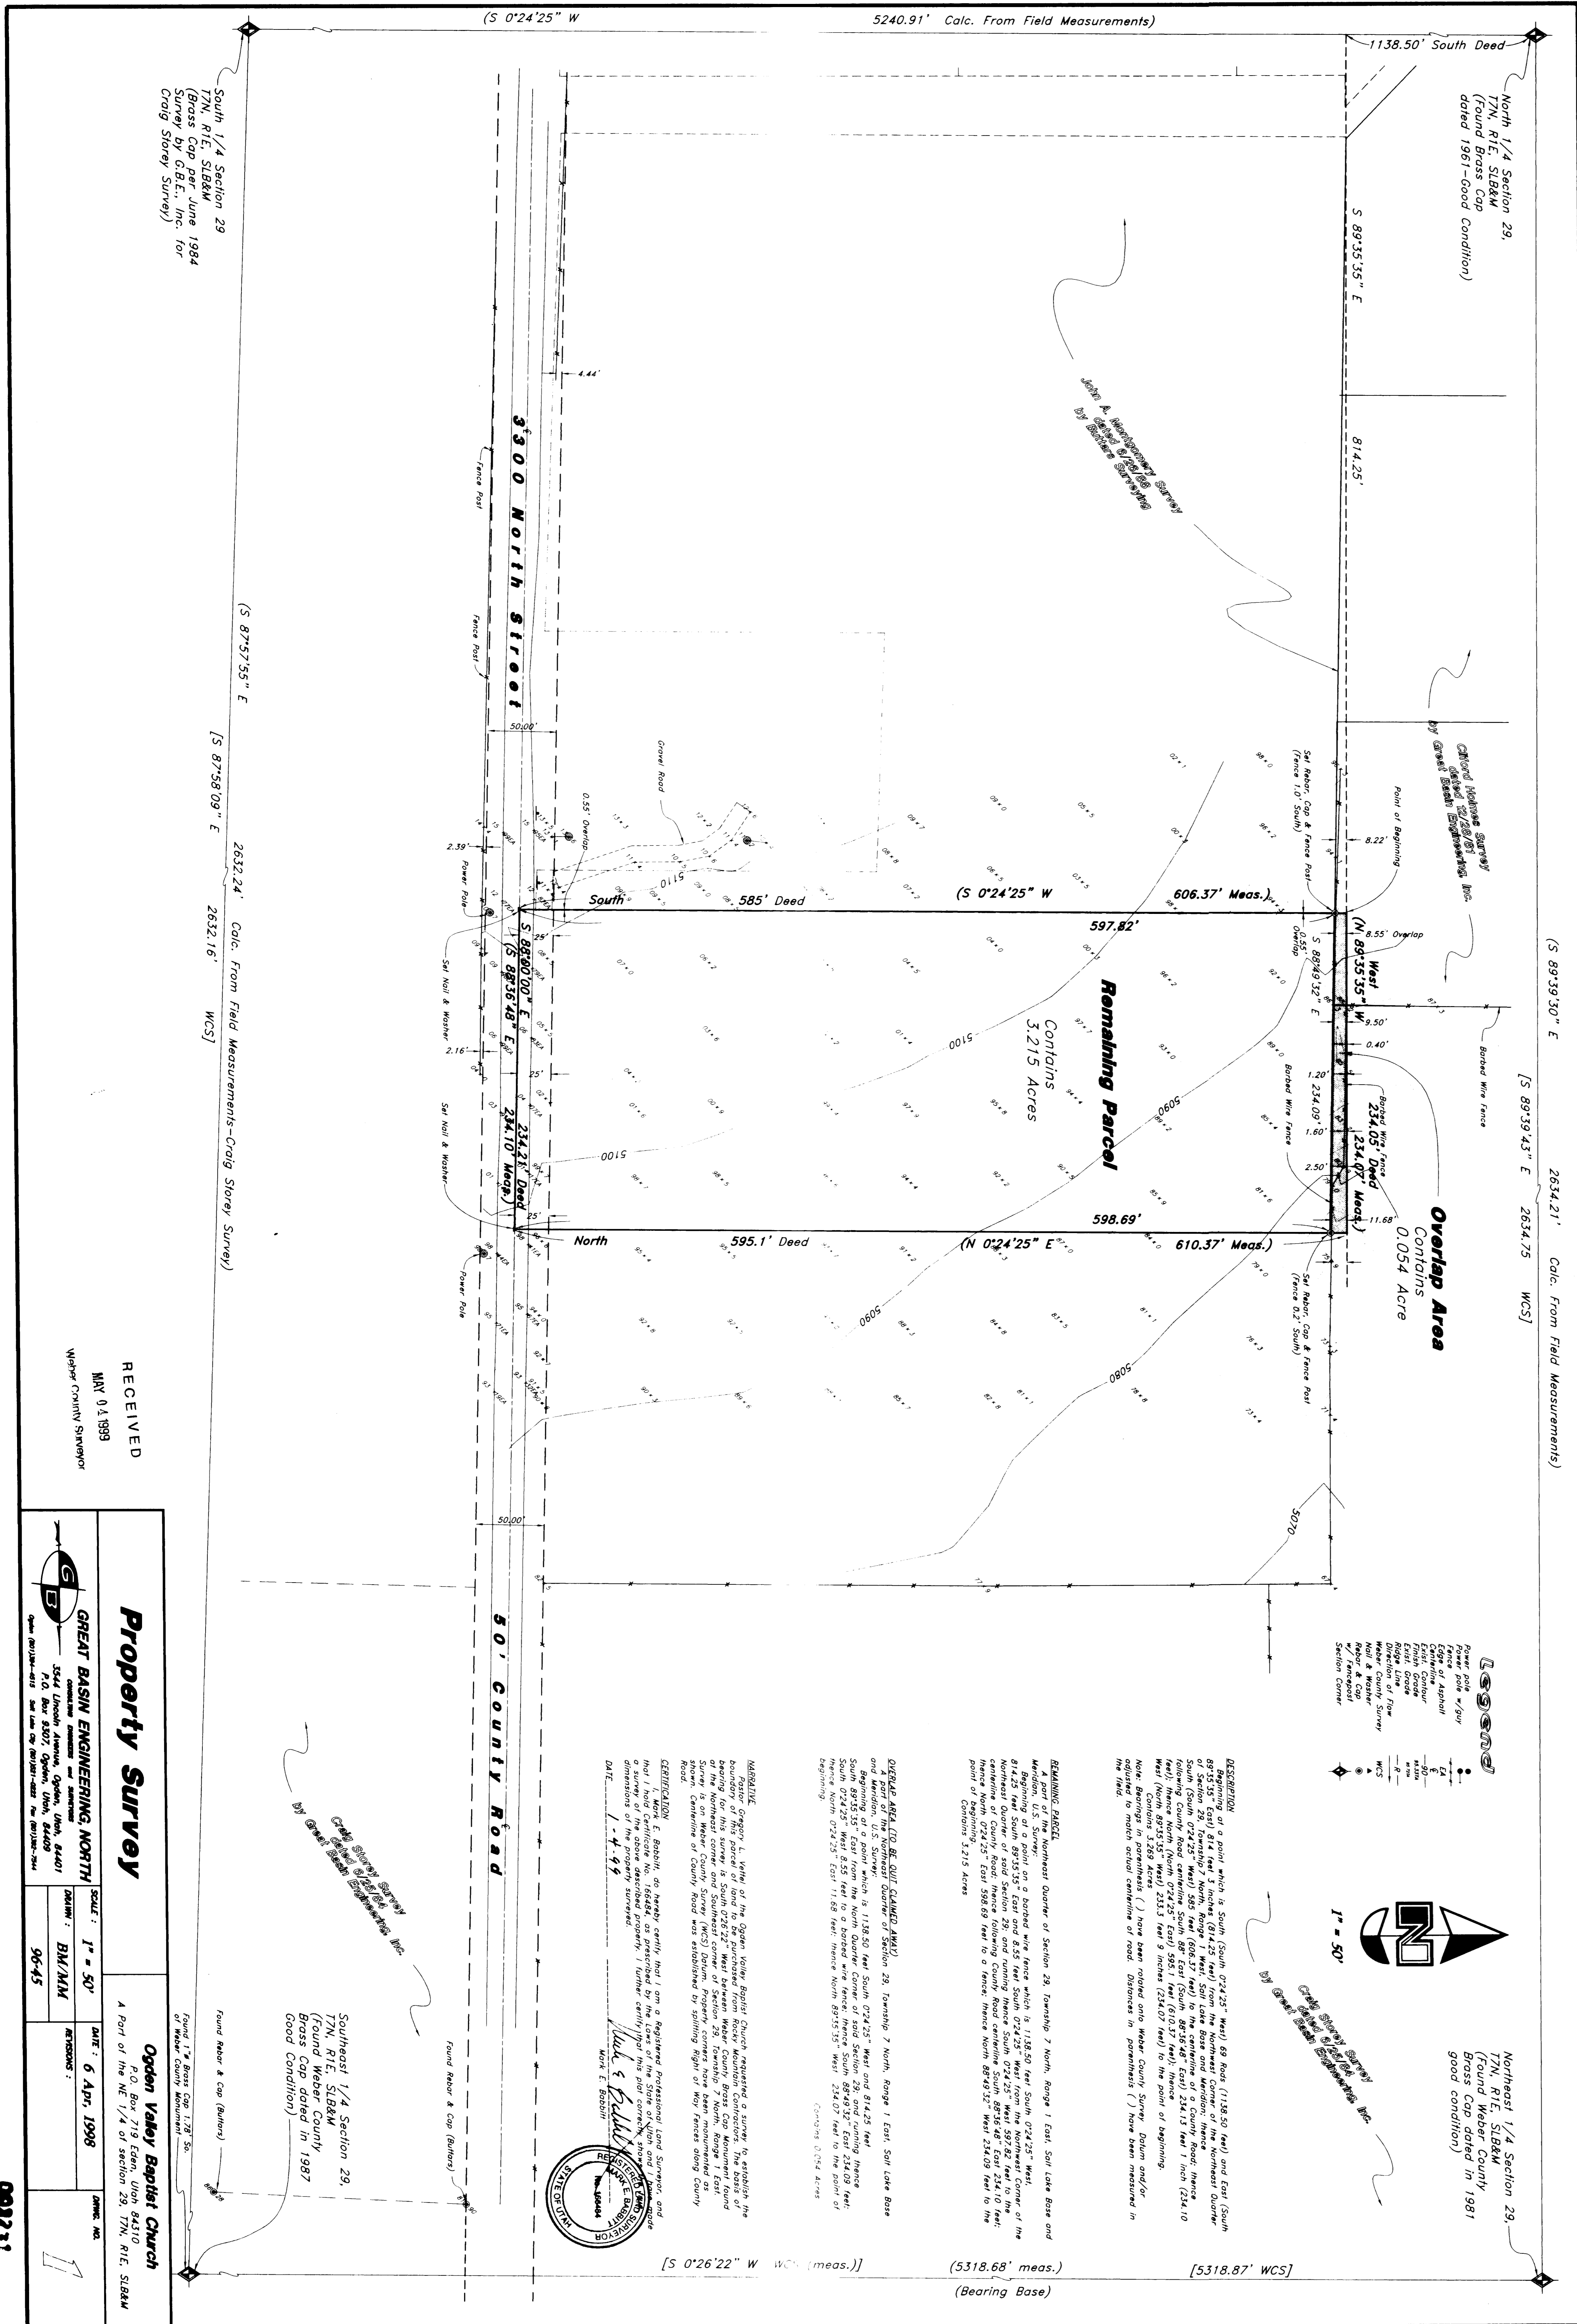


South 1/4 Section 29
T7N, R1E, SLB&M
(Brass Cap per June 1984
Survey by G.B.E., Inc. for
Craig Storey Survey)

North 1/4 Section 29
T7N, R1E, SLB&M

Remaining Parcel
Contains
3.215 Acres

Overlap Area
Contains
0.054 Acre

- LEGEND**

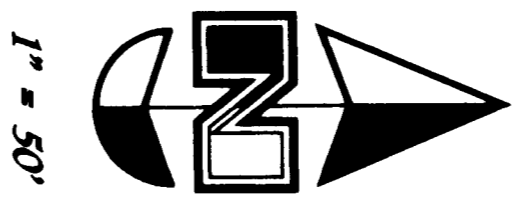

T7N, R1E, SLB&M
(Round Brass Cap dated in 1981
good condition)

002231

RECEIVED
MAY 04 1999
WEBER COUNTY SURVEYOR


Property Survey

GREAT BASIN ENGINEERING, NORTH
3544 Lincoln Avenue, Ogden, Utah 84401

DRAWN: BM/MM	REVISIONS:
96-45	

Ogden Valley Baptist Church
P.O. Box 719 Eden, Utah 84410
A Part of the NE 1/4 of Section 29, T7N, R1E, SLB&M
of Weber County, Utah



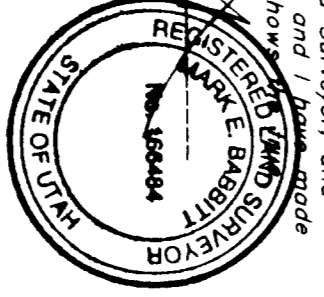









[S 0°26'22" W WCS (meas.)] (5318.68' meas.) [5318.87' WCS] (Bearing Base)