

LEGAL DESCRIPTION




SURVEYORS CERTIFICATE

I, Chester L. Nelson do hereby certify that I am a Registered Land Surveyor and that I hold Certificate No. 4263 (132028) as prescribed by the laws of the State of Utah, and that I have made a survey on the ground and from records of the Weber County Recorder's office as described herein and shown per this plat.

NARRATIVE




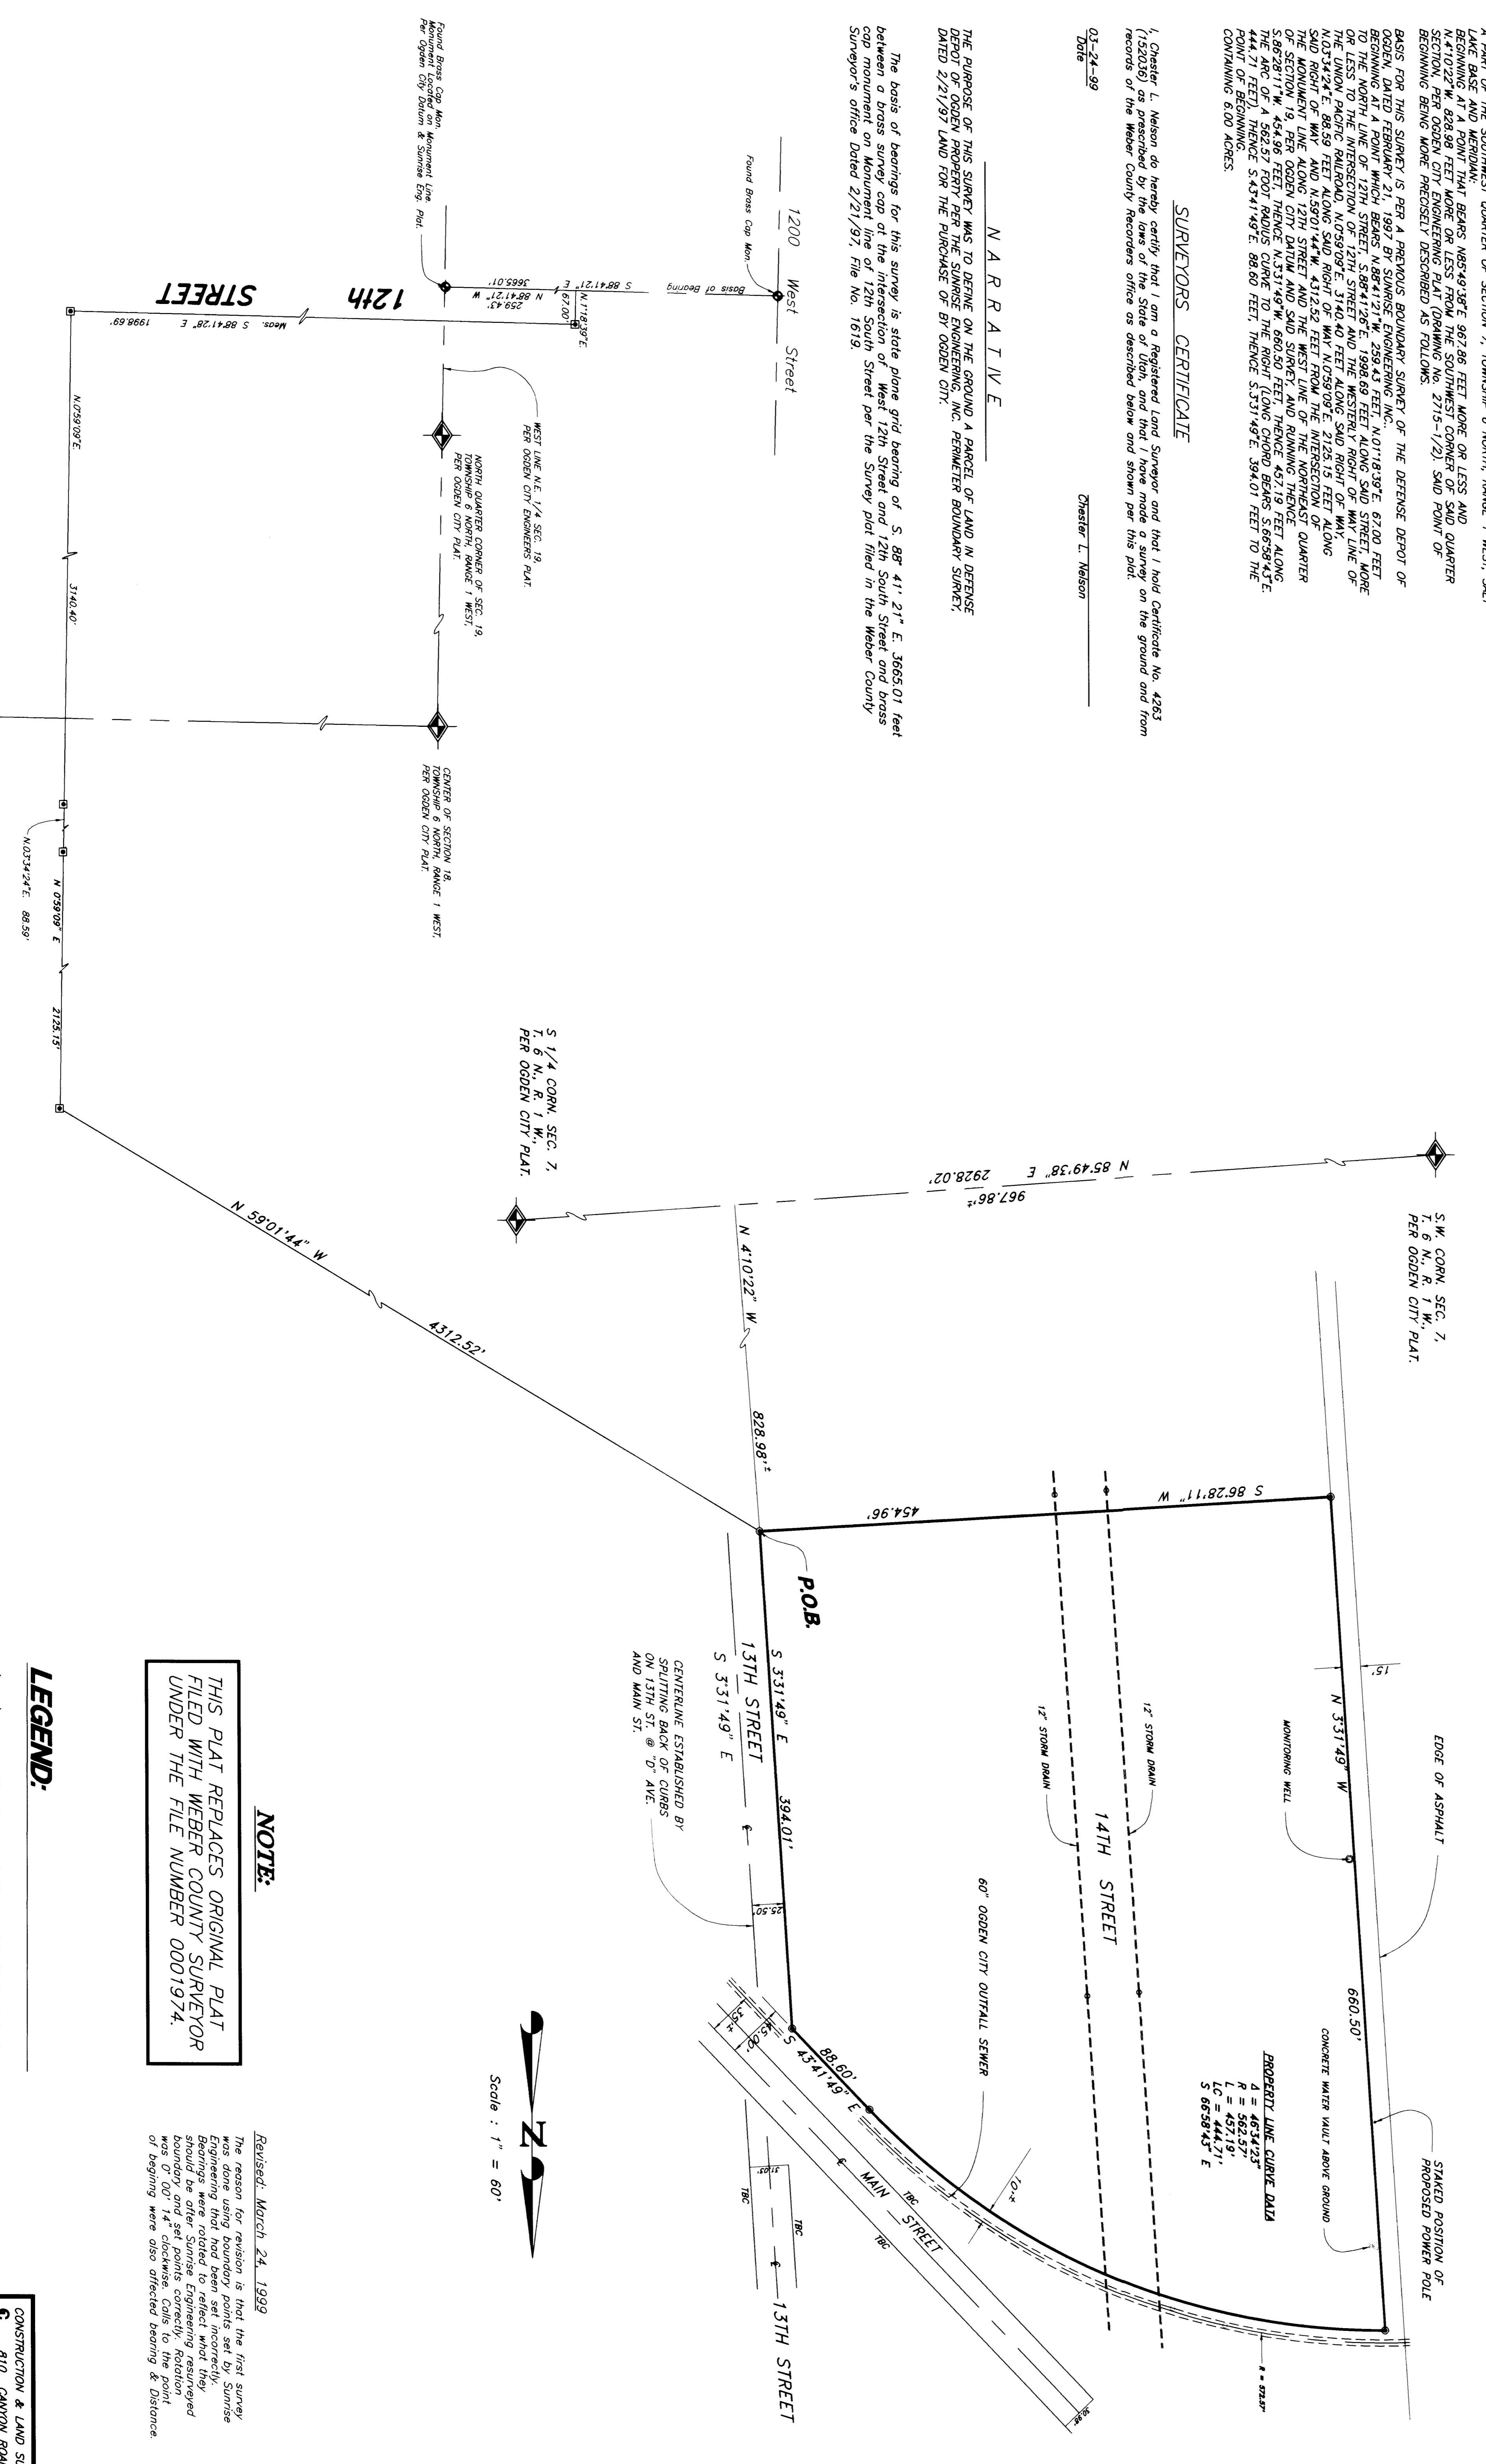


THIS PLAT REPLACES ORIGINAL PLAT FILED WITH WEBER COUNTY SURVEYOR UNDER THE FILE NUMBER 0001974.

NOTE:

Revised: March 24, 1999

LEGEND:

- () DISTANCE AND OR BEARING PER DEED OR PLAT.
- NO PARALLELS IS MEASURED DISTANCE OR ROTATED PLAT OR DEED BEARING TO STATE PLANE GRID BEARING.
- EXISTING FENCES.
- SET 3/4" REBAR WITH C & L.S. CAP.
- SUNBSE REBAR & CAP.

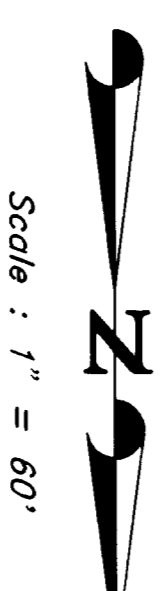

PREPARED BY:
CONSTRUCTION & LAND SURVEYORS

RECEIVED: MAY 07 1999
Weber County Surveyor

SURVEY LOCATION: S.W. 1/4 SEC. 7, TOWNSHIP 6 NORTH, RANGE 1 WEST, OGDEN CITY PLAT	SURVEY DATE: 1-21-98
JOB NO. PS98-037.DWG	