DRAWING NUMBER 002237
PLAN HOLD CORPORATION • IRVINE, CALIFORNIA
REORDER BY NUMBER STAMP
POSITIVE ONLY PRINTS ON THIS LINE

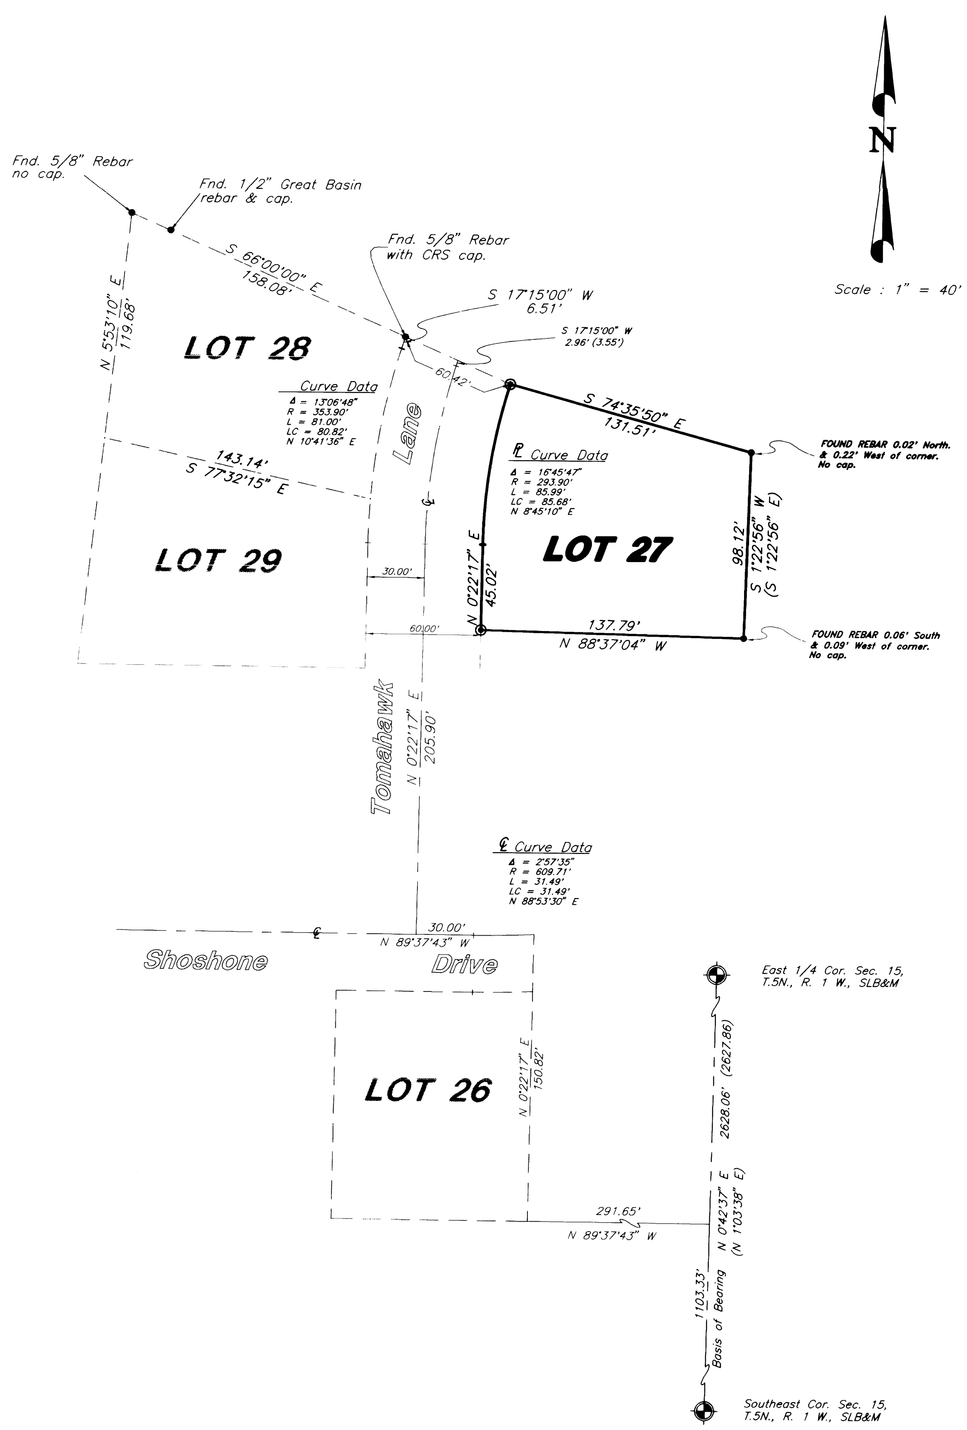


## SURVEYORS CERTIFICATE

I, Chester L. Nelson do hereby certify that I am a Registered Land Surveyor and that I hold Certificate No. 4263 (152036) as prescribed by the laws of the State of utah, and that I have made a survey on the ground and from records of the Weber CountyRecorders office as described below and shown per this plat.

3/30/99
Date

Chester L. Nelson

REGISTERED LAND SURVEYOR No. 4263 CHESTER L. NELSON STATE OF UTAH

## Boundary Description

All of Lot 27 Shoshone Hills – Phase 3, Ogden City, Weber County, Utah.

## Narrative

Purpose of Survey was to Restake the Four corners Lot 27, Shoshone Hills – Phase 3.

Basis of bearing is N. 0° 42' 37" E. along the East line of the Southeast Quarter of Section 15, Township 5 North, Range 1 West, Salt Lake , Base & Meridian, as Monumented.

## LEGEND:

( ) DISTANCE AND OR BEARING PER DEED OR PLAT.

NO PARENTHESES IS MEASURED DISTANCE OR ROTATED PLAT OR DEED BEARING TO STATE PLANE GRID BEARING.

EXISTING FENCES.

SET 5/8" REBAR WITH C. & L.S. CAP.

FOUND REBAR.

PREPARED BY:
CONSTRUCTION & LAND SURVEYORS
810 CANYON ROAD
PH. (801) 399-4935 OGDEN, UTAH 84404 FAX (801) 627-1068

REC
MAY
Weber

CONSTRUCTION & LAND SURVEYORS
810 CANYON ROAD
OGDEN, UTAH 84404
(801) 399-4935

CLIENT: R & O Construction

SURVEY LOCATION: S.E. 1/4 SEC. 15, TOWNSHIP 5 NORTH, RANGE 1 WEST, SALT LAKE BASE & MERIDIAN

SURVEY DATE: 3-29-99

JOB No. PS99-14

PS99-14.DWG