



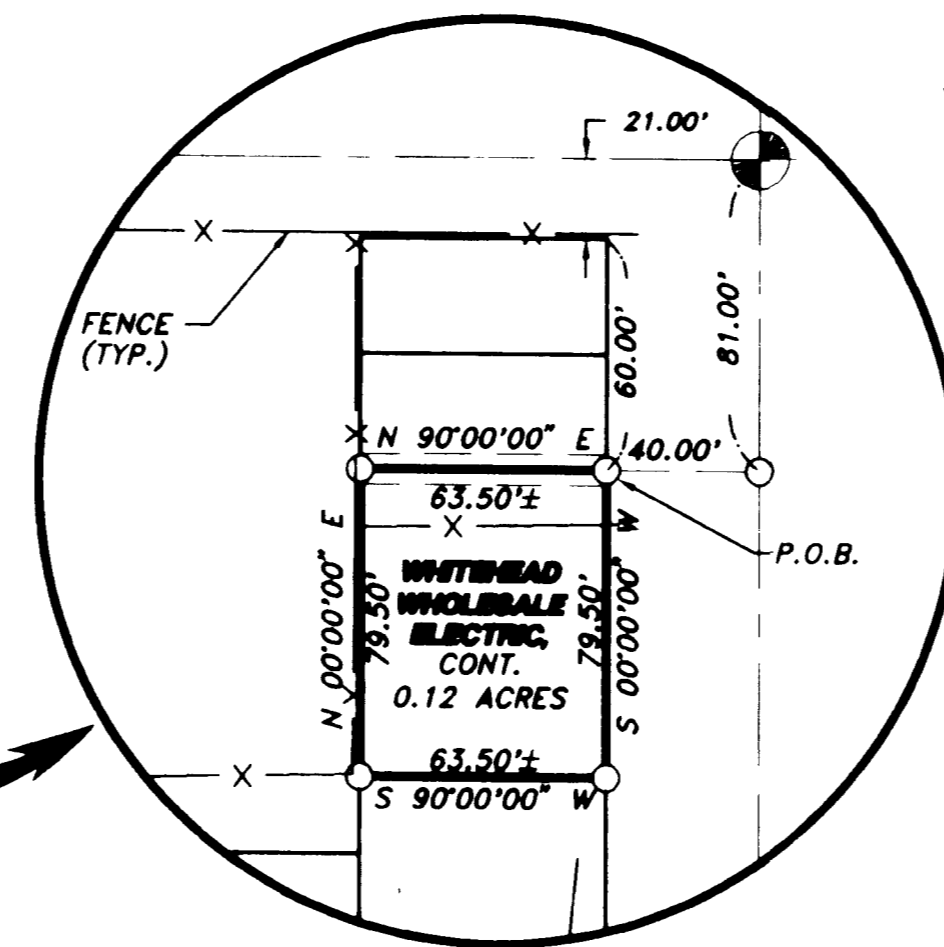

SCALE: 1" = 100'

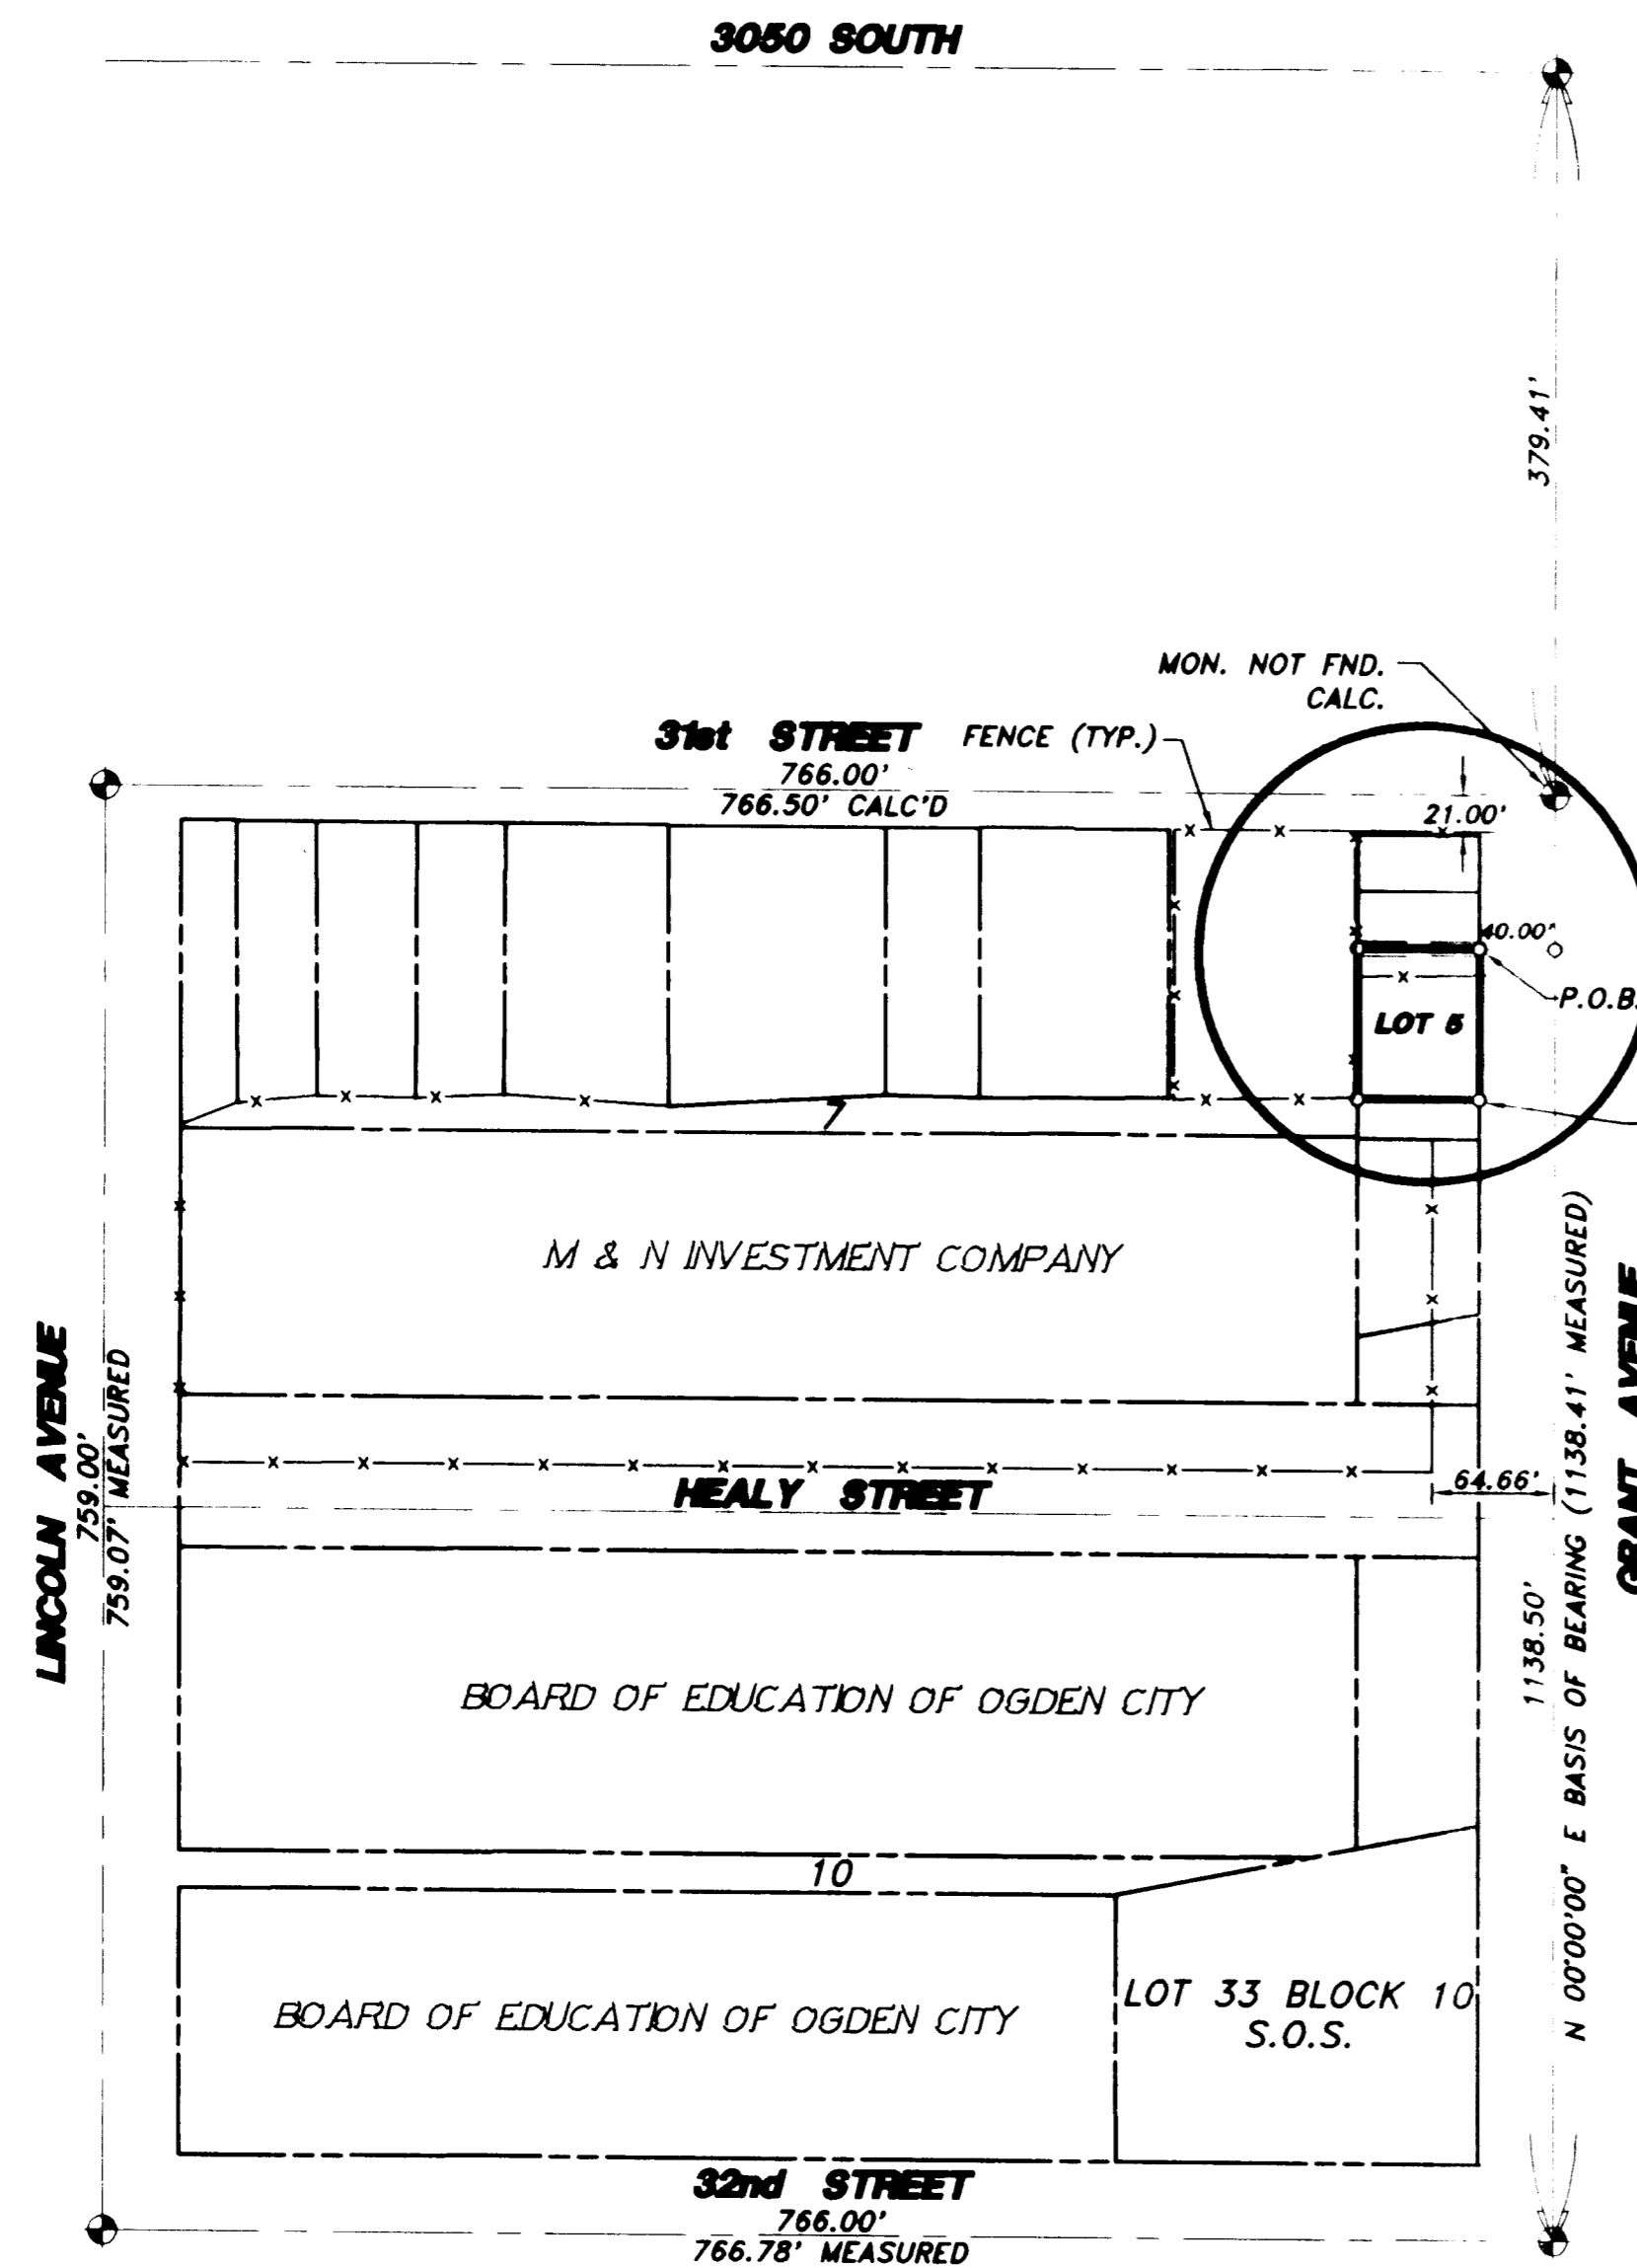

### NARRATIVE

THE PURPOSE OF THIS SURVEY WAS TO ESTABLISH AND SET THE PROPERTY CORNERS OF THE PARCEL SHOWN AND DESCRIBED HEREON. THE SURVEY WAS ORDERED BY WHITEHEAD WHOLESALE ELECTRIC INC. THE PROPERTY OWNER. THE CONTROL USED TO ESTABLISH THE PROPERTY LINES WAS THE BASIS OF BEARING OF THE CENTERLINE OF GRANT AVENUE WHICH BEARS NORTH 00°00'00" EAST 1138.41 FEET.

### DESCRIPTION

A PART OF LOT 5, BLOCK 10, SOUTH OGDEN SURVEY, WEBER COUNTY, UTAH BEGINNING AT A POINT ON THE WEST LINE OF GRANT AVENUE 60.00 FEET SOUTH OF THE SOUTH LINE OF 31ST STREET, AND RUNNING THENCE SOUTH 79.50 FEET, THENCE WEST 63.50 FEET, MORE OF LESS, TO THE EAST LINE OF LOT 48, BLOCK 7, CENTRAL PARK ADDITION, OGDEN CITY, WEBER COUNTY, UTAH, THENCE NORTH 79.50 FEET, THENCE EAST 63.50 FEET, MORE OF LESS, TO THE POINT OF BEGINNING. CONTAINING 0.12 ACRES.

### SURVEY CERTIFICATE

I, K Greg Hansen, do hereby certify that I am a Registered Land Surveyor, and that I hold Certificate No. 167819 as prescribed by the Laws of the State of Utah, and that I have made and/or supervised the survey of the property shown and described hereon and that this plat is a true and correct representation of said survey to the best of my knowledge and belief.

RECEIVED  
MAY 10 1999  
Weber County Surveyor

K. Greg Hansen, R.L.S. No. 167819  
Date



<b>HANSEN &amp; ASSOCIATES, INC.</b> Consulting Engineers and Land Surveyors 538 North Main Brigham City, Utah 84302 801-733-3441 801-733-4805 732-8872				
Drawn By: DM Designed By: J/1/18/98 Checked By: J/1/18/98 Approved By: J/1/18/98 Scale: 1" = 100.00' JOB NUMBER: 98-3-85 (98-3-855.mwg)	No.	By	Date	Revision
PROPERTY SURVEY FOR <b>WHITEHEAD WHOLESALE ELECTRIC INC.</b> 247 31st STREET, OGDEN, UTAH A PART OF THE NORTHWEST QUARTER OF SECTION 13, T11N, R3W, S.L.B.&M.				
SHEET <b>1</b> OF <b>1</b> SHEETS				

002240

002240 96-3-85