RECORD OF SURVEY

Centerline Monumentation of Meadowcreek Subdivision Phases 1 and 2

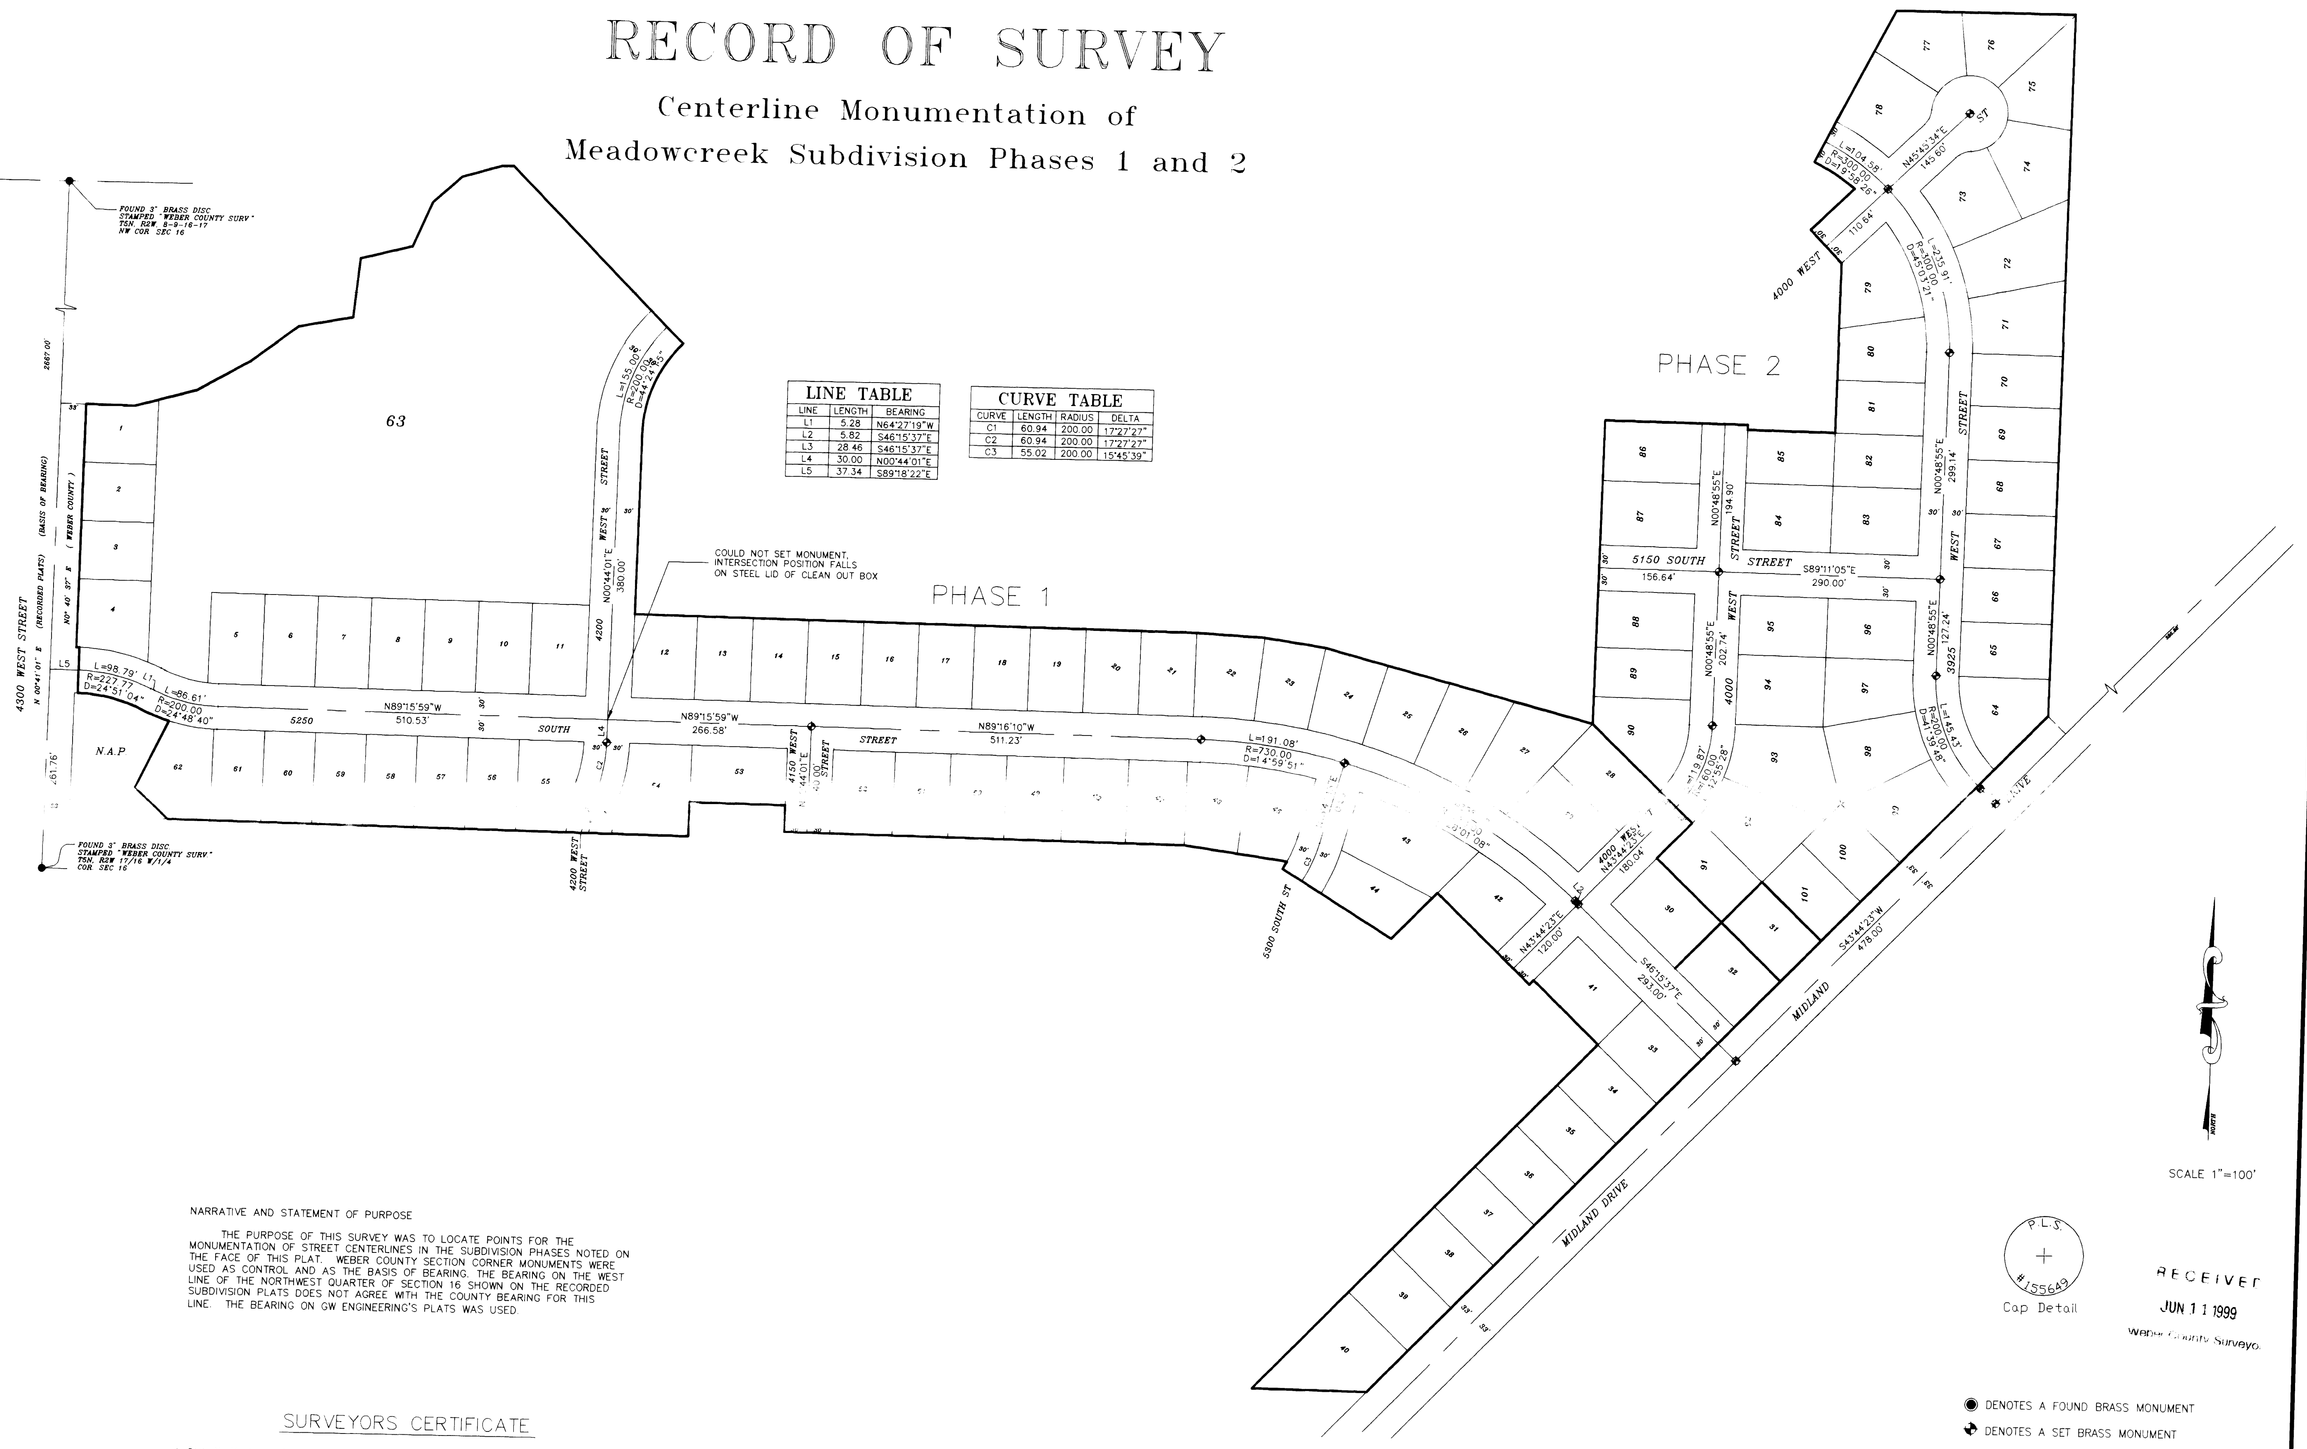

LINE TABLE		
LINE	LENGTH	BEARING
L1	5.28	N64°27'19"W
L2	5.82	S46°15'37"E
L3	28.46	S46°15'37"E
L4	30.00	N00°44'01"E
L5	37.34	S89°18'22"E

CURVE TABLE			
CURVE	LENGTH	RADIUS	DELTA
C1	60.94	200.00	17°27'27"
C2	60.94	200.00	17°27'27"
C3	55.02	200.00	15°45'39"

NARRATIVE AND STATEMENT OF PURPOSE

THE PURPOSE OF THIS SURVEY WAS TO LOCATE POINTS FOR THE MONUMENTATION OF STREET CENTERLINES IN THE SUBDIVISION PHASES NOTED ON THE FACE OF THIS PLAT. WEBER COUNTY SECTION CORNER MONUMENTS WERE USED AS CONTROL AND AS THE BASIS OF BEARING. THE BEARING ON THE WEST LINE OF THE NORTHWEST QUARTER OF SECTION 16 SHOWN ON THE RECORDED SUBDIVISION PLATS DOES NOT AGREE WITH THE COUNTY BEARING FOR THIS LINE. THE BEARING ON GW ENGINEERING'S PLATS WAS USED.

SURVEYORS CERTIFICATE

I, Dick N. Mechem, do hereby certify that I am a licensed land surveyor of the State of Utah and that this map consisting of 1 sheet is a true and complete representation of a survey made (under my supervision) in May 99 for GW Engineering and in behalf of Mountain West PLS, LLC and that all monuments shown hereon are of the character and occupy the positions indicated and are sufficient to enable the survey to be retraced.

DICK N. MECHEM, P.L.S. — DATE

P.L.S. #155649 — Cap Detail

RECEIVED JUN 11 1999 Weber County Surveyor

● DENOTES A FOUND BRASS MONUMENT

◆ DENOTES A SET BRASS MONUMENT

RECORD OF SURVEY for GW ENGINEERING

Located In Section 16, Township 5 North, Range 2 WEST, S.L.B.&M.

Date May 25 99	No. 23-08-98	Drwn RAM	Ck'd DNM

MountainWest Professional Land Surveyors, L.L.C.
1825 W 4400 S. PO Box 207
Roy, Utah 84067
Phone: (801) 731-5330 Fax: (801) 731-5331

DRAWING NUMBER




Thu Jun 03 14:24:31 1999