

1.	REVISIONS
2.	
3.	
4.	
5.	
6.	

PROJECT NO. 2811-01 SURVEYOR: LARRY HANSEN  
 DATE: 5-26-99 DRAWN: JAC  
 SCALE: 1" = 20' CHECKED:

**REEVE & ASSOCIATES, INC.**  
 ENGINEERS PLANNERS & SURVEYORS  
 3670 COOK DR, SUITE 100, NO. 1  

**RECORD OF SURVEY**

**LARRY HANSEN PROPERTY**  
 PART OF THE NORTHEAST QUARTER OF SECTION 1, T4N, R2W, S1&R4M, U.S. SURVEY  
 1897


SHEET	1
SHEETS	1

**BOUNDARY DESCRIPTION**  
 PART OF THE NORTHEAST 1/4 OF SECTION 1, T4N, R2W, S1&R4M, U.S. SURVEY, DESCRIBED AS FOLLOWS:  
 BEGINNING AT A POINT WHICH IS ON THE WEST RIGHT-OF-WAY LINE OF U.S. STREET, DESCRIBED AS FOLLOWS:  
 CONTAINS 13,790 SQUARE FEET.


**BASES OF BEARINGS**  

**NARRATIVE**  
 THE PURPOSE OF THIS SURVEY IS TO EXPAND THE LIMITS OF AN EXISTING PARCEL FOR LARRY HANSEN. THE EAST LINE WAS SET BY THE WEST LINE OF 1200 WEST STREET. THE WEST LINE WAS SET BY THE CLIENT. THE BOUNDARY CORNERS WERE SET WITH A 5/8" REBAR AND CAP MARKED "REVEE & REVEE".

**DEED DESCRIPTION**  
 A PART OF THE NORTHEAST QUARTER OF SECTION 1, TOWNSHIP 4 NORTH, RANGE 2 WEST, S&R4M, U.S. SURVEY, U.S. SURVEY, BEGINNING AT A POINT WHICH IS SOUTH 2,134.4 FEET TO THE NORTH LINE OF HARRISVILLE ROAD AND SOUTH 89°45' WEST 864.4 FEET, MORE OR LESS ALONG SAID EAST LINE, 192 FEET ALONG THE WEST LINE OF 1200 WEST STREET AND EAST 192 FEET ALONG THE WEST LINE OF 1200 WEST STREET FROM THE NORTHEAST CORNER OF SAID QUARTER SECTION, AND RUNNING THENCE NORTH 3° EAST 100 FEET ALONG SAID STREET, THENCE SOUTH 89°45' WEST 125 FEET, THENCE SOUTH 03° WEST 100 FEET, THENCE NORTH 07°32' EAST 37.76 FEET TO THE PLACE OF BEGINNING.

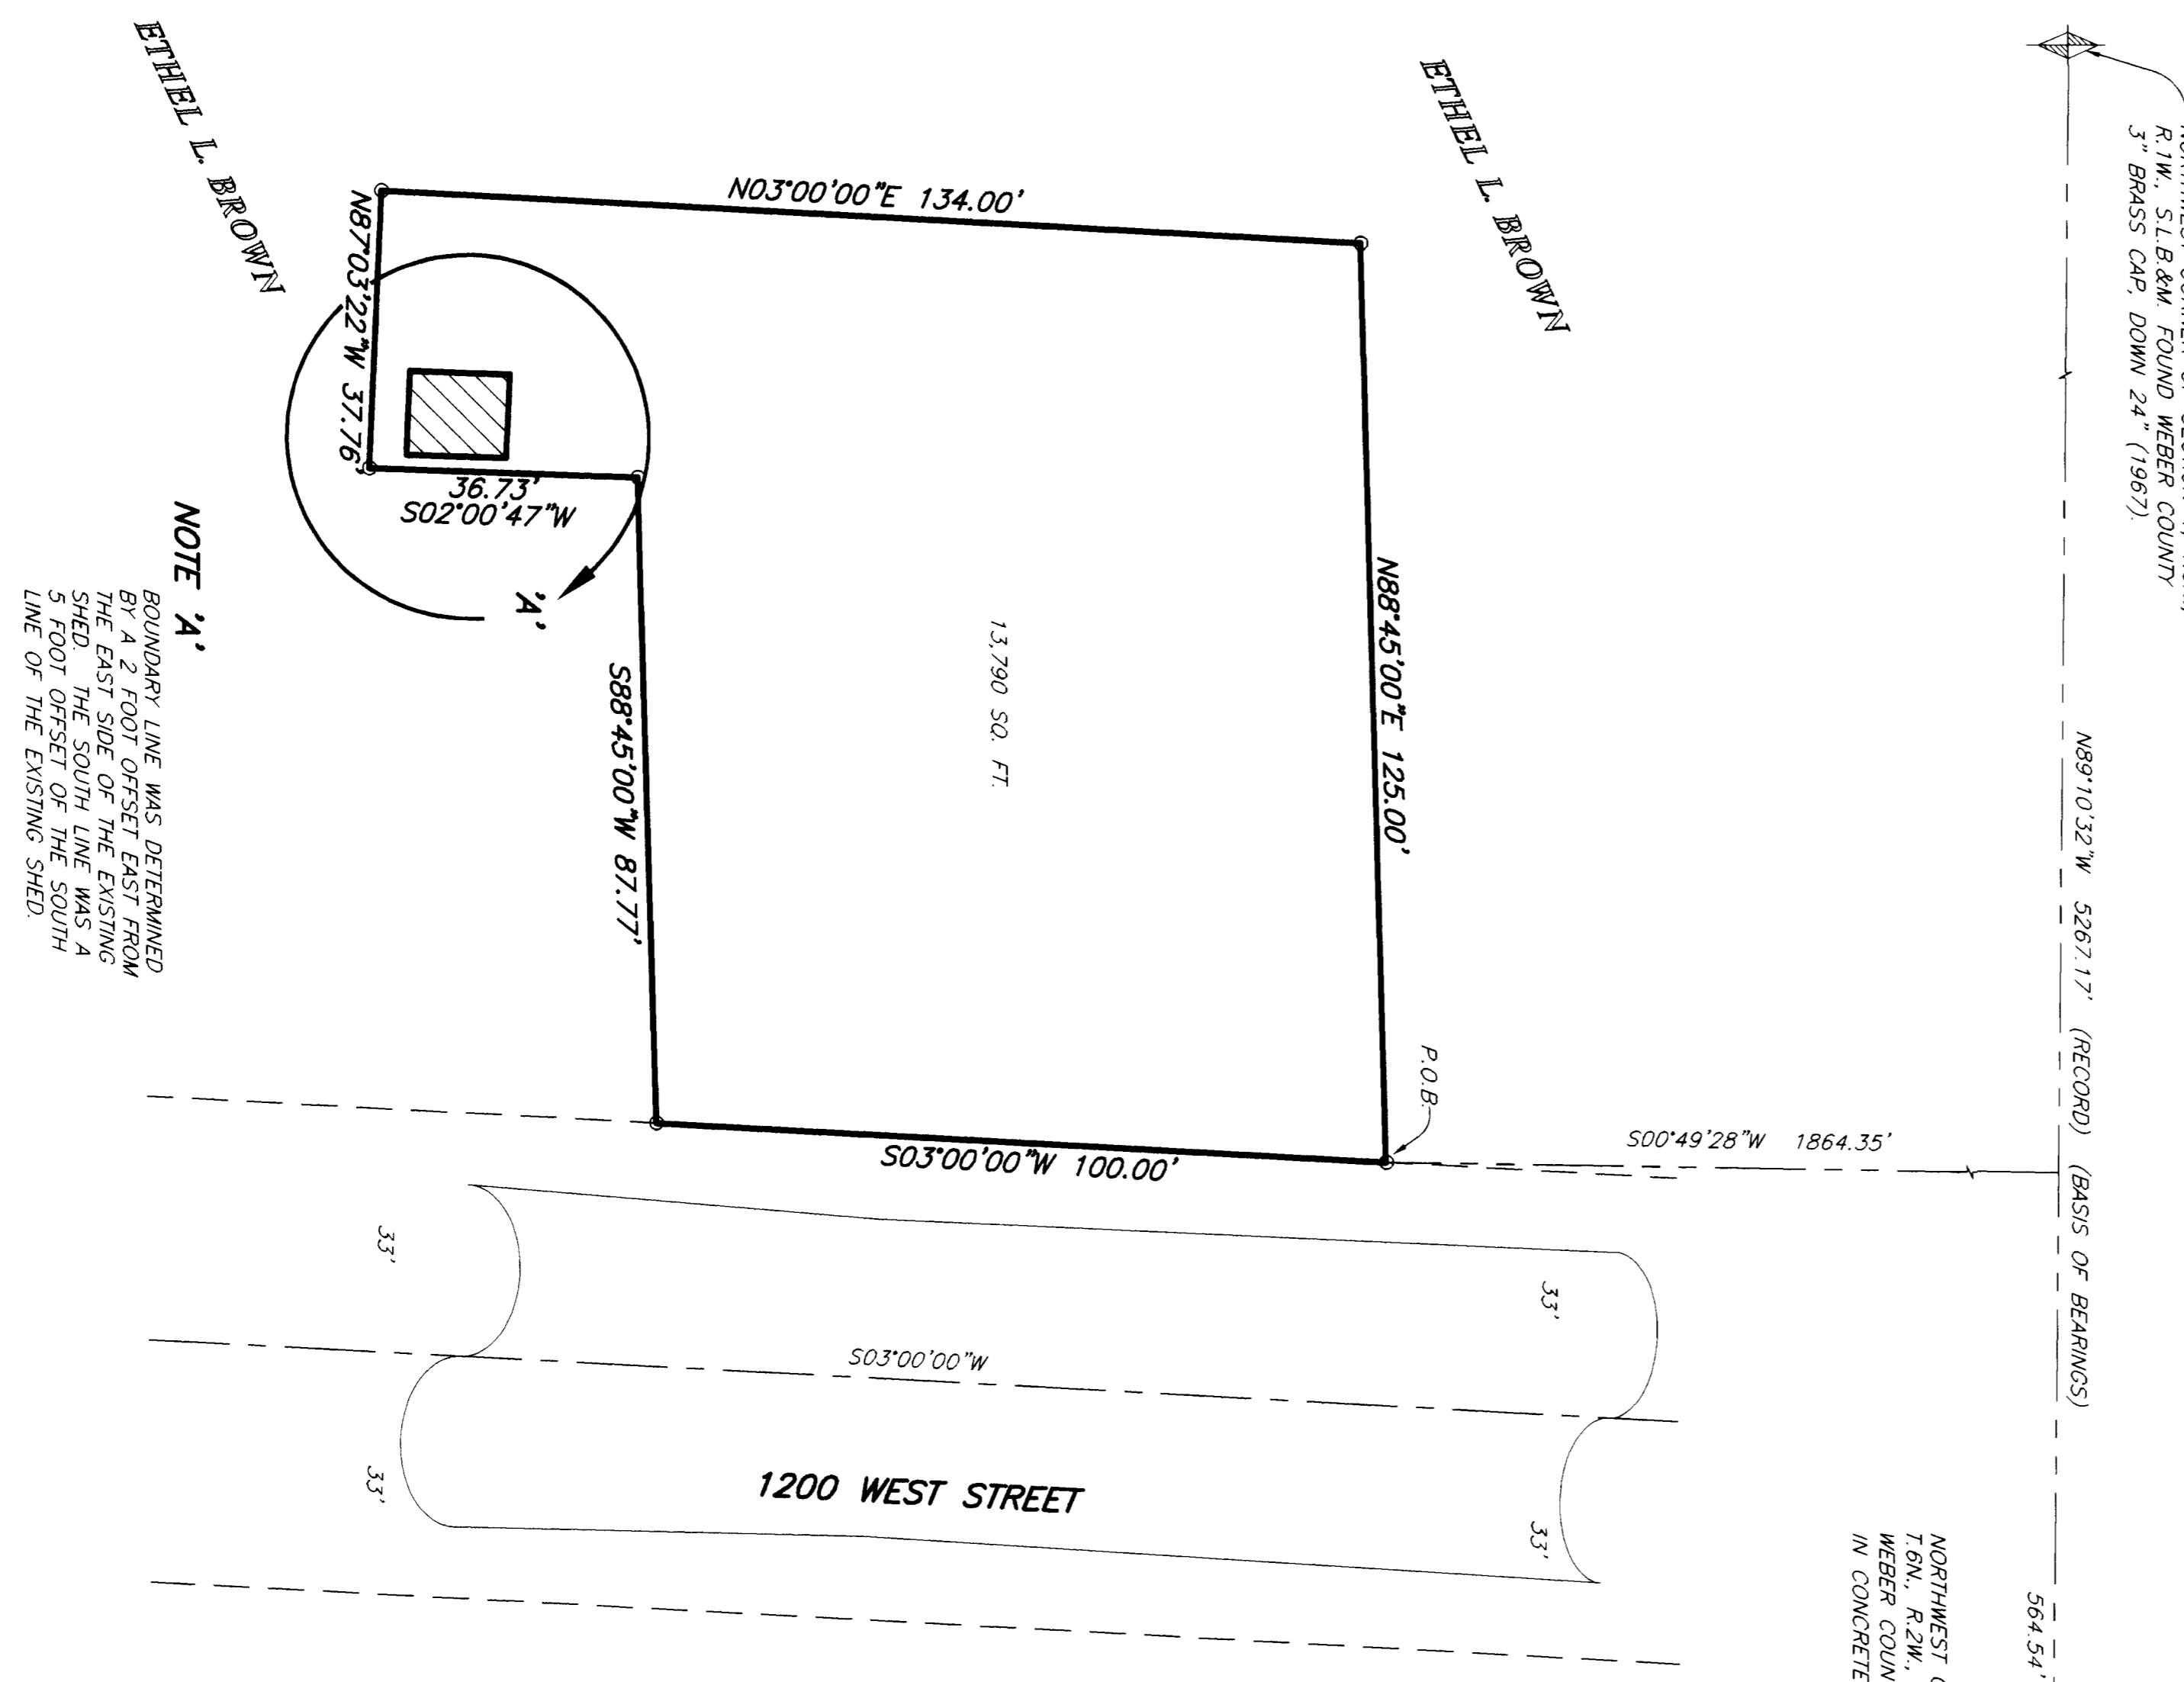

**NOTE A:**  
 BOUNDARY LINE WAS DETERMINED BY A 2 FOOT OFFSET EAST FROM THE EAST SIDE OF THE EXISTING 5 FOOT OFFSET OF THE SOUTH LINE OF THE EXISTING SHED.

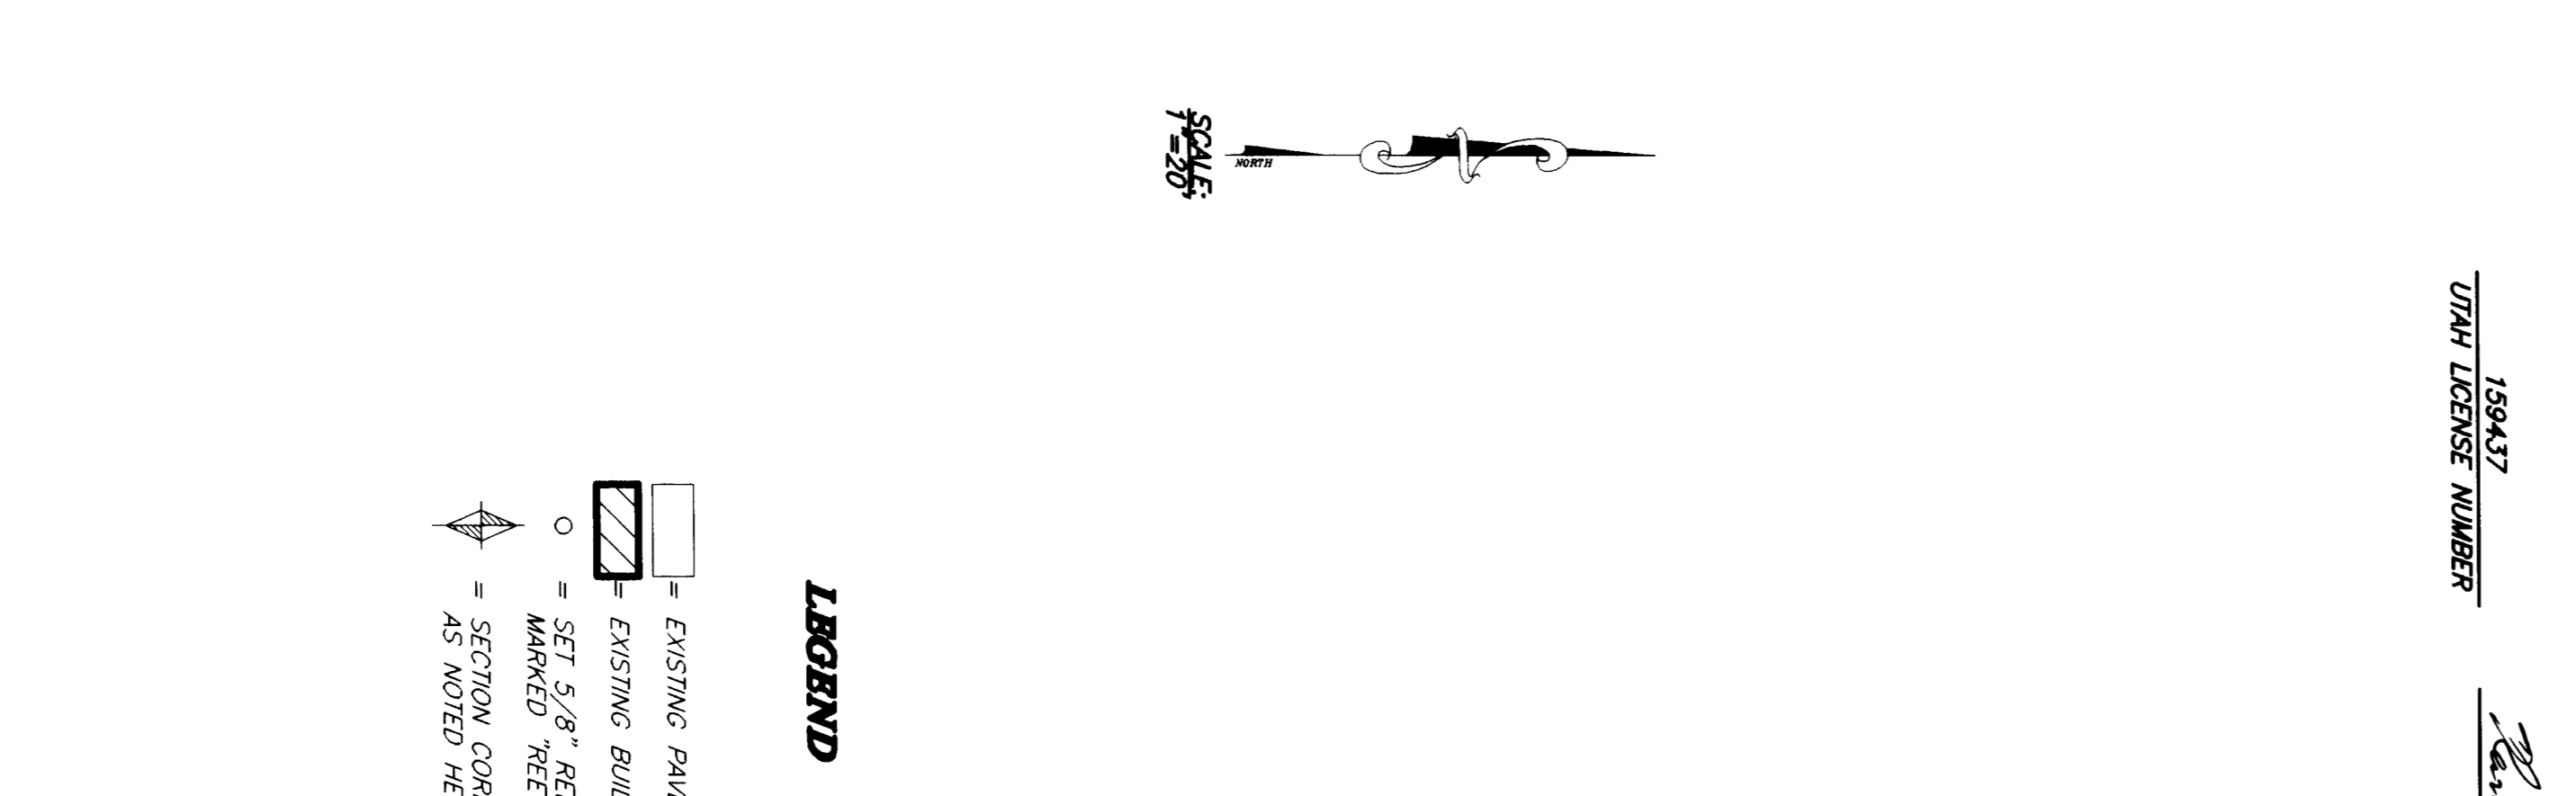

**SURVEYOR'S CERTIFICATE**  

SIGNED THIS 26<sup>TH</sup> DAY OF MAY 1999.  
 RANDALL J. WILFORD  

RECEIVED  
 JUN 2 1999  
 Weber County Survey

THESE PLANS AND SPECIFICATIONS ARE THE PROPERTY OF REVEE & ASSOC., INC., 3670 COOK AVE., OGDEN, UTAH, 84403 AND SHALL NOT BE COPIED OR REDUCED OR REPRODUCED WITHOUT THEIR WRITTEN PERMISSION.