


**SURVEYOR'S CERTIFICATE**  



**BASIS OF BEARINGS**



**NARRATIVE**

THE PURPOSE OF THIS SURVEY IS TO DEFINE THE BOUNDARY OF LOT 7, ALLEN TAYLOR SUBDIVISION FOR RICHARD GEORGE SUGBAYSON PAT AFTER REFERRING TO THE CORNER BEARING BASE FROM THE TWO FOUND SECTION CORNERS.

**SURVEY DESCRIPTION**

ALL OF LOT 7, ALLEN TAYLOR SUBDIVISION, WEBER COUNTY, UTAH  
CONTAINS: 30286 SQUARE FEET

**2000 WEST STREET (I-84)**

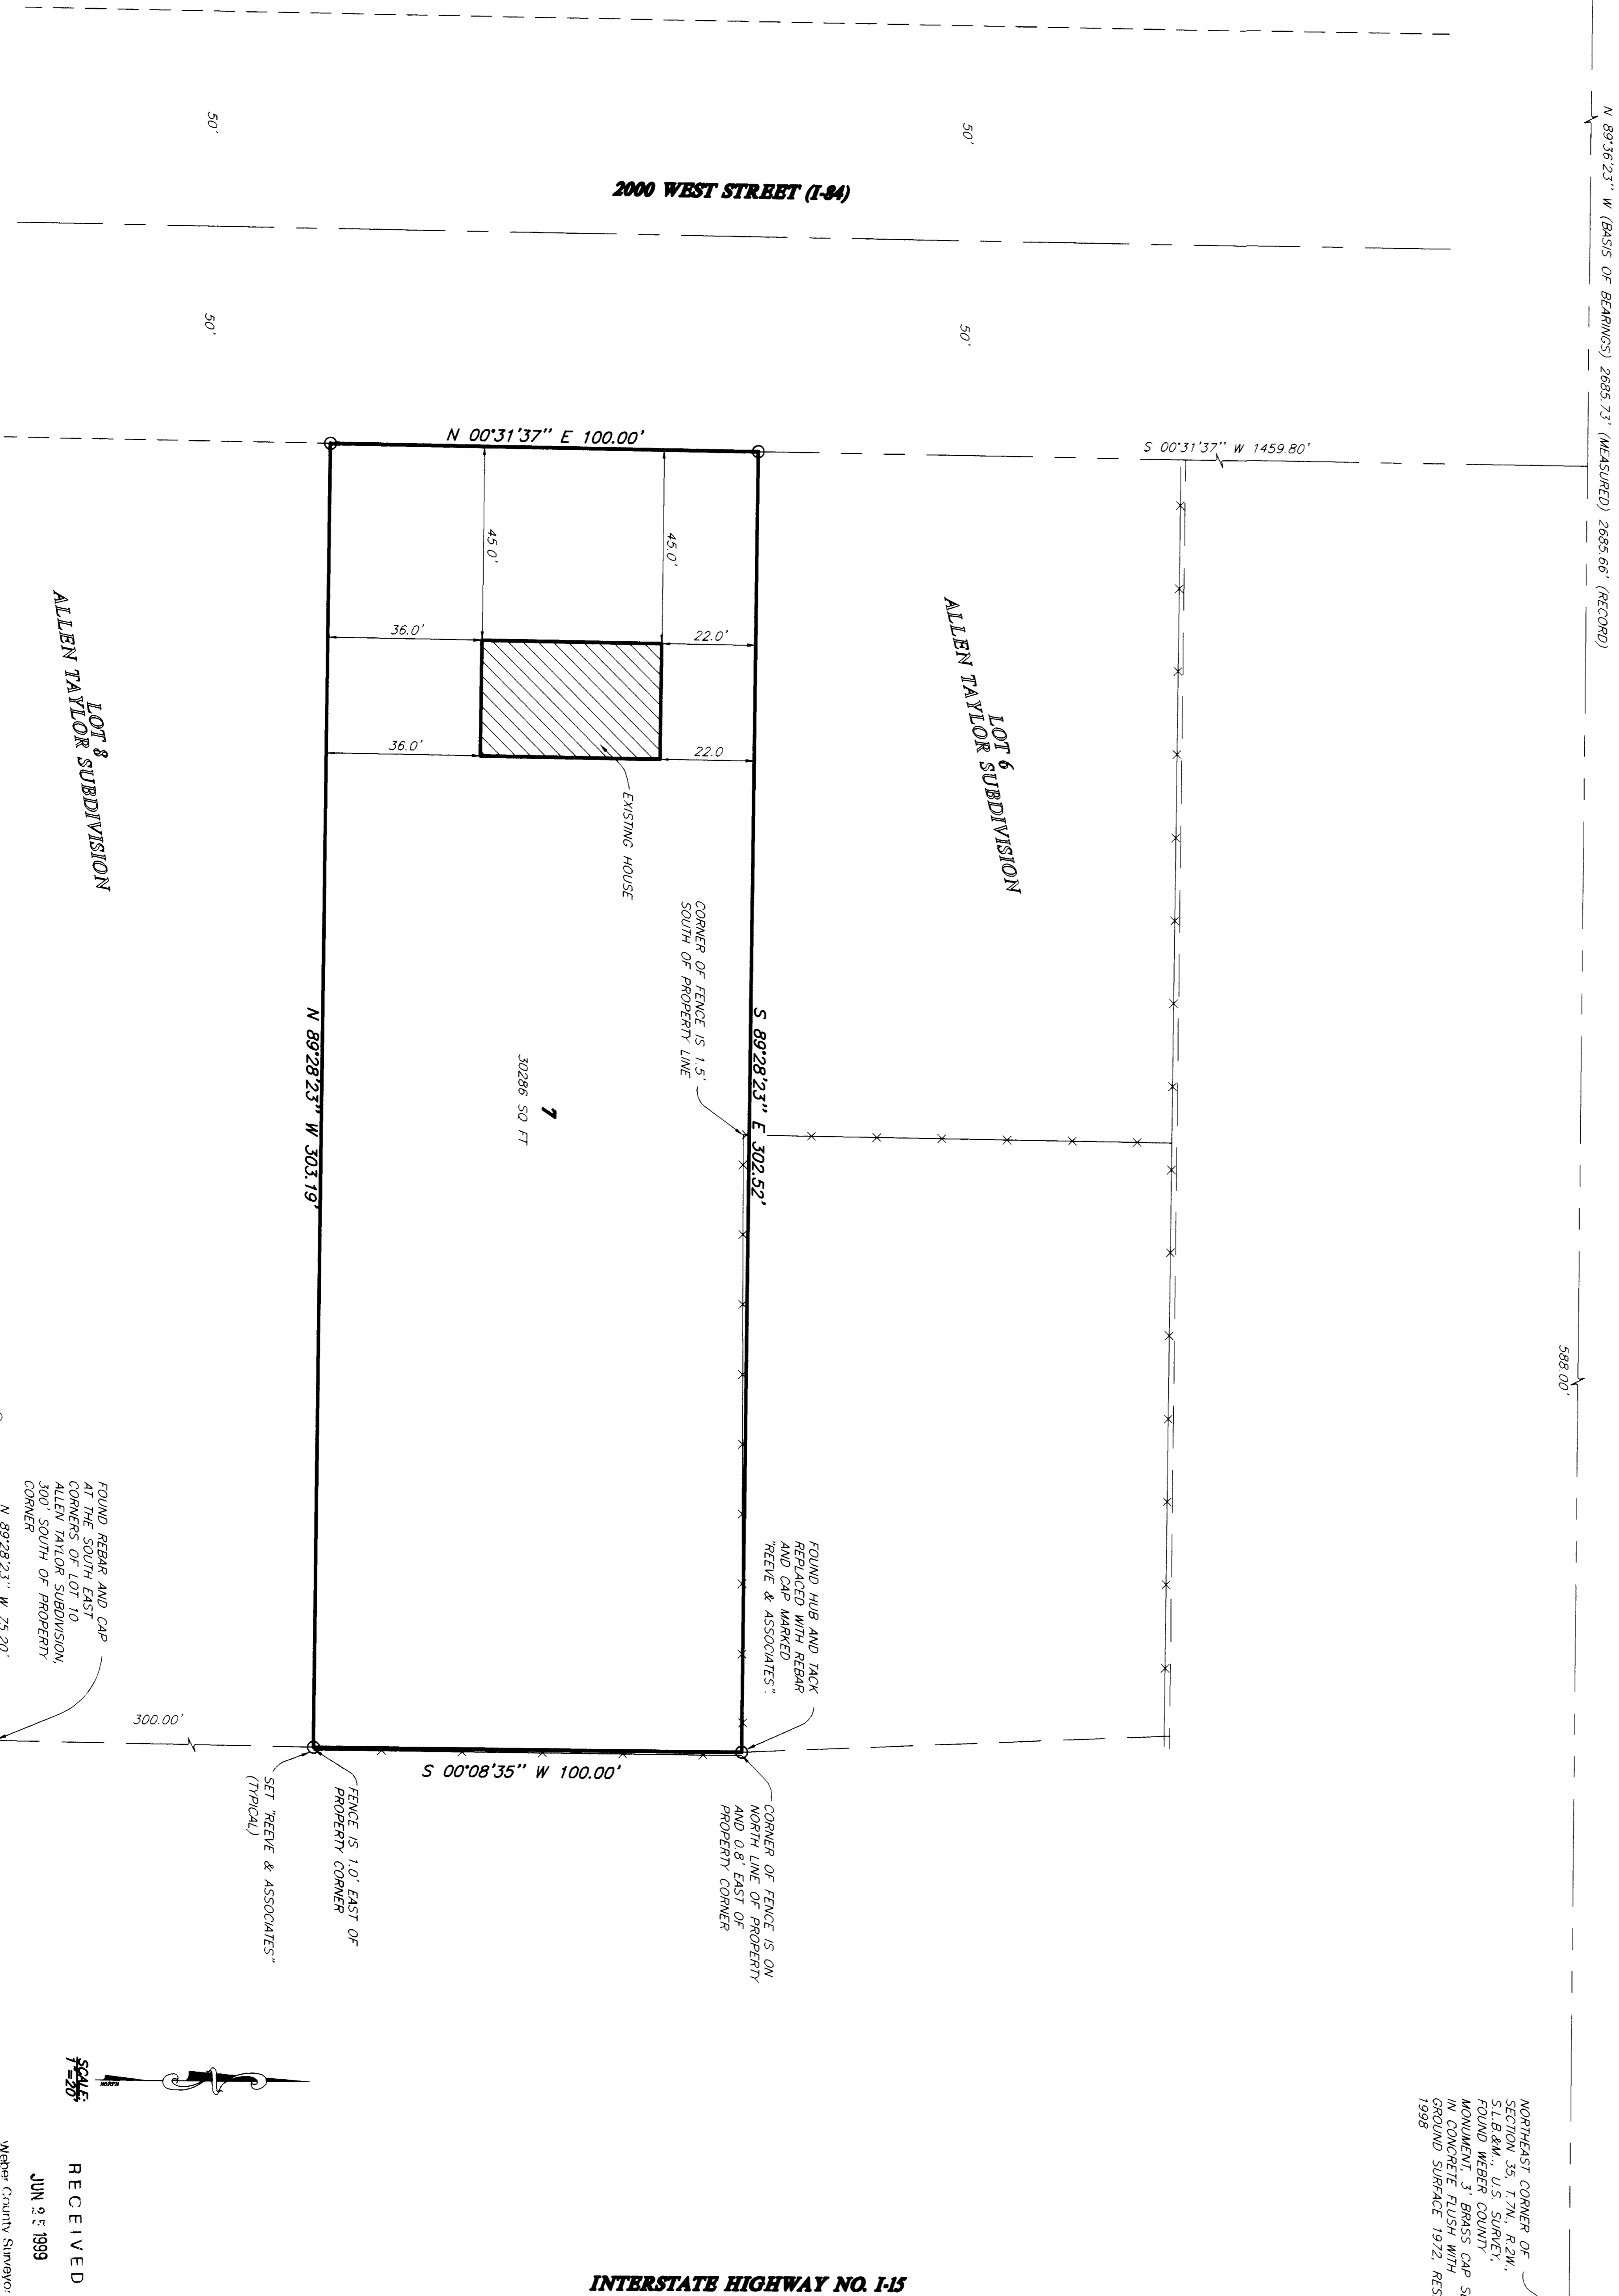

REVISIONS

1.		4
2.		5
3.		6

PROJECT NO. 1328-01 SURVEYOR: R. WILFORD  
DATE: 1-26-98 DRAFTER: A. BUNN  
PROJECT MANAGER: J. SUTHERLAND

**REEVE & ASSOCIATES, INC.**  
ENGINEERS PLANNERS & SURVEYORS  

**RECORD OF SURVEY**

**GLASSMAN PROPERTY**  

SHEET 1 OF 1 SHEETS

RECEIVED  
JUN 23 1999  
WEBER COUNTY SHREVOE