

1.	REVISIONS
2.	
3.	
4.	
5.	
6.	




RECORD OF SURVEY

LINDSAY PROPERTY
PART OF THE SOUTHWEST QUARTER SECTION 7, TOWNSHIP 6 NORTH, RANGE 2 EAST, S.L.B.M., U.S. SURVEY
APRIL 2, 1989

SHEET	1
SHEETS	1

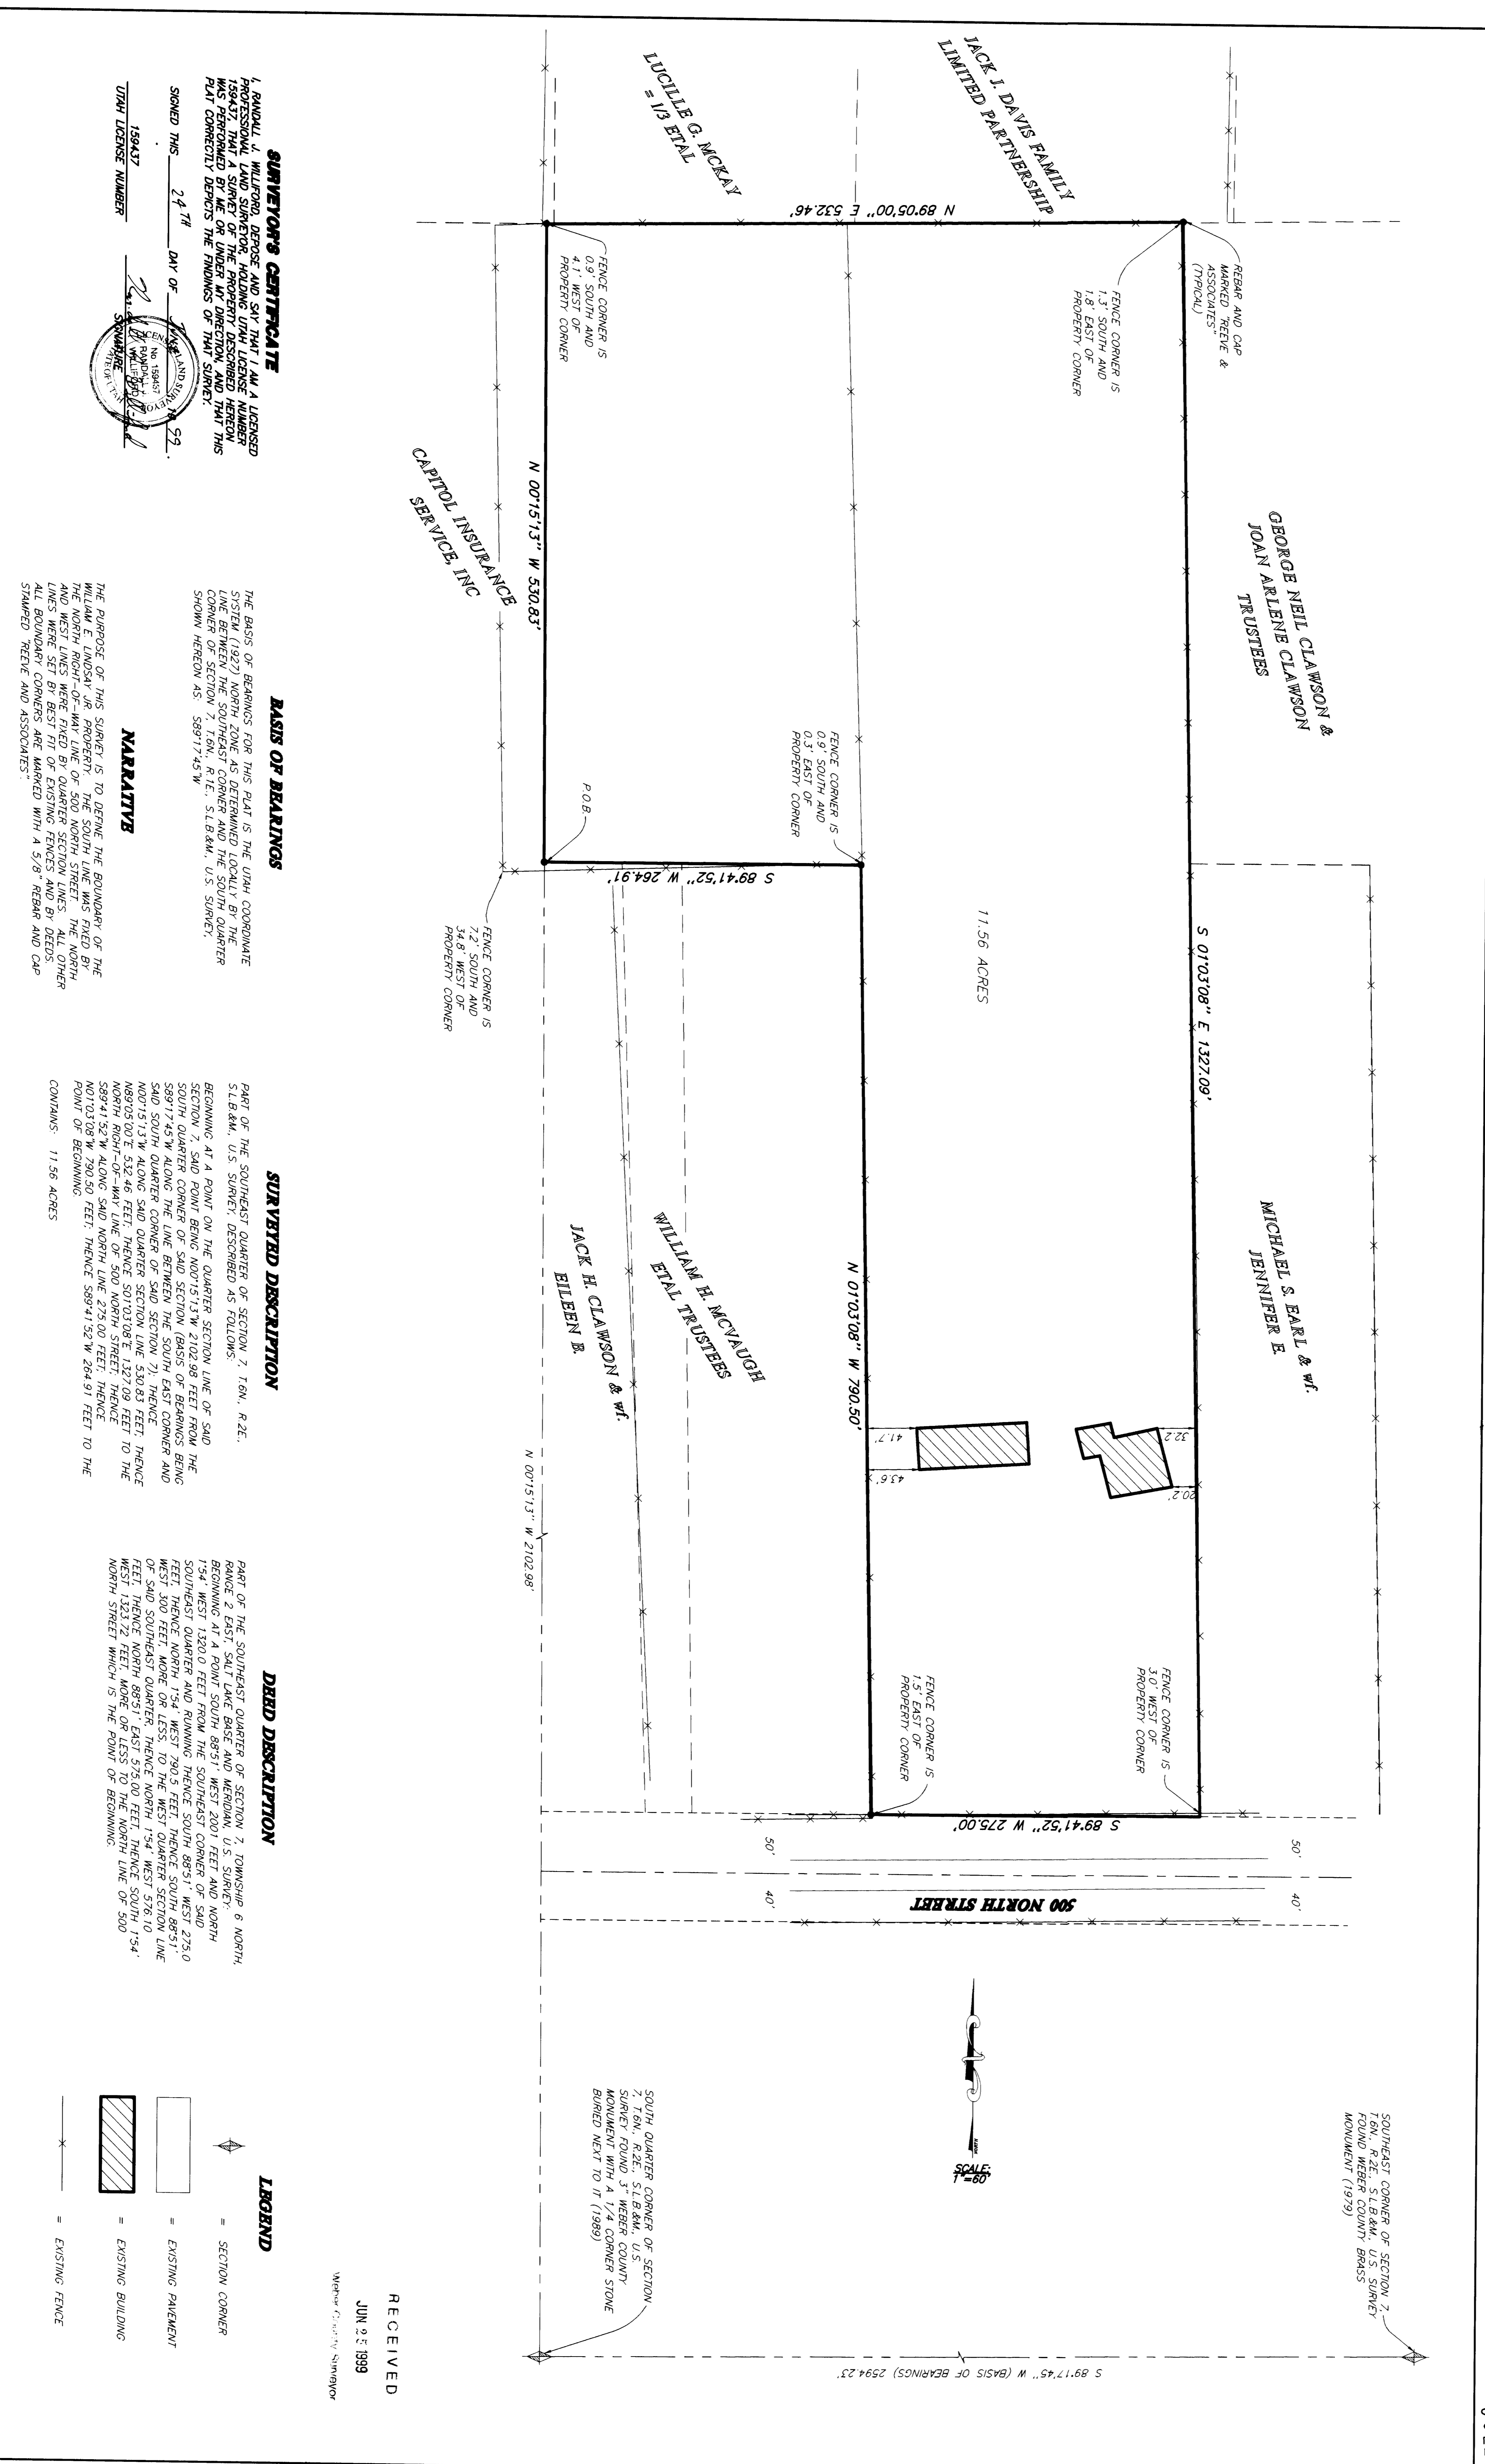

SURVEYOR'S CERTIFICATE
R. WILFORD
REGISTERED PROFESSIONAL LAND SURVEYOR
UTAH LICENSE NUMBER

BASIS OF BEARINGS

NARRATIVE

SURVEYED DESCRIPTION

CONTAINS 11.56 ACRES.

DEED DESCRIPTION


LEGEND

- SECTION CORNER
- EXISTING PAVEMENT
- EXISTING BUILDING
- EXISTING FENCE

RECEIVED
JUN 25 1999

