

DRAWING NUMBER  
**002269**

PLAN HOLD CORPORATION • IRVINE, CALIFORNIA  
RECORDED BY NUMBER 57541

DRAWING NUMBER  
**002269**

PLAN HOLD CORPORATION • IRVINE, CALIFORNIA  
RECORDED BY NUMBER 57541

C:\DRAWINGS\SHARED\0551\01-WAY\1\SURVEY.DWG Wed Jun 23 10:20:54 1999 H.Gurn

REVISIONS
1
2
3
4
5
6


PROJECT NO. **3831-01** SURVEYOR **R. M. WILSON**  
 DATE **5-21-99** DRAWN **K. GUN**  
 SCALE **1"=40'** CHECKED

**REEVE & ASSOCIATES, INC.**  
 ENGINEERS PLANNERS & SURVEYORS  


**RECORD OF SURVEY**

**WAYMENT PROPERTY**  

SHEET **1** OF **1** SHEETS

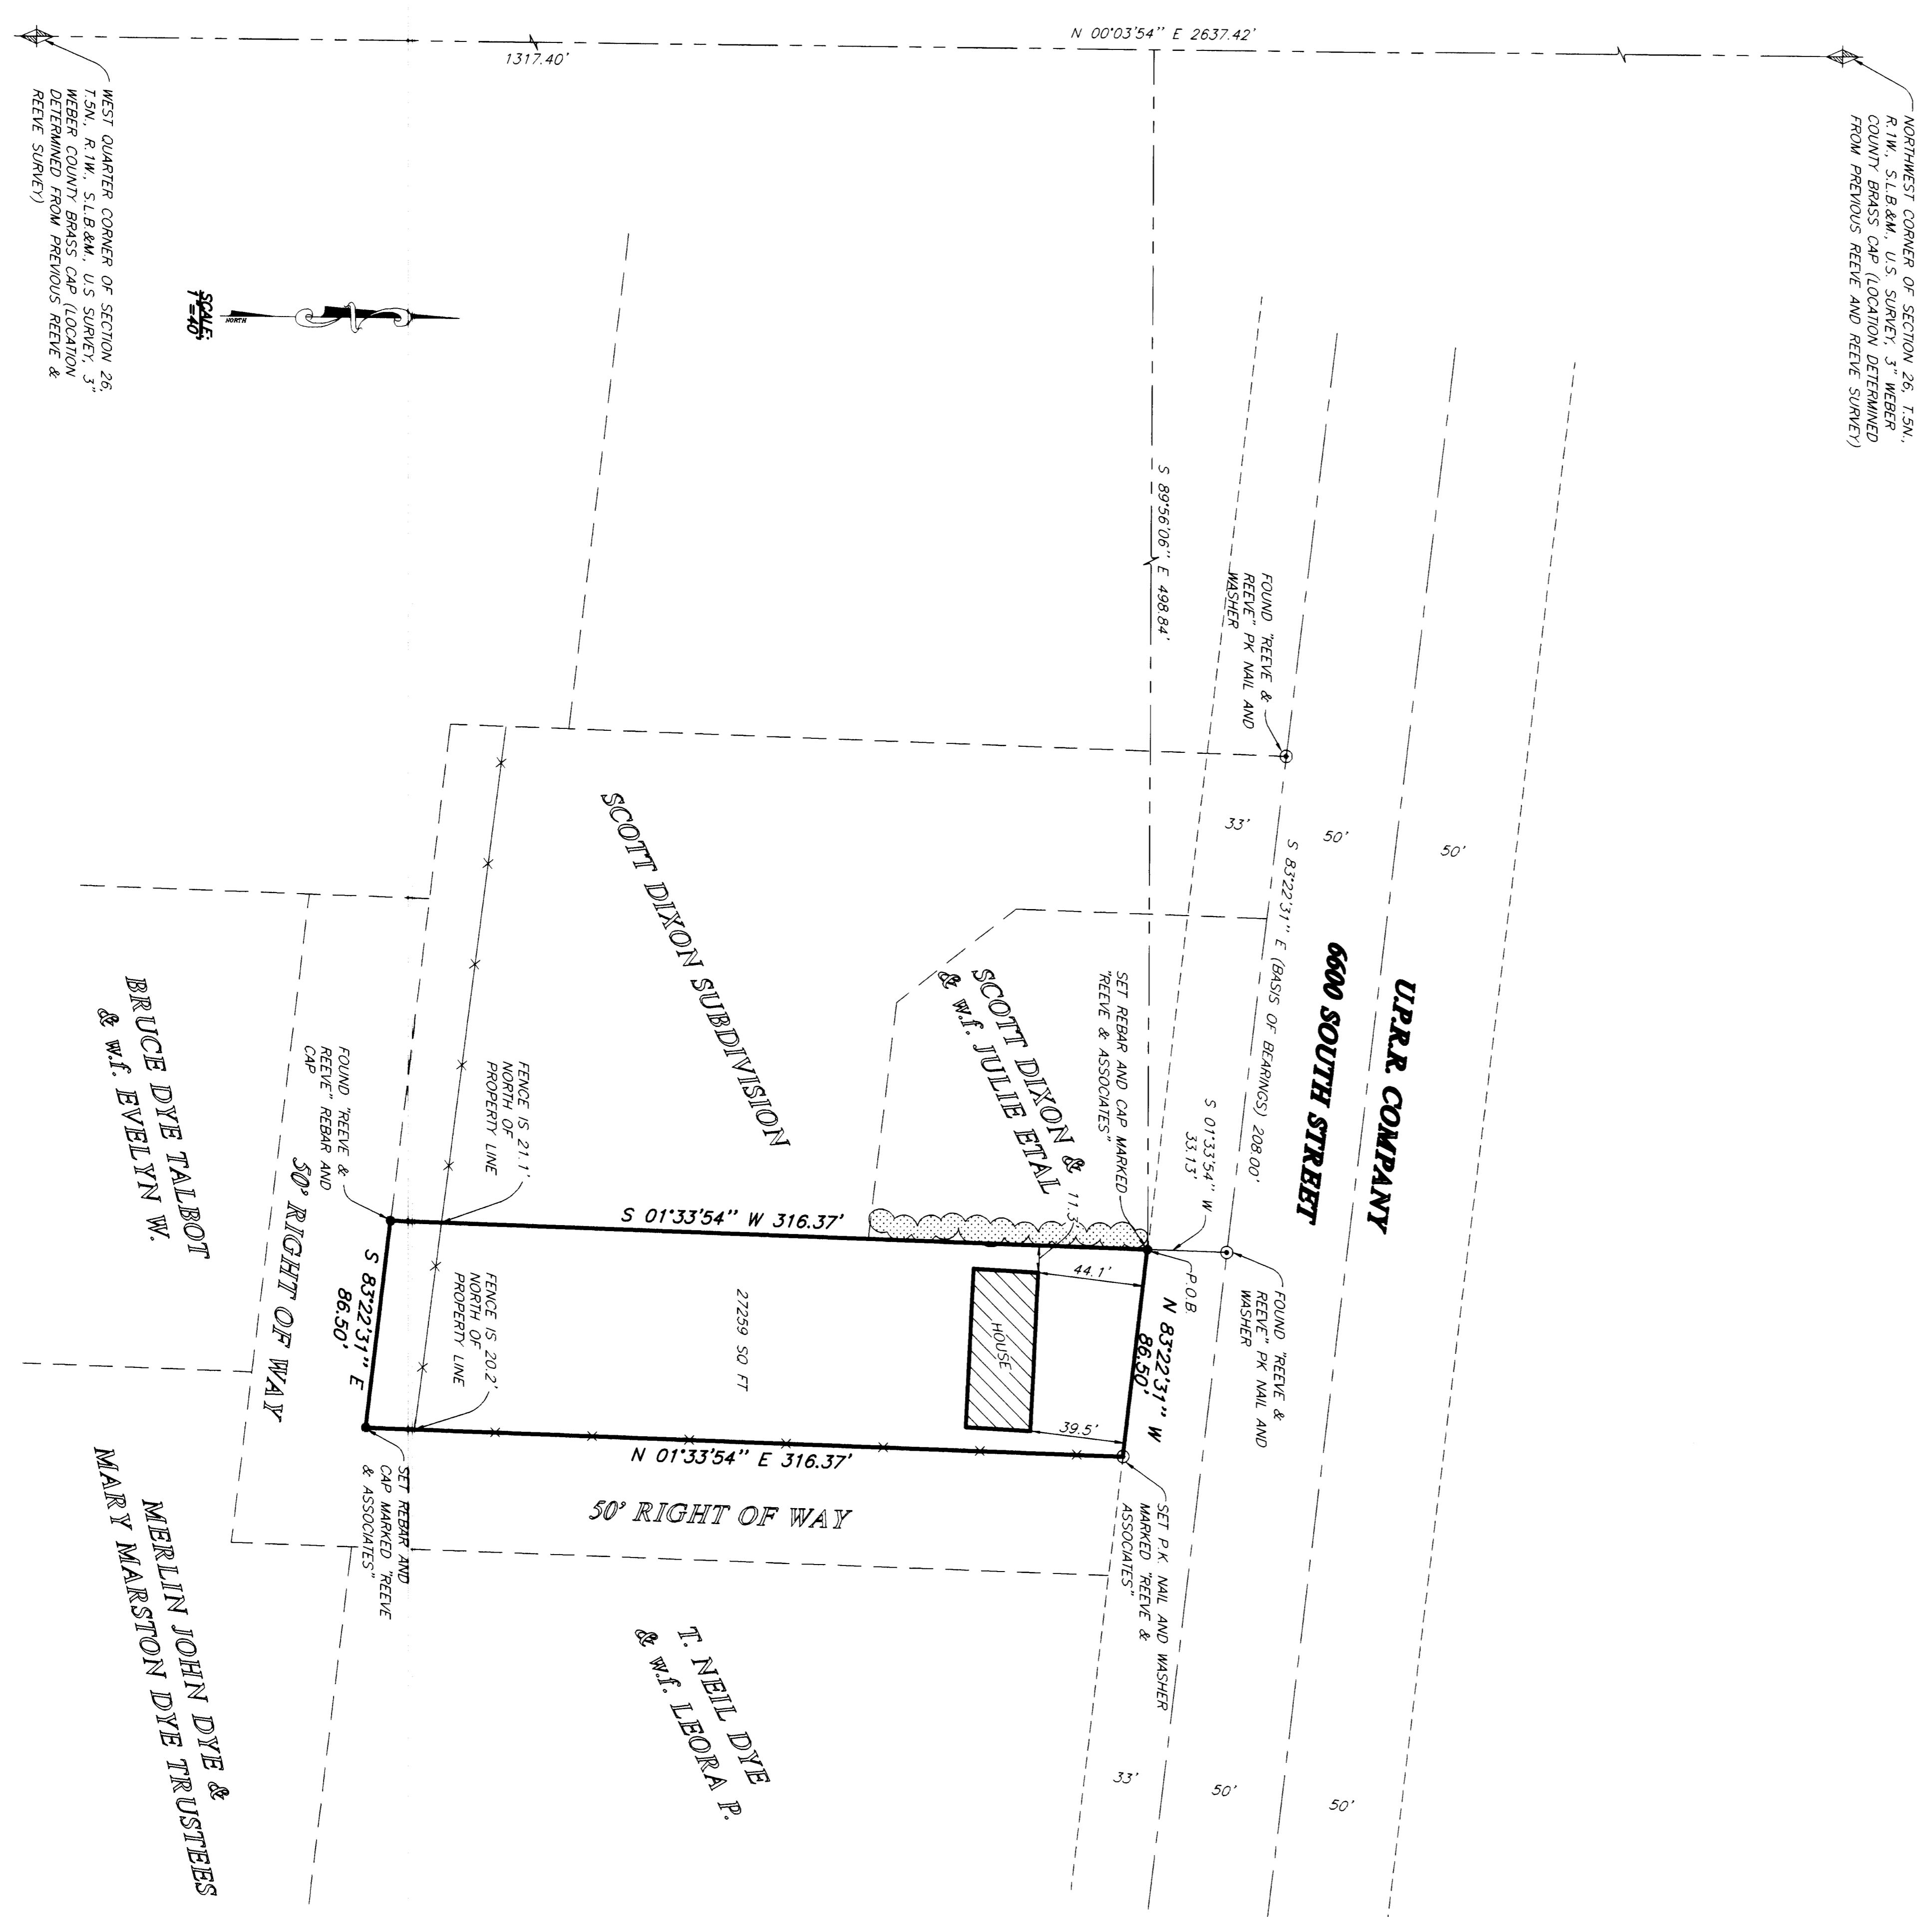

RECEIVED  
 JUL 07 1999  
 WILSON & ASSOCIATES

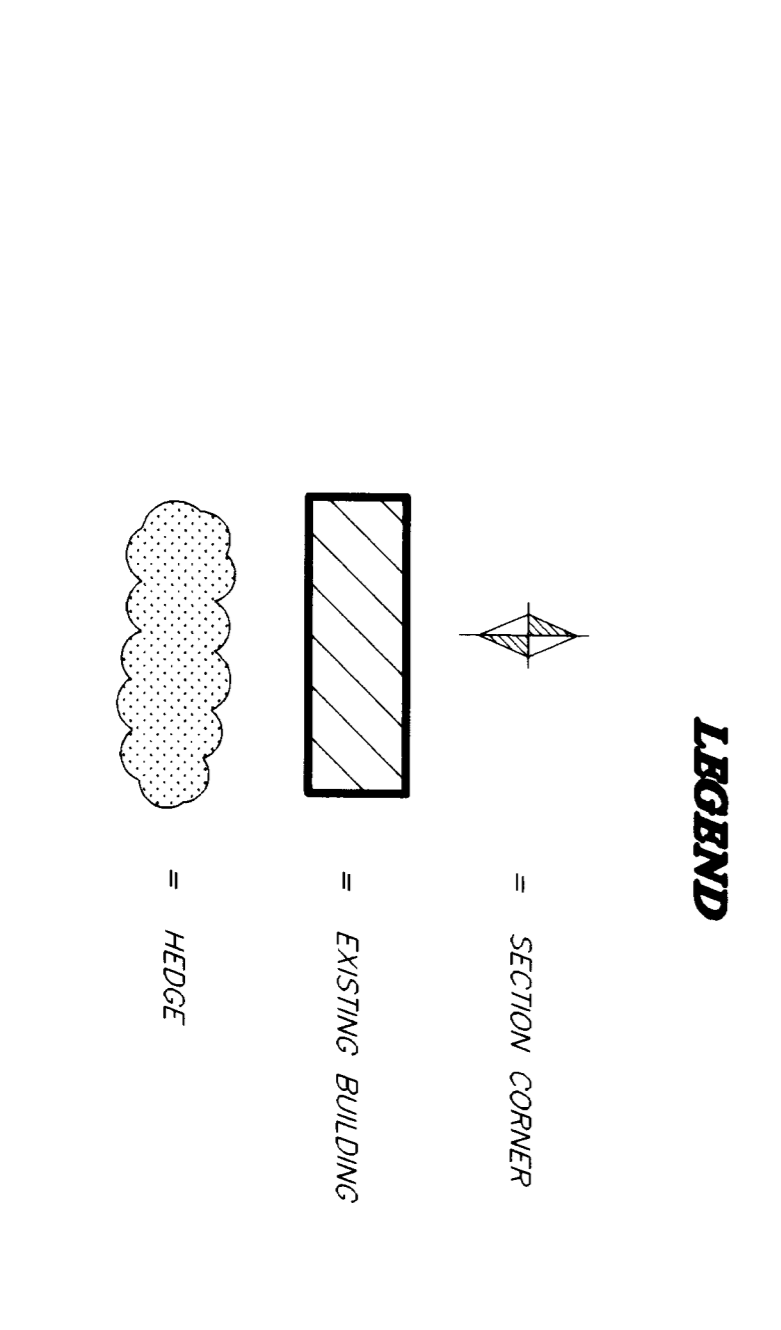

**DEED DESCRIPTION**

A PART OF THE NORTHWEST QUARTER OF SECTION 26, TOWNSHIP 5 NORTH, RANGE 1 WEST, SALT LAKE MERIDIAN, U.S. SURVEY, BEGINNING AT A POINT ON THE SOUTH LINE OF RAILROAD RIGHT OF WAY, 316.37 FEET NORTH AND 316.

CONTAINS: 27299 SQUARE FEET

**SURVEYED DESCRIPTION**


BEGINNING AT AN INTERSECTION OF THE EXTENSION OF THE WEST LINE OF THE SCOTT DIXON SUBDIVISION AND THE SOUTH LINE OF THE SCOTT DIXON SUBDIVISION, SAID POINT BEING 501°13'54" W 313 FEET FROM THE FOUND BEARS' PK MARK AND WASHER IN THE CENTERLINE OF SAID STREET, SAID INTERSECTION ALSO BEING N00°03'54" E ALONG THE SECTION LINE 1317.

**NARRATIVE**

THE PURPOSE OF THIS SURVEY IS TO DEFINE THE BOUNDARY OF THE BRUCE DYE TALBOT PROPERTY. THE NORTH LINE WAS FIXED BY THE SCOTT DIXON SUBDIVISION SURVEY AND THE SOUTH LINE WAS FIXED BY THE SCOTT DIXON SUBDIVISION, WHICH WAS SET BY FOUND BEARS' & BEARS' PK MARKS AND WASHERS. THE SOUTH AND EAST LINES WERE SET BY DEED.

**BASIS OF BEARINGS**

THE BASIS OF BEARINGS FOR THIS PLAT IS THE LINE BETWEEN THE TWO BEARS' & BEARS' PK MARKS AND WASHERS FROM A PREVIOUS REEVE & ASSOCIATES SURVEY OF THE SCOTT DIXON PROPERTY, SHOWN HEREON AS S83°22'31" E.

**SURVEYOR'S CERTIFICATE**


SIGNED THIS 24<sup>TH</sup> DAY OF JULY 1999

158427  
 RANDALL J. WILSON  

002269